

Report 1 - Groundwater Monitoring Network for CCR Compliance

Public Service Company of Oklahoma
Northeastern Station 3&4
Non-Hazardous Industrial Waste (NHIW) Landfill
Permit No. FA3566010

October 2017
Project No. 35157123



**PUBLIC SERVICE
COMPANY OF
OKLAHOMASM**

A unit of American Electric Power

Prepared for:
American Electric Power
1 Riverside Plaza
Columbus, OH 43215

Prepared by:
Terracon Consultants, Inc.
25809 Interstate 30 South
Bryant, Arkansas 72022
(501) 847-9292

terracon.com

Terracon

Table of Contents

1.0 OBJECTIVE	1
2.0 BACKGROUND INFORMATION.....	1
2.1 FACILITY LOCATION DESCRIPTION	1
2.2 DESCRIPTION OF CCR UNIT	1
2.2.1 <i>Embankment Configuration</i>	1
2.2.2 <i>Area/Volume</i>	2
2.2.3 <i>Construction and Operational History</i>	2
2.2.4 <i>Surface Water Control</i>	2
2.3 PREVIOUS INVESTIGATIONS	3
2.4 HYDROGEOLOGIC SETTING.....	3
2.4.1 <i>Climate</i>	3
2.4.2 <i>Regional and Local Geologic Setting</i>	4
2.4.3 <i>Surface Water/Groundwater Interactions</i>	5
2.4.4 <i>Water Users</i>	6
3.0 CERTIFIED GROUNDWATER MONITORING NETWORK.....	6
3.1 HYDROSTRATIGRAPHIC UNITS.....	6
3.1.1 <i>Horizontal and Vertical Position Relative to CCR Unit</i>	6
3.1.2 <i>Overall Flow Conditions</i>	7
3.2 UPPERMOST AQUIFER	8
3.2.1 <i>CCR Rule Definition</i>	8
3.2.2 <i>Identified Onsite Hydrostratigraphic Unit</i>	8
3.3 REVIEW OF EXISTING MONITORING NETWORK	8
3.3.1 <i>Overview</i>	8
3.3.2 <i>Gaps in the Monitoring Well Network</i>	9
3.3.3 <i>Recommended Monitoring Well Network</i>	10
4.0 CERTIFICATION.....	11
4.1 LIMITATIONS.....	11
4.2 PE CERTIFICATION	11
BIBLIOGRAPHY	12

Figures

1. Site Location Map
2. Plant and CCR Unit Location Map
3. CCR Unit Layout and Well Locations
4. Cross Section Location Map
5. Cross Section(s)
6. Potentiometric Surface Map – Uppermost Aquifer
7. Nearest Water Well from CCR Unit Location Map

List of Tables

1. Well Level Data
2. Well Construction Details

Appendix

1. Boring & Monitoring Well Installation Logs
2. Geologic Cross Sections
3. Geophysical Log Plots

1.0 Objective

The purpose of this Groundwater Monitoring Network Report (GWMNR) is to demonstrate adequacy and compliance of the existing monitoring well network with EPA Coal Combustion Residuals (CCR) regulations (40 CFR 257) and with ODEQ's (Oklahoma Department of Environmental Quality) CCR rule OAC 252.517 at the Public Service Company of Oklahoma –Northeastern Stations 3 & 4 Ash Landfill (Permit No. 3566010). The Public Service of Oklahoma is a unit of American Electric Power (AEP).

2.0 Background Information

2.1 Facility Location Description

The Northeastern Power Station facility is located at the junction of U.S. Highway 169 and Oklahoma Highway 88 approximately 1 mile south of Oologah, Rogers County, Oklahoma. The facility property consists of approximately 1230 acres located in Sections 3 and 4, Township 22 North, Range 15 East, and Sections 33 and 34, Township 23 North, Range 15 East (I.M.) in Rogers County, Oklahoma. Four (4) electric generating Units are present at the facility. Units 1&2 are gas fired while Units 3&4 are coal fired units. Unit 4 ceased operation in April of 2016. A site location map and plant and CCR unit location map showing the general location of the landfill is presented in **FIGURES 1 & 2**.

2.2 Description of CCR Unit

2.2.1 Embankment Configuration

Based on the 1970 USGS topographic map (**FIGURE 1**) it appears the landfill was constructed in an area where gravel pit mining or limestone quarrying operations took place. Portions of the upper limestone rock appear to have been removed, primarily within the western portion of the landfill. A dike structure defining the south edge of the disposal facility was built as a part of initial plant construction. This dike was built to an elevation of 610 feet MSL having a crest width of 10 to 12 feet and 3:1 side slopes (**Volume 1 Major Mod 2011 Terracon Project No. 35107130**)¹. The dike acted as a barrier between the disposal area and the Verdigris River. An additional construction event raised the dike to the current crest elevations of greater than 630 feet MSL, with a crest width of about 25 feet. Side-slopes of the dike, running down to the river basin, are on the order of 30 degrees from horizontal and consist of red-brown clay with limestone gravel mixed with varying amounts of ash material and larger rock. Limestone with some thin shale beds, followed by shale, underlies the constructed dike. The facility previously installed a slurry wall and grout curtain on the southeast side of the landfill within the constructed dike (**FIGURE 3**). The landfill embankments are constructed with 3:1 interior slopes. The outside embankment slopes vary from approximately 2.5:1 to 4:1 (**AEP, “Ash Landfill Modification – Construction Drawings”, Northeastern Plant, Dated September 2014**)².

2.2.2 Area/Volume

The current Northeastern Ash Landfill site consists of approximately 44 acres located in the southeastern portion of the property and adjacent to the Verdigris River. The total landfill capacity for disposal is 2.463 MCY.

2.2.3 Construction and Operational History

The Ash Landfill is an existing landfill that was permitted by the Oklahoma State Department of Health in March 1978. The landfill permit has subsequently been modified and re-issued through the Oklahoma Department of Environmental Quality. The landfill currently operates in accordance with Permit No. 3566010. The landfill is located in an area that historically has been quarried. The facility has utilized this quarried depression to dispose of CCR. Currently CCR from Unit 3 is disposed of in the landfill as Unit 4 has been shut down. In 2012-2013, a landfill improvement project was completed which resulted in the construction of a 3 ft wide by 25 ft deep 2200-foot-long slurry wall followed by a 1400-foot-long grout curtain. The construction of the slurry wall involved excavating out 25 feet of overburden and keying into 0.5-1 foot of the limestone unit. The grout curtain involved the injection of bentonite to elevations of 590-595 ft amsl. As a result, this project created an imperious bentonite slurry wall/grout curtain from ground surface to depth of 590- 600 ft amsl along the southern edge of the landfill. (**Hydrogeologic Summary Report, Terracon, March 2017**)³ This barrier system effectively prevents groundwater to flow out of the landfill. Additionally, a geosynthetic intermediate liner and a leachate collection system have been installed above existing waste in the landfill. The elevation of the liner system slopes downward from west to east (towards the leachate collection pond) from approximately 645 ft to 615 ft in elevation.

2.2.4 Surface Water Control

OAC 252:515-17 establishes standards and requirements for the management of stormwater associated CCR landfills which address the management and control of run-on and run-off stormwater derived from a 24-hour, 25-year storm event.

The Landfill perimeter ditches are generally sloped to drain to the northeast portion of the Landfill to Basin C. These perimeter ditches convey the stormwater to Basin C prior to impacting the waste disposal area. Contact stormwater is managed as part of the facility OPDES program. As designed, the run-on and run-off control systems are capable of managing and controlling a 24-hour, 25-year storm event. Stormwater discharges associated with the landfill will be managed as part of the facility OPDES program (**Volume 3 Major Mod 2011 Terracon Project No. 35107130**)⁴.

2.3 Previous Investigations

Geotechnical

- § 2004 – Terracon Project No. 040445147

Groundwater and Other Environmental

- § 2008 – Terracon Project No. 35077150
- § 2009 – Terracon Project No. 35107130

2.4 Hydrogeologic Setting

Groundwater encountered in bedrock in this region occurs in secondary openings, such as joints, fractures, and solution cavities. Groundwater occurs in most of the geologic units in the region; however, many of the units do not yield significant amounts of water.

Groundwater yields from the Oologah Formation, Labette Formation, and Fort Scott Limestone are small. The average yield of wells in the Pennsylvanian and Mississippian Age rocks is estimated to be 0.5 gallons per minute (Marcher, 1971). A review of the Oklahoma Geological Survey Hydrologic Atlas map titled *Maps Showing Principal Groundwater Resources and Recharge Areas in Oklahoma (Sheet 2 - Bedrock Aquifers and Recharge Areas, 1988)* indicates that the site is not located within a principal bedrock aquifer or recharge area.

The largest yields are found in unconsolidated material along streams and rivers. Alluvium along the lower portion of the Verdigris River can be utilized as a source of water and yields of up to 30 gallons per minute have been reported (Marcher, 1971), (**Well Install Report 2011, Terracon**)⁵.

2.4.1 Climate

Oologah receives an average of 42 inches of rainfall annually. The average temperature annually ranges from 35°F to 85°F (<http://www.city-data.com/city/Oologah-Oklahoma.html>)⁶.

2.4.2 Regional and Local Geologic Setting

Soils

According to the USDA Soil Survey of Rogers County, Oklahoma (July, 2007), the two predominant soils in the vicinity of the landfill are the Hector-Endshaw complex (Rs) and Claremore silt loam (CmB). The Shidler stony silty clay loam (So) and Verdigris silty clay loam (Vf) are also present near the landfill but to a lesser extent. A majority of the soils in the vicinity of the landfill have been altered or removed during site development.

The Claremore consists of a reddish brown silty clay loam approximately 19 to 24 inches thick and is underlain by bedrock. The Claremore is well drained with a low to moderately low water capacity.

The Hector-Endshaw consists of a gravelly fine sandy loam approximately 15 to 25 inches thick and is underlain by bedrock. The Hector-Endshaw is well drained with a very low to moderately high water capacity.

The landfill is located in an area underlain by the Pennsylvanian Age Oologah Formation, which is the major geologic formation outcropping in this area. Although some Quaternary Age Alluvial deposits (consisting of sand, gravel and clay) are located along the Verdigris River, alluvial deposits were not identified within the boundary of the landfill or on PSO property within the reviewed reports.

Geology

The Oologah Formation dips gently to the northwest at 30 to 50 feet per mile (Oakes, 1952) and rests conformably on the Labette Shale. The Oologah Formation consists of marine limestones and shales and is divided into three distinct members :(1) Altamont Limestone (upper), (2) Bandera Shale (middle), and (3) Pawnee Limestone (lower).

The Altamont Limestone is comprised of a carbonate marine limestone deposited on a broad offshore platform. The Altamont consists of light gray to dark gray limestone, moderately fossiliferous, and massive to thin-bedded. The Altamont Limestone is not present at this site.

The Bandera Shale was deposited during a major fluctuation in sea level which caused an influx of mud to be deposited on the normally non-turbid offshore platform. The middle shaly zone is typically only a few feet thick in the latitude of this region, but is thicker southward reaching a maximum thickness of 15 to 20 feet. The Bandera consists of gray to black shale, all more or less calcareous in fresh exposures. The Bandera is an aquitard that can produce temporary perched water table conditions within the overlying Altamont under certain conditions. The Bandera Shale is not present at this site.

The Pawnee Limestone is similar to the Altamont in composition and depositional environment. The formation consists of light gray to dark gray limestone, moderately fossiliferous and somewhat cherty with some thin beds of shale. According to the original landfill permit (Oklahoma State Department of Health - August 3, 1978), the Oologah Formation within the disposal area is represented by the lower Pawnee Limestone member. The Oologah Limestone rests conformably on the Labette shale.

The Labette Shale was deposited as muds on an offshore bank. The formation consists of clay shale and silty to sandy shale with some thin beds of sandstone and limestone. In this region, the Labette is 180 to 250 feet thick (Oakes, 1952) and rests conformably upon the Pennsylvanian Age Fort Scott Limestone. (**Volume 2 Major Mod 2011 Terracon Project No. 35107130**)⁷

Local Geologic Setting

The 1970 USGS topographic map (**FIGURE 1**) shows the area where the landfill is located prior to its inception. Cross-section A-A' (**APPENDIX 2, SHEET 2**) illustrates that the top of the limestone unit follows the local topographic surface, which has an approximate elevation of 640 ft amsl northwest of the landfill. The area where the landfill has been constructed the top of limestone ranged from 630-590 ft amsl. In two locations, where the limestone dips down to approximately 610-590 ft amsl on the southeast side of the landfill, there are 2 apparent surface water flow channels that extend to the edge of the embankment and include the location of the southeastern berm of the landfill, as seen on Figure 1. Additionally, the limestone unit is absent in various locations on the southern border of the landfill (cross-section C-C', **APPENDIX 2, SHEET 2**). This variation in the limestone unit from north to south and the lack of the limestone unit in this area is to be expected since the area was historically quarried before the **FIGURE 1** USGS topo map was prepared.

Cross-section A-A' (**APPENDIX 2, SHEET 2**) also shows the top of the shale unit rising from an elevation of approximately 583 ft amsl northwest of the landfill to an approximately elevation of 600 ft amsl southeast of the landfill, conforming to the bottom of the limestone unit. As shown on cross-section D-D' (**APPENDIX 2, SHEET 3**) the shale unit is encountered at approximately 598-605 ft amsl along the southern western edge of the landfill and then dips to approximately 583 ft amsl along the southern eastern edge of the landfill. The bottom of the shale unit has not been determined during monitoring well installation borings. Literature estimates its thickness at 180 to 250 ft.

2.4.3 Surface Water/Groundwater Interactions

The Verdigris River is adjacent to the southeast property boundary of the landfill and maintains an approximate river elevation of 542 ft amsl. River flow is controlled by the Oologah Dam (Corps of Engineers – U.S. Army) located approximately 1 mile north and east of the site. Based on the

groundwater potentiometric data collected in the shale aquifer unit, the average groundwater elevation is 585 ft amsl.

Currently not enough data has been collected to determine if there is surface to groundwater communication.

2.4.4 Water Users

According to the Oklahoma Water Resources Board map, there are no known groundwater wells within a 1 mile of the site. There is a well located approximately 2 miles from the site which has been plugged (**FIGURE 7**).

3.0 Certified Groundwater Monitoring Network

The existing monitoring well network present at the Site was evaluated to determine if any of the wells were viable for continued use as part of the groundwater monitoring well network or also retained as part of a larger groundwater hydraulic monitoring well network. The hydrogeologic conditions were also identified and evaluated to determine if the uppermost aquifer unit has an effective well network. The evaluation was completed in accordance with 40 CFR 257.91 and OAC 252:517-9-2 in establishing a monitoring well network that effectively monitors the uppermost aquifer with a downgradient monitoring system at the waste boundary that ensures detection of groundwater contamination in the uppermost aquifer.

3.1 Hydrostratigraphic Units

Hydrostratigraphic units comprise geologic units grouped together on the basis of similar hydraulic conductivity. Slug testing conducted in the limestone unit exhibits an average hydraulic conductivity of 1.87×10^{-3} cm/sec. Slug tests conducted in the shale unit exhibit an average hydraulic conductivity of 2.52×10^{-6} cm/sec (Terracon Project No. 35077150). This indicates that these units are different units. This has also been confirmed by the geophysical logging of the units (**APPENDIX 3**). Additionally, during the hydrogeological investigations at the site, little to no water was encountered within either of these units.

3.1.1 Horizontal and Vertical Position Relative to CCR Unit

Geologic data from soil borings collected at the site indicate that the first geological unit encountered is a limestone unit. However, quarrying of the limestone before the construction of the power plant has extensively removed this unit within the current footprint of the landfill. The thicknesses of the limestone unit beneath the landfill range from 10 feet to 0 feet. In the eastern, unquarried area of the landfill footprint, the limestone thickness is approximately 20 feet thick. Below the limestone unit, the top of the shale unit is encountered which conforms to the bottom

of the limestone unit. The full depth of the shale unit was not determined during monitoring well installation borings. Literature estimates its thickness at 180 ft to 250 ft.

Extensive geologic cross-sections of the Landfill area are shown in **APPENDIX 2**. The base of the landfill was determined to be at an approximate elevation of 610 ft amsl. However, the limestone unit is discontinuous along the southern edge of the landfill as seen in cross-section D-D'. This is to be expected from this quarried area. In these discontinuous areas, there are outcroppings of the shale unit.

3.1.2 Overall Flow Conditions

The average potentiometric elevation of the limestone unit is 613 ft amsl and for the shale unit it is 583 ft amsl. The potentiometric surface elevations in MWs 5D, 6D, 7D and 12D (which have screen intervals set within the shale unit) coincide with the potentiometric surface elevation in the limestone unit in the vicinity of their locations. In **FIGURE 1**, two low areas at 590 ft amsl are depicted along the southern edge of the landfill in the vicinity of MW-6D. These low areas appear to be influencing the potentiometric surface elevation (an average of 600 ft amsl) in that area and appear to serve as a localized recharge area, as seen on the neutron log. The neutron log data collected in MWs 5D and 7D, as displayed on cross-sections C-C' and B-B' (**APPENDIX 2**), respectively, show higher formation porosity in the shale unit than in the limestone unit. Therefore, the limestone in these areas could be serving as a semi-confining unit. This scenario may also exist around MW-12D located approximately 400 feet south of MW-5D. Therefore, these wells are not used to determine the general groundwater flow direction within the shale unit.

MW-8D is located northwest of the landfill and the potentiometric surface in MW-8D varies seasonally. The seasonal high for MW-8D is approximately 606 ft amsl, with a seasonal low of 567 ft amsl. MW-3D and 9D are located on the southern edge of the landfill (>2000 ft from MW-8D) and their potentiometric surfaces experience very little seasonal fluctuation. MW-3D's maximum potentiometric surface has been approximately 595 ft amsl, with a low of 592 ft amsl. MM-9D's maximum potentiometric surface has been approximately 586 ft amsl, with a low of 579 ft amsl. Therefore, predominate groundwater flow direction is considered to be from the northwest towards the southeast.

Available groundwater elevations are summarized in **TABLE 1**. There appears to be seasonal and temporal fluctuations in the groundwater flow. The most recent comprehensive groundwater data set from March 2017 is depicted on **FIGURE 6**. The general flow direction in the shale units for this particular sampling date shows a west-southwest flow direction from MW-3D.

The estimated linear groundwater velocity through the shale unit at the site is reported to be 1.57×10^{-6} cm/sec (0.53 in/day). Pump tests completed on the shale unit indicated a yield of less than 150 gallons per day.

3.2 Uppermost Aquifer

3.2.1 CCR Rule Definition

“Aquifer” means a geologic formation, group of formations or portion of a formation capable of yielding usable quantities of groundwater to wells or springs.

“Uppermost Aquifer” means the geologic formation nearest the natural ground surface that is an aquifer, as well as lower aquifers that are hydraulically interconnected with this aquifer within the facility’s property boundary. Upper limit is measured at a point nearest to the natural ground surface to which the aquifer rises during the wet season.

Common Definitions:

“Aquifer” is a geologic formation(s) that is water bearing. A geological formation or structure that stores and/or transmits water, such as to wells and springs. Use of the term is usually restricted to those water-bearing formations capable of yielding water in sufficient quantity to constitute a usable supply for people’s uses. (USGS, Water Science Glossary of Terms)

3.2.2 Identified Onsite Hydrostratigraphic Unit

As shown in cross-section D-D’ (**APPENDIX 2**) the limestone unit along the southern edge of the landfill is only present east of MW-6D. Additionally, the bentonite slurry wall/grout curtain along the southern edge of the landfill (**FIGURE 3**) has established an impervious wall preventing groundwater flow in the limestone unit that is present in that area.

Therefore, for the purpose of specifying the uppermost aquifer, the on-site hydrostratigraphic unit in the area of the landfill is identified to be the shale unit which is first encountered at approximately 590-600 ft amsl.

3.3 Review of Existing Monitoring Network

3.3.1 Overview

Fifteen (15) monitoring wells (MWs 1D, 3D, 5D-13D, 14, 15, 16, and 17) have been fully constructed within the shale unit around the landfill. The screen interval for MW-2D intercepts both the limestone and shale units, while the sand pack for MW4-D intercepts both the limestone and shale units.

MWs 1D, 10D, 11D, 14, 16 and 17 have not produced adequate volumes of groundwater for sampling purposes since their installation, but are helpful in determining the over-all groundwater flow pattern.

MWs 7D and 8D are geo-spatially positioned such that they can provide an indication of the background groundwater quality for the landfill. MWs 6D, 9D, 3D, 15 are considered to be positioned at the waste boundary that ensures the detection of groundwater contamination in the uppermost aquifer in the downgradient direction.

A well construction table that summarizes the location, ground surface elevation, borehole depth, installation data, and associated well construction details for the proposed monitoring well network is included in **TABLE 2**.

3.3.1.1 Well Construction Summary Table

Please refer to **TABLE 2** for a summary of existing monitoring network construction details.

3.3.1.2 Depth Ranges and Hydrostratigraphic units monitored

Please refer to **TABLE 1** for a summary of water-level data from the existing monitoring network. The hydrostratigraphic unit monitored includes the Labette Shale unit.

3.3.1.3 Key Flow Directions

Based on seasonal variations, predominate groundwater flow direction is considered to be from northwest towards southeast.

3.3.1.4 Key Users/Receptors Not Protected

Currently groundwater is not being used within a one mile radius of the facility.

3.3.2 Gaps in the Monitoring Well Network

As shown on the cross-section A-A' and B-B', existing monitoring wells 7D and 8D are fully screened in just the shale unit and because of their geo-spatial location will be utilized as the background (up gradient) wells for the landfill.

As shown on the cross-section D-D', monitoring wells 3D, 6D, 9D, and 15 are fully screened in the shale unit and will be utilized as the downgradient monitoring wells for the landfill.

With these wells in place, there are no gaps in the groundwater monitoring network for the Landfill for monitoring the uppermost aquifer unit.

3.3.3 Recommended Monitoring Well Network

The recommended groundwater monitoring well network is intended to meet specifications stated in 252:517-9-2 and 40 CFR 257.91.

Based on the available hydrogeological data presented in this report the recommended monitoring well network for the landfill CCR Unit consists of monitoring wells 7D and 8D as background monitoring wells and wells 3D, 6D, 9D, and 15 as down-gradient monitoring wells.

Additionally, other available monitoring wells screened in the shale unit may be gauged at the time of sampling the groundwater monitoring well network in order to provide a more comprehensive potentiometric groundwater map.

4.0 Certification

4.1 Limitations


The findings and conclusions resulting from this investigation are based upon information derived from the on-site activities and other services performed under the scope of work as described in this report; such information is subject to change over time if additional information is obtained. Please note that Terracon does not warrant the work of laboratories, regulatory agencies or other third parties supplying information used in the preparation of the report.

4.2 PE Certification


Name: <i>F. Owen Carpenter</i>	Date: <i>16-OCT-2017</i>	 Stamp
Company: <i>Terracon</i>	Expiration Date: <i>31-OCT-2019</i>	

Bibliography

- 1 Volume 1 Major Mod 2011 Terracon Project No. 35107130.
- 2 AEP, "Ash Landfill Modification – Construction Drawings", Northeastern Plant, Dated September 2014.
- 3 Hydrogeologic Summary Report, Terracon, March 2017.
- 4 Volume 3 Major Mod 2011 Terracon Project No. 35107130.
- 5 Well Installation Report, Terracon, May 2011.
- 6 <http://www.city-data.com/city/Oologah-Oklahoma.html>.
- 7 Volume 2 Major Mod 2011 Terracon Project No. 35107130.

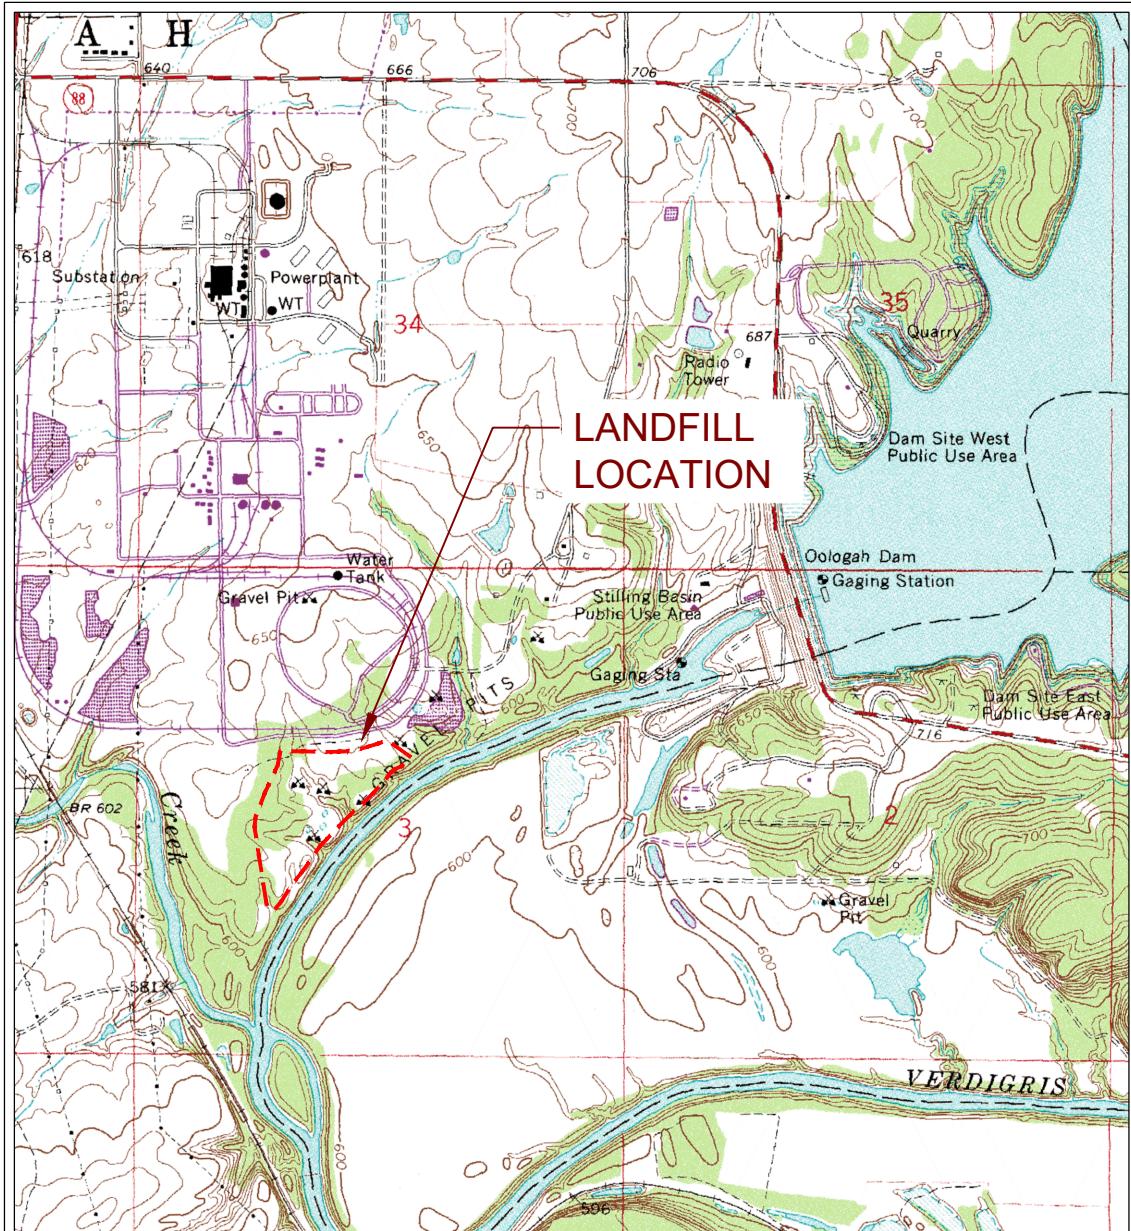

SCALE 1:24 000

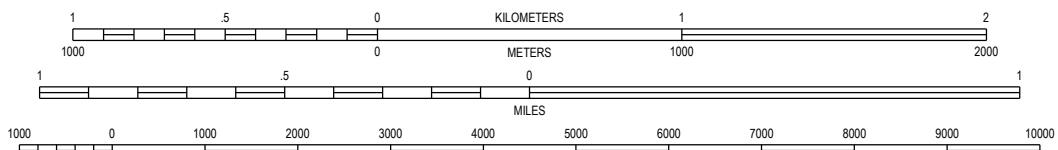

CONTOUR INTERVAL 10 FEET
NATIONAL GEODETIC VERTICAL DATUM OF 1929

OOLOGAH, OKLAHOMA
QUADRANGLE
1970 (PHOTO REVISED 1980)
7.5 MINUTE SERIES (TOPOGRAPHIC)




Project Mngr:	DCM
Drawn By:	TLB
Checked By:	TLB
Approved By:	DCM

Project No.
216-003-35157123
Scale:
AS SHOWN
File No.
001
Date:
07/27/2017

Terracon
Consulting Engineers and Scientists
25809 I-30 SOUTH BRYANT, AR 72022
PH. (501) 847-9292 FAX. (501) 847-9210

7.5 MINUTE SERIES (TOPOGRAPHIC)
GROUNDWATER MONITORING NETWORK
AMERICAN ELECTRIC POWER
NORTHEASTERN STATIONS 3 & 4
OOLOGAH OKLAHOMA

FIG. No.
1

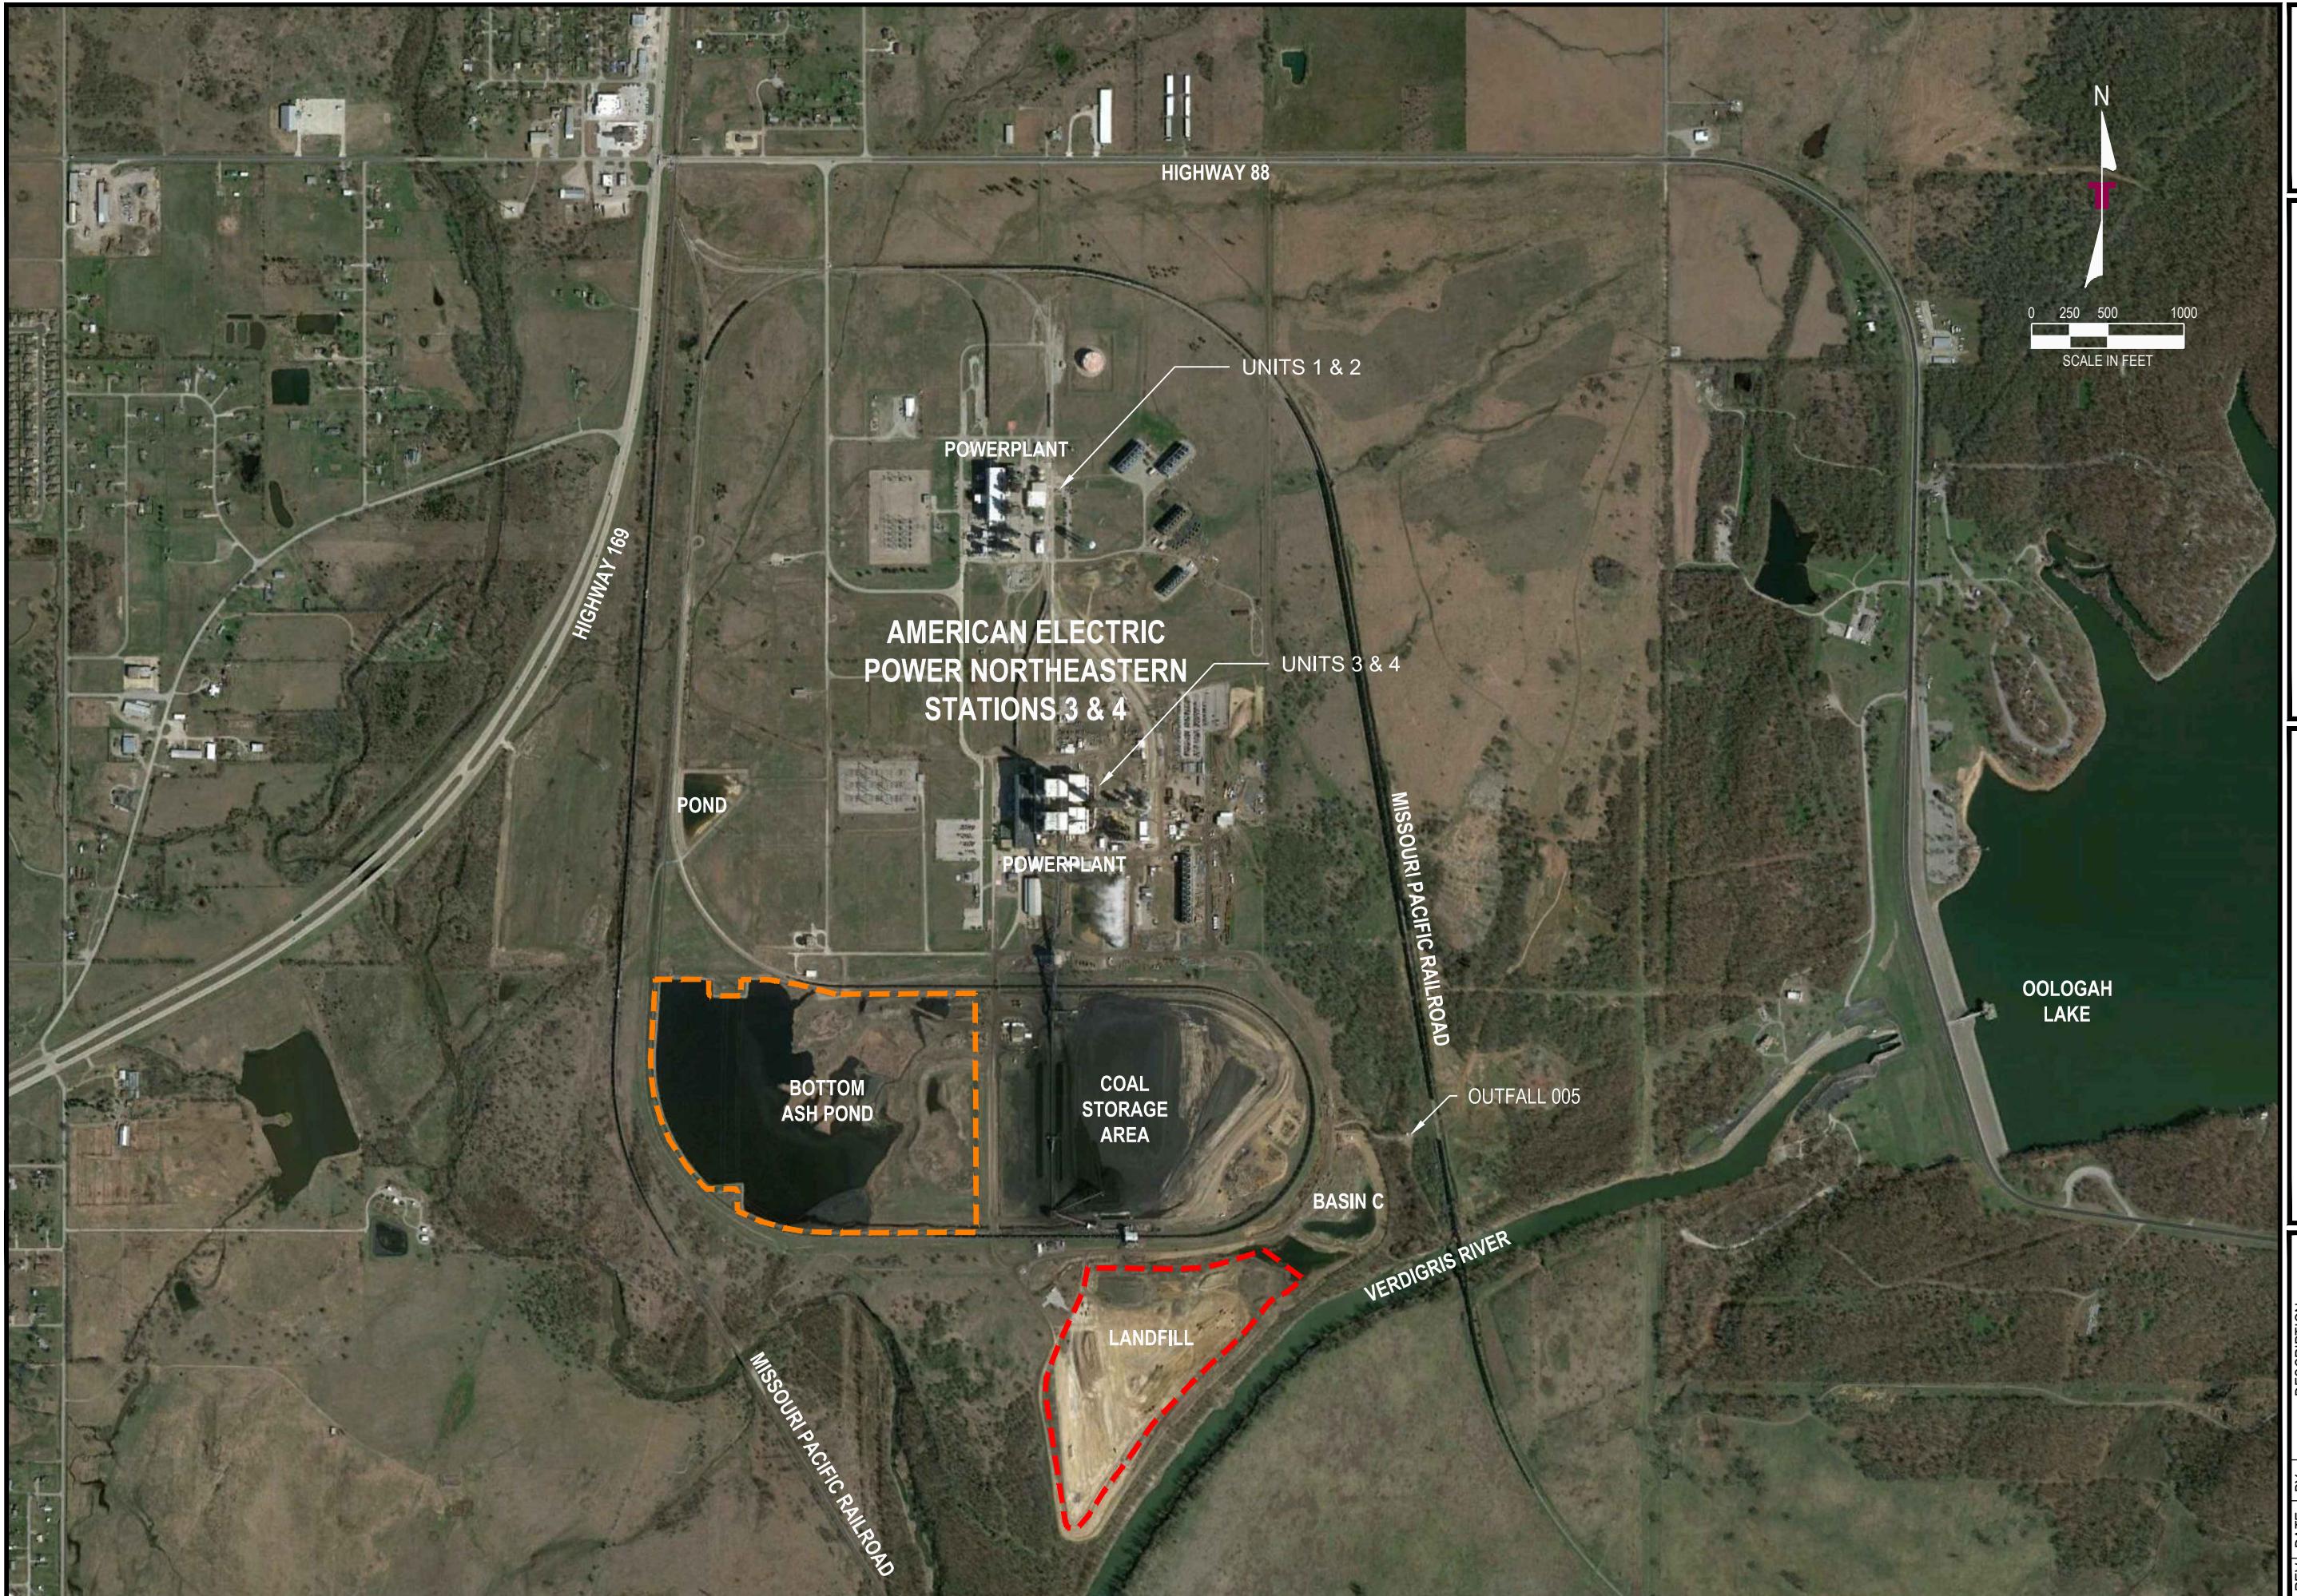

FIGURE


GROUNDWATER MONITORING NETWORK	
AMERICAN ELECTRIC POWER	
NORTHEASTERN STATIONS 3 & 4	
OOOGAHA	
DRAWN BY: TILB APPD. BY: DCM	SEE BARSSCALE
SCALE: 1:277,000	DATE: 07/27/2017
JOB NO. 002	ACAD NO. 002
SHEET NO.: 2 OF 7	

PLAN AND CCR UNIT LOCATION MAP

AMERICAN ELECTRIC POW
NORTHEASTERN STATIONS 3 & 4
OOOGAH
OKLAHOMA
GROUNDWATER MONITORING NETWORK

Terracon
Consulting Engineers and Scientists
25809 I-30 SOUTH
PH. (501) 847-9292

BRYANT, AR 72022
FAX (501) 847-9210

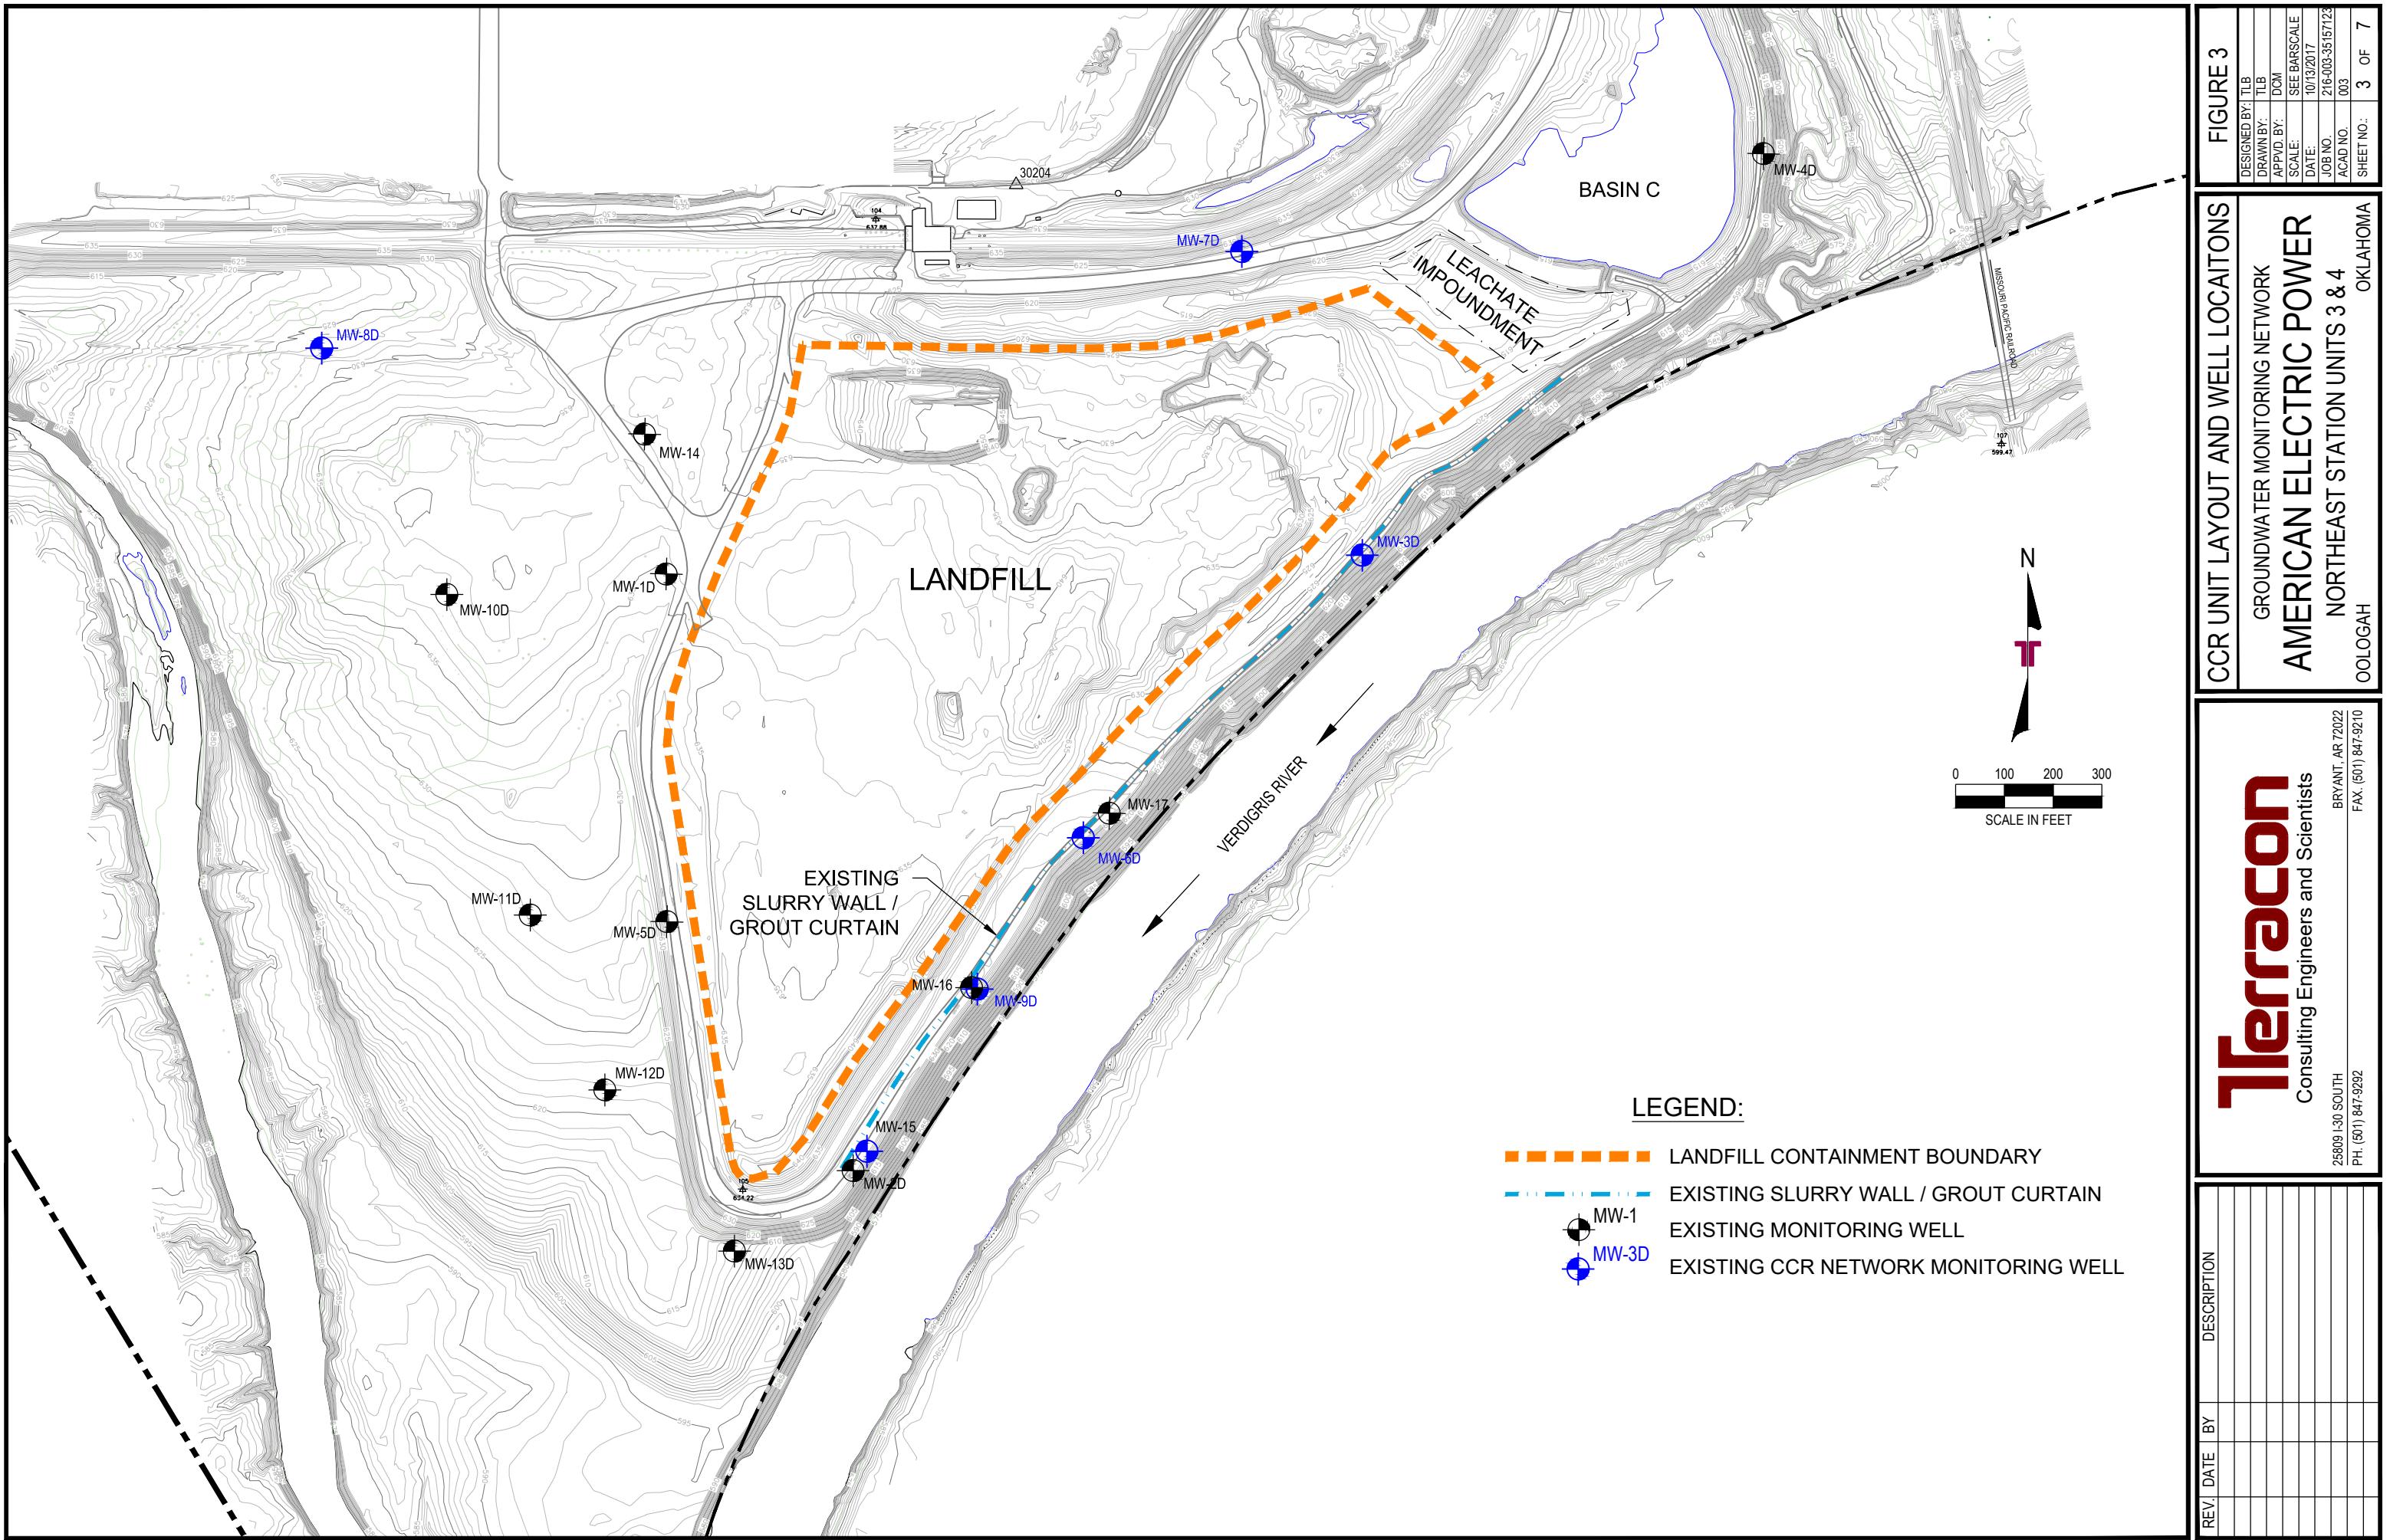

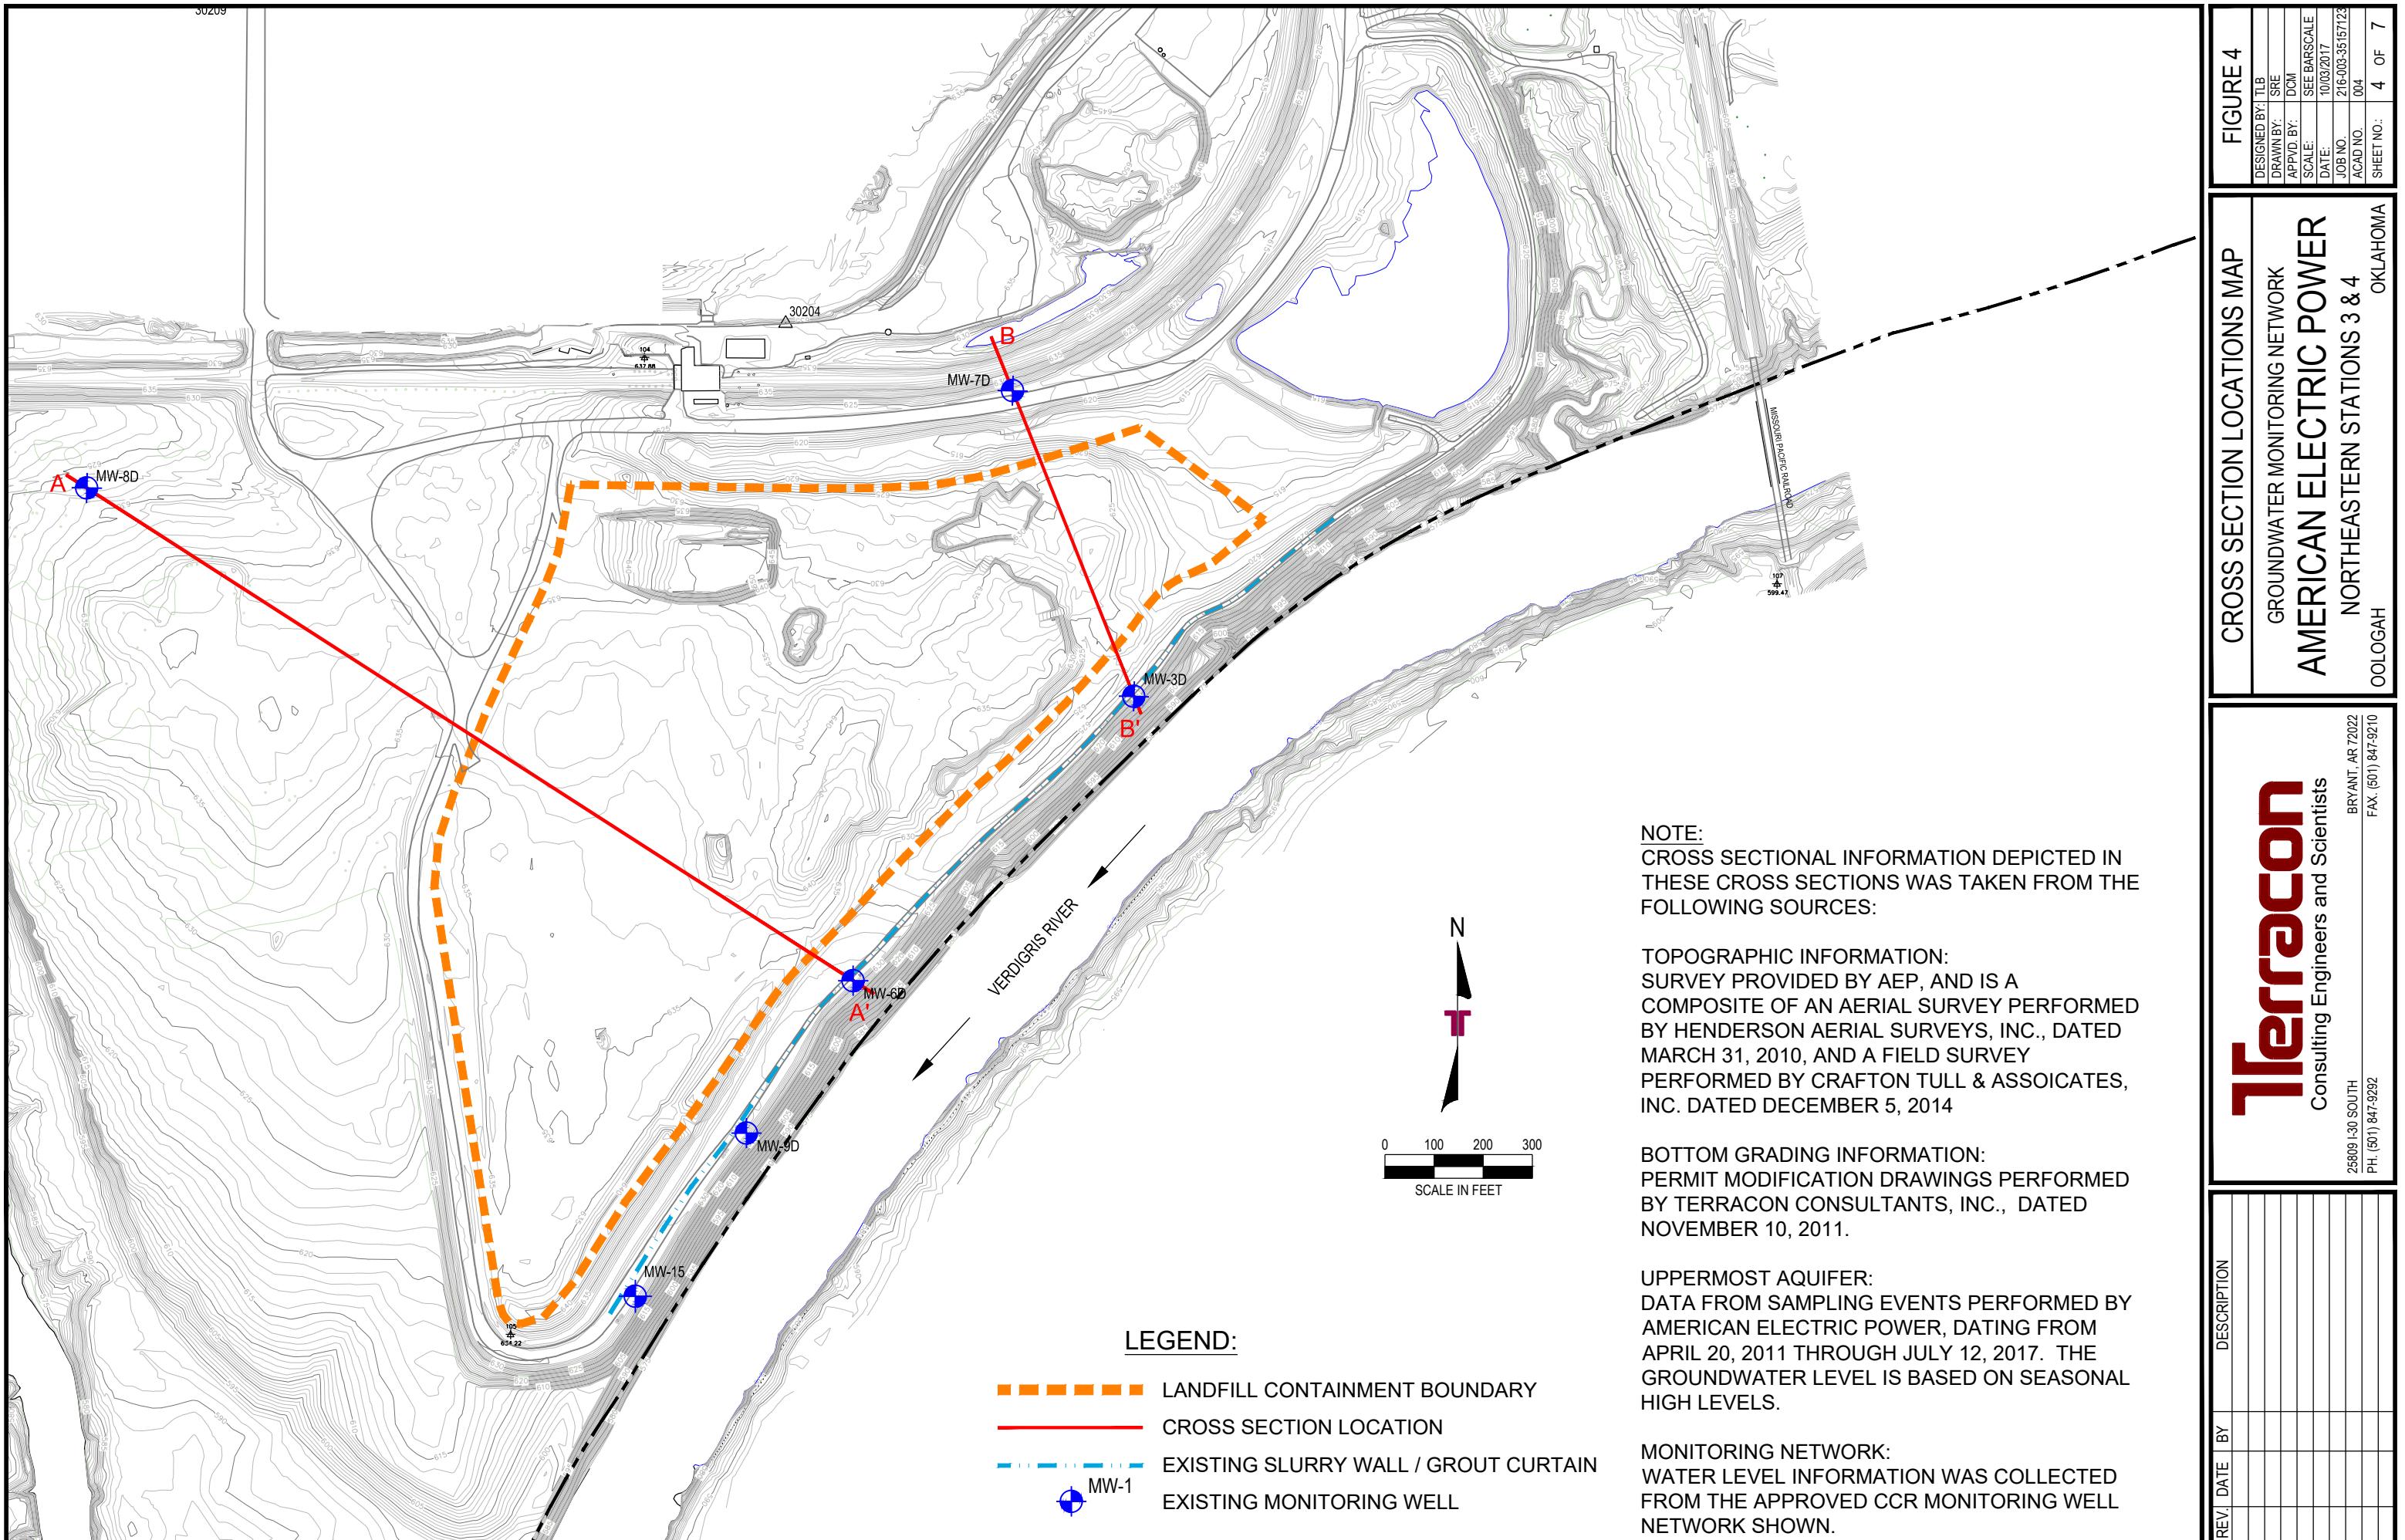



FIGURE 5

DESIGNED BY:	TLB
DRAWN BY:	SRE
APPROVED BY:	DCM
SEE BAR SCALE	
SCALE:	10/03/2017
DATE:	216-003-35157123
JOB NO.:	005
ACAD NO.:	OKLAHOMA
SHEET NO.:	5 OF 7


Terrcon
Consulting Engineers and Scientists
25809 1/30 SOUTH
PH. (501) 847-9292
FAX. (501) 847-9210
BRYANT, AR 72022

REV.	DATE	BY	DESCRIPTION

CROSS SECTION A-A'

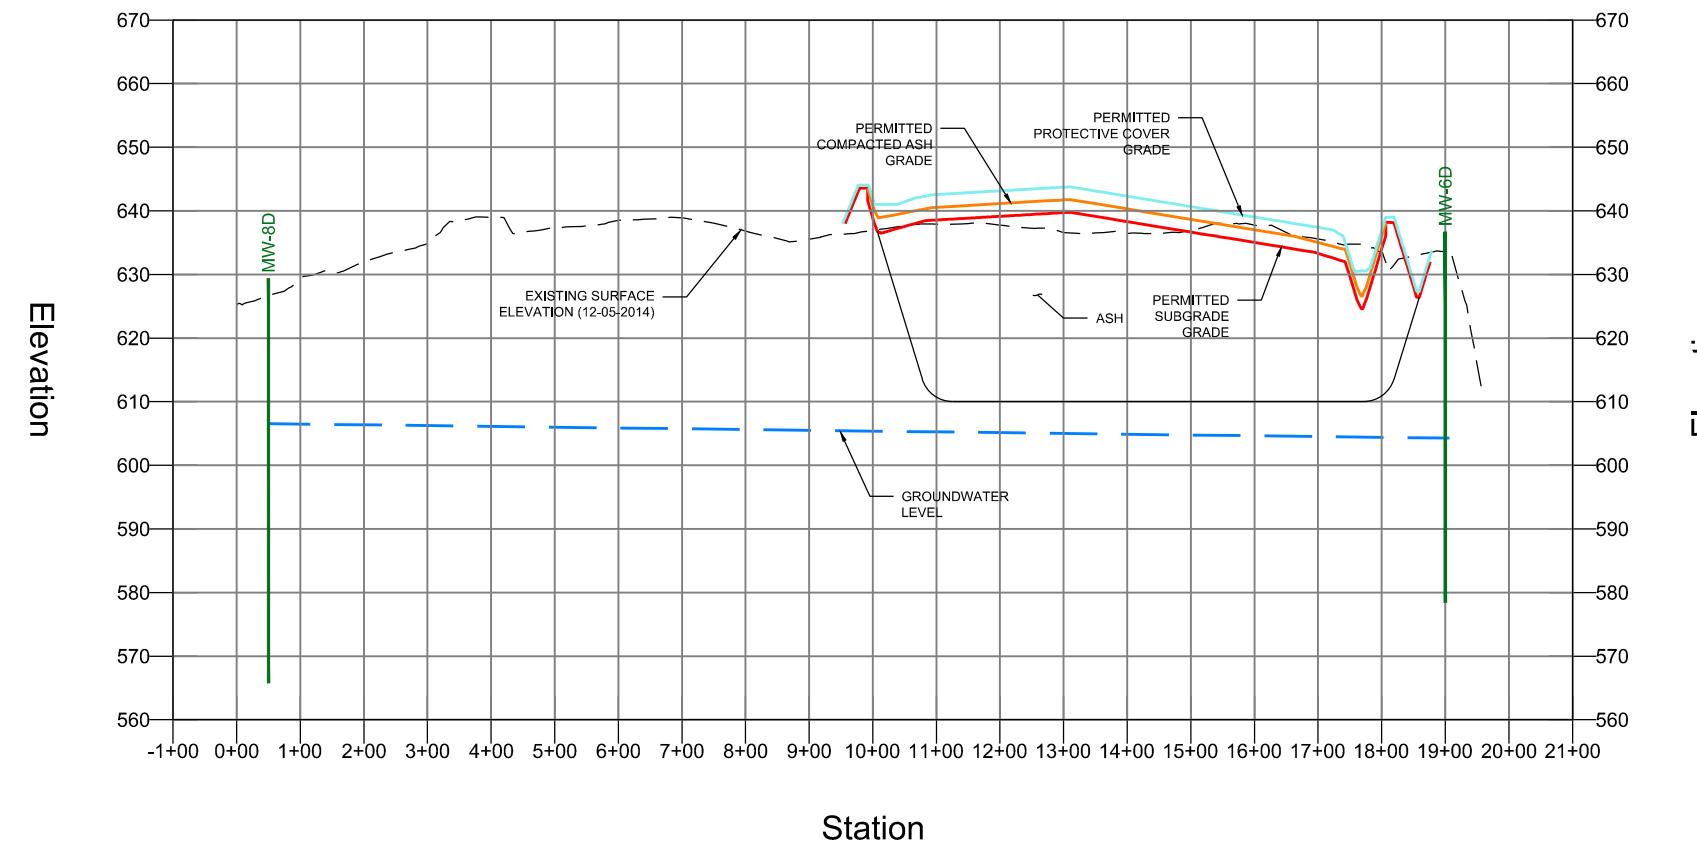

CROSS SECTION B-B'

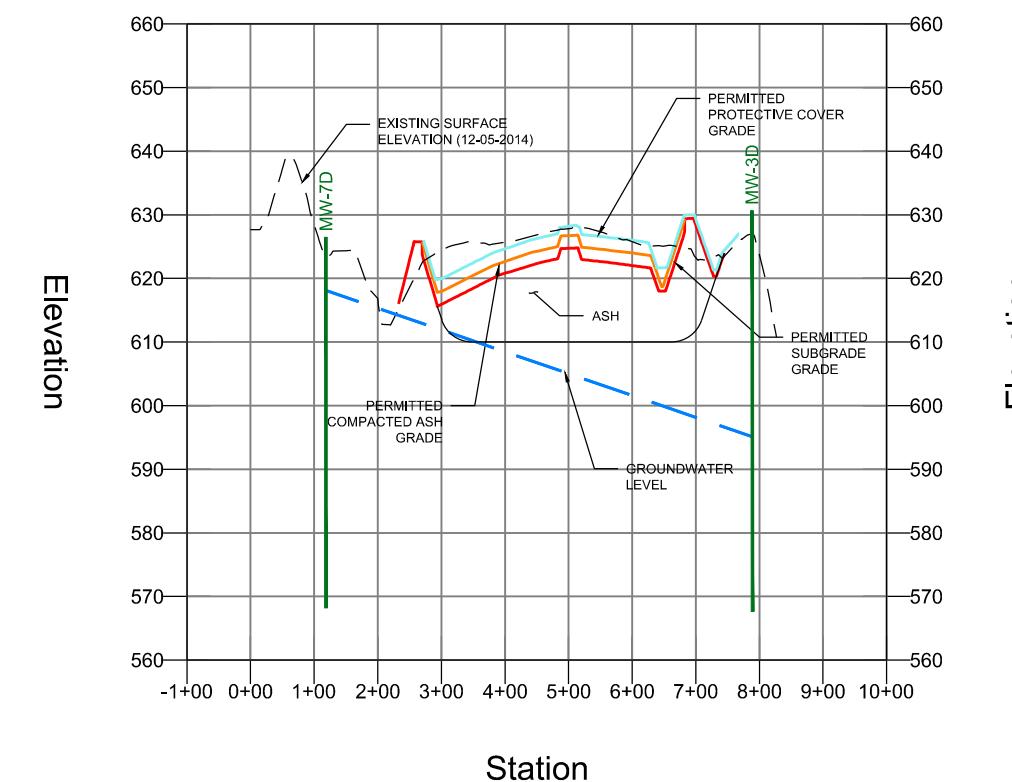

NOTE:

CROSS SECTIONAL INFORMATION DEPICTED IN THESE CROSS SECTIONS WAS TAKEN FROM THE FOLLOWING SOURCES:

TOPOGRAPHIC INFORMATION:

SURVEY PROVIDED BY AEP, AND IS A COMPOSITE OF AN AERIAL SURVEY PERFORMED BY HENDERSON AERIAL SURVEYS, INC., DATED MARCH 31, 2010, AND A FIELD SURVEY PERFORMED BY CRAFTON TULL & ASSOCIATES, INC. DATED DECEMBER 5, 2014

BOTTOM GRADING INFORMATION:
PERMIT MODIFICATION DRAWINGS PERFORMED BY TERRACON CONSULTANTS, INC., DATED NOVEMBER 10, 2011.

UPPERMOST AQUIFER:
DATA FROM SAMPLING EVENTS PERFORMED BY AMERICAN ELECTRIC POWER, DATING FROM APRIL 20, 2011 THROUGH JULY 12, 2017. THE GROUNDWATER LEVEL IS BASED ON SEASONAL HIGH LEVELS.

MONITORING NETWORK:
WATER LEVEL INFORMATION WAS COLLECTED FROM THE APPROVED CCR MONITORING WELL NETWORK (SEE FIGURE 4).

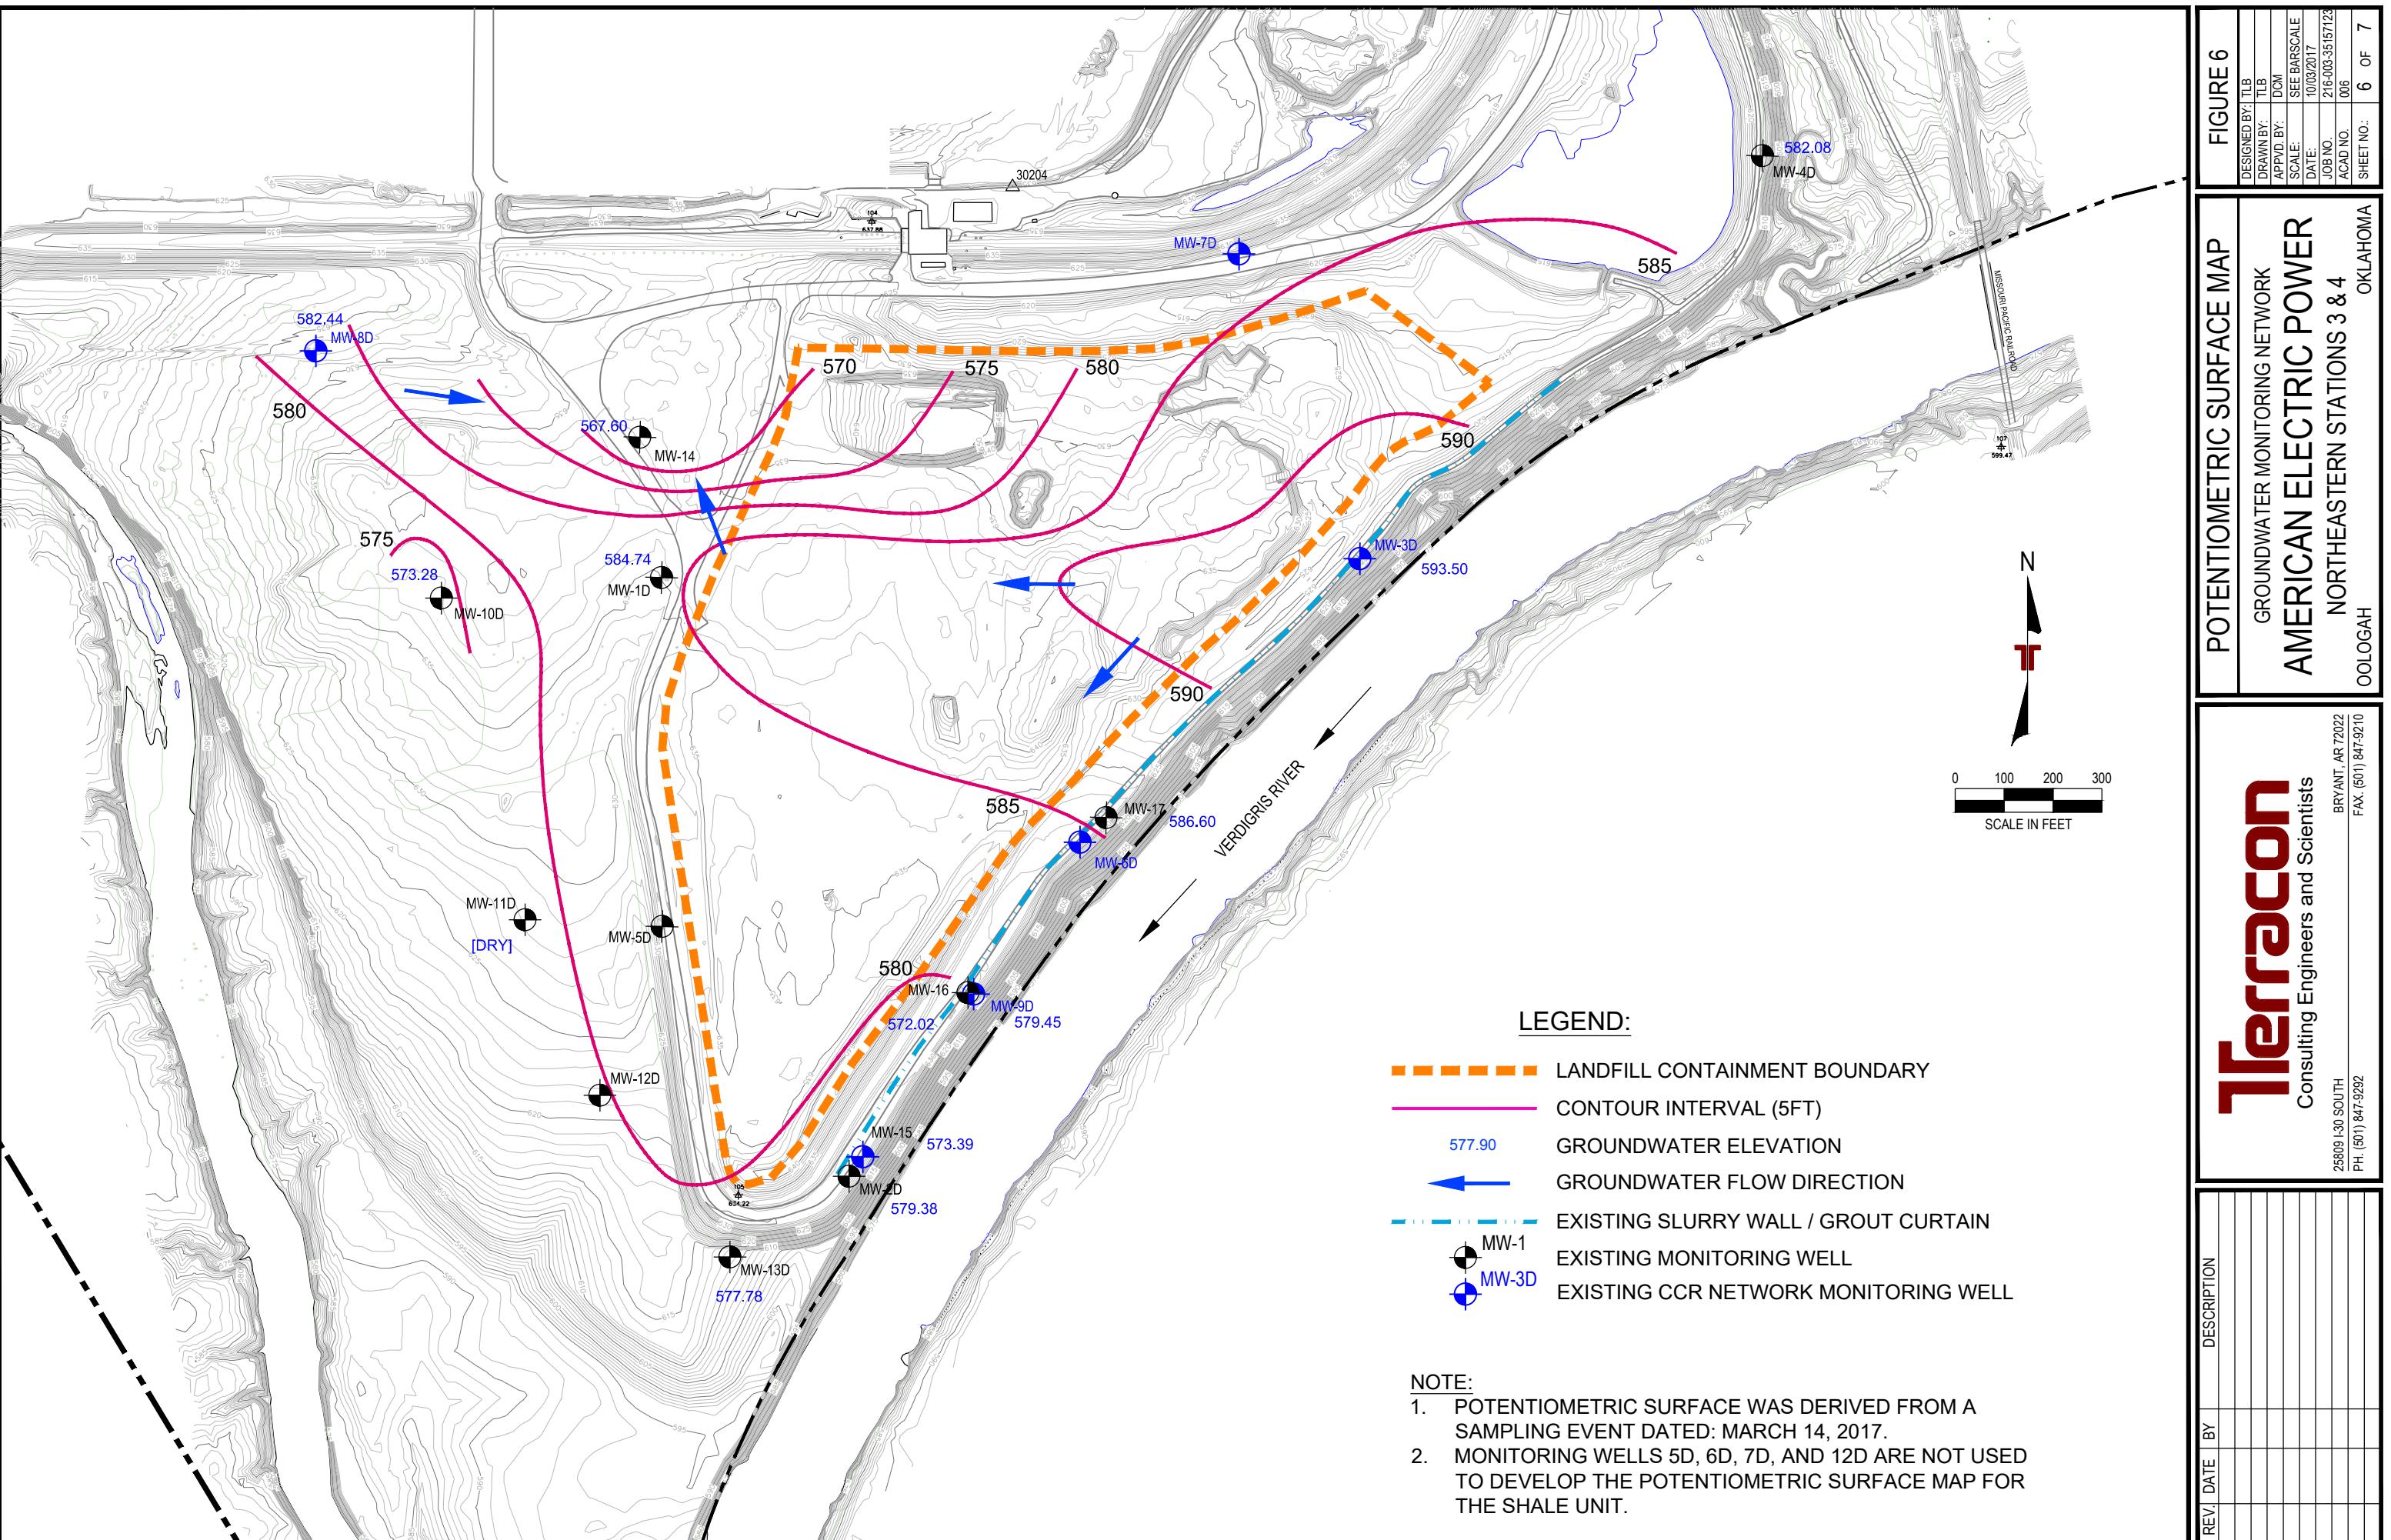


FIGURE 6

DESIGNED BY: TLB
DRAWN BY: TLB
APV'D BY: DCM
SEE BAR SCALE
SCALE: 10/03/2017
JOB NO.: 216-003-35157123
ACAD NO.: 006
SHEET NO.: 6 OF 7


POTENIOMETRIC SURFACE MAP

GROUNDWATER MONITORING NETWORK
AMERICAN ELECTRIC POWER
NORTHEASTERN STATIONS 3 & 4
OKLAHOMA
OOGAH

Terrcon
Consulting Engineers and Scientists

BRYANT, AR 72022
FAX: (501) 847-9210
25809 1-30 SOUTH
PH: (501) 847-9292

REV. DATE BY DESCRIPTION

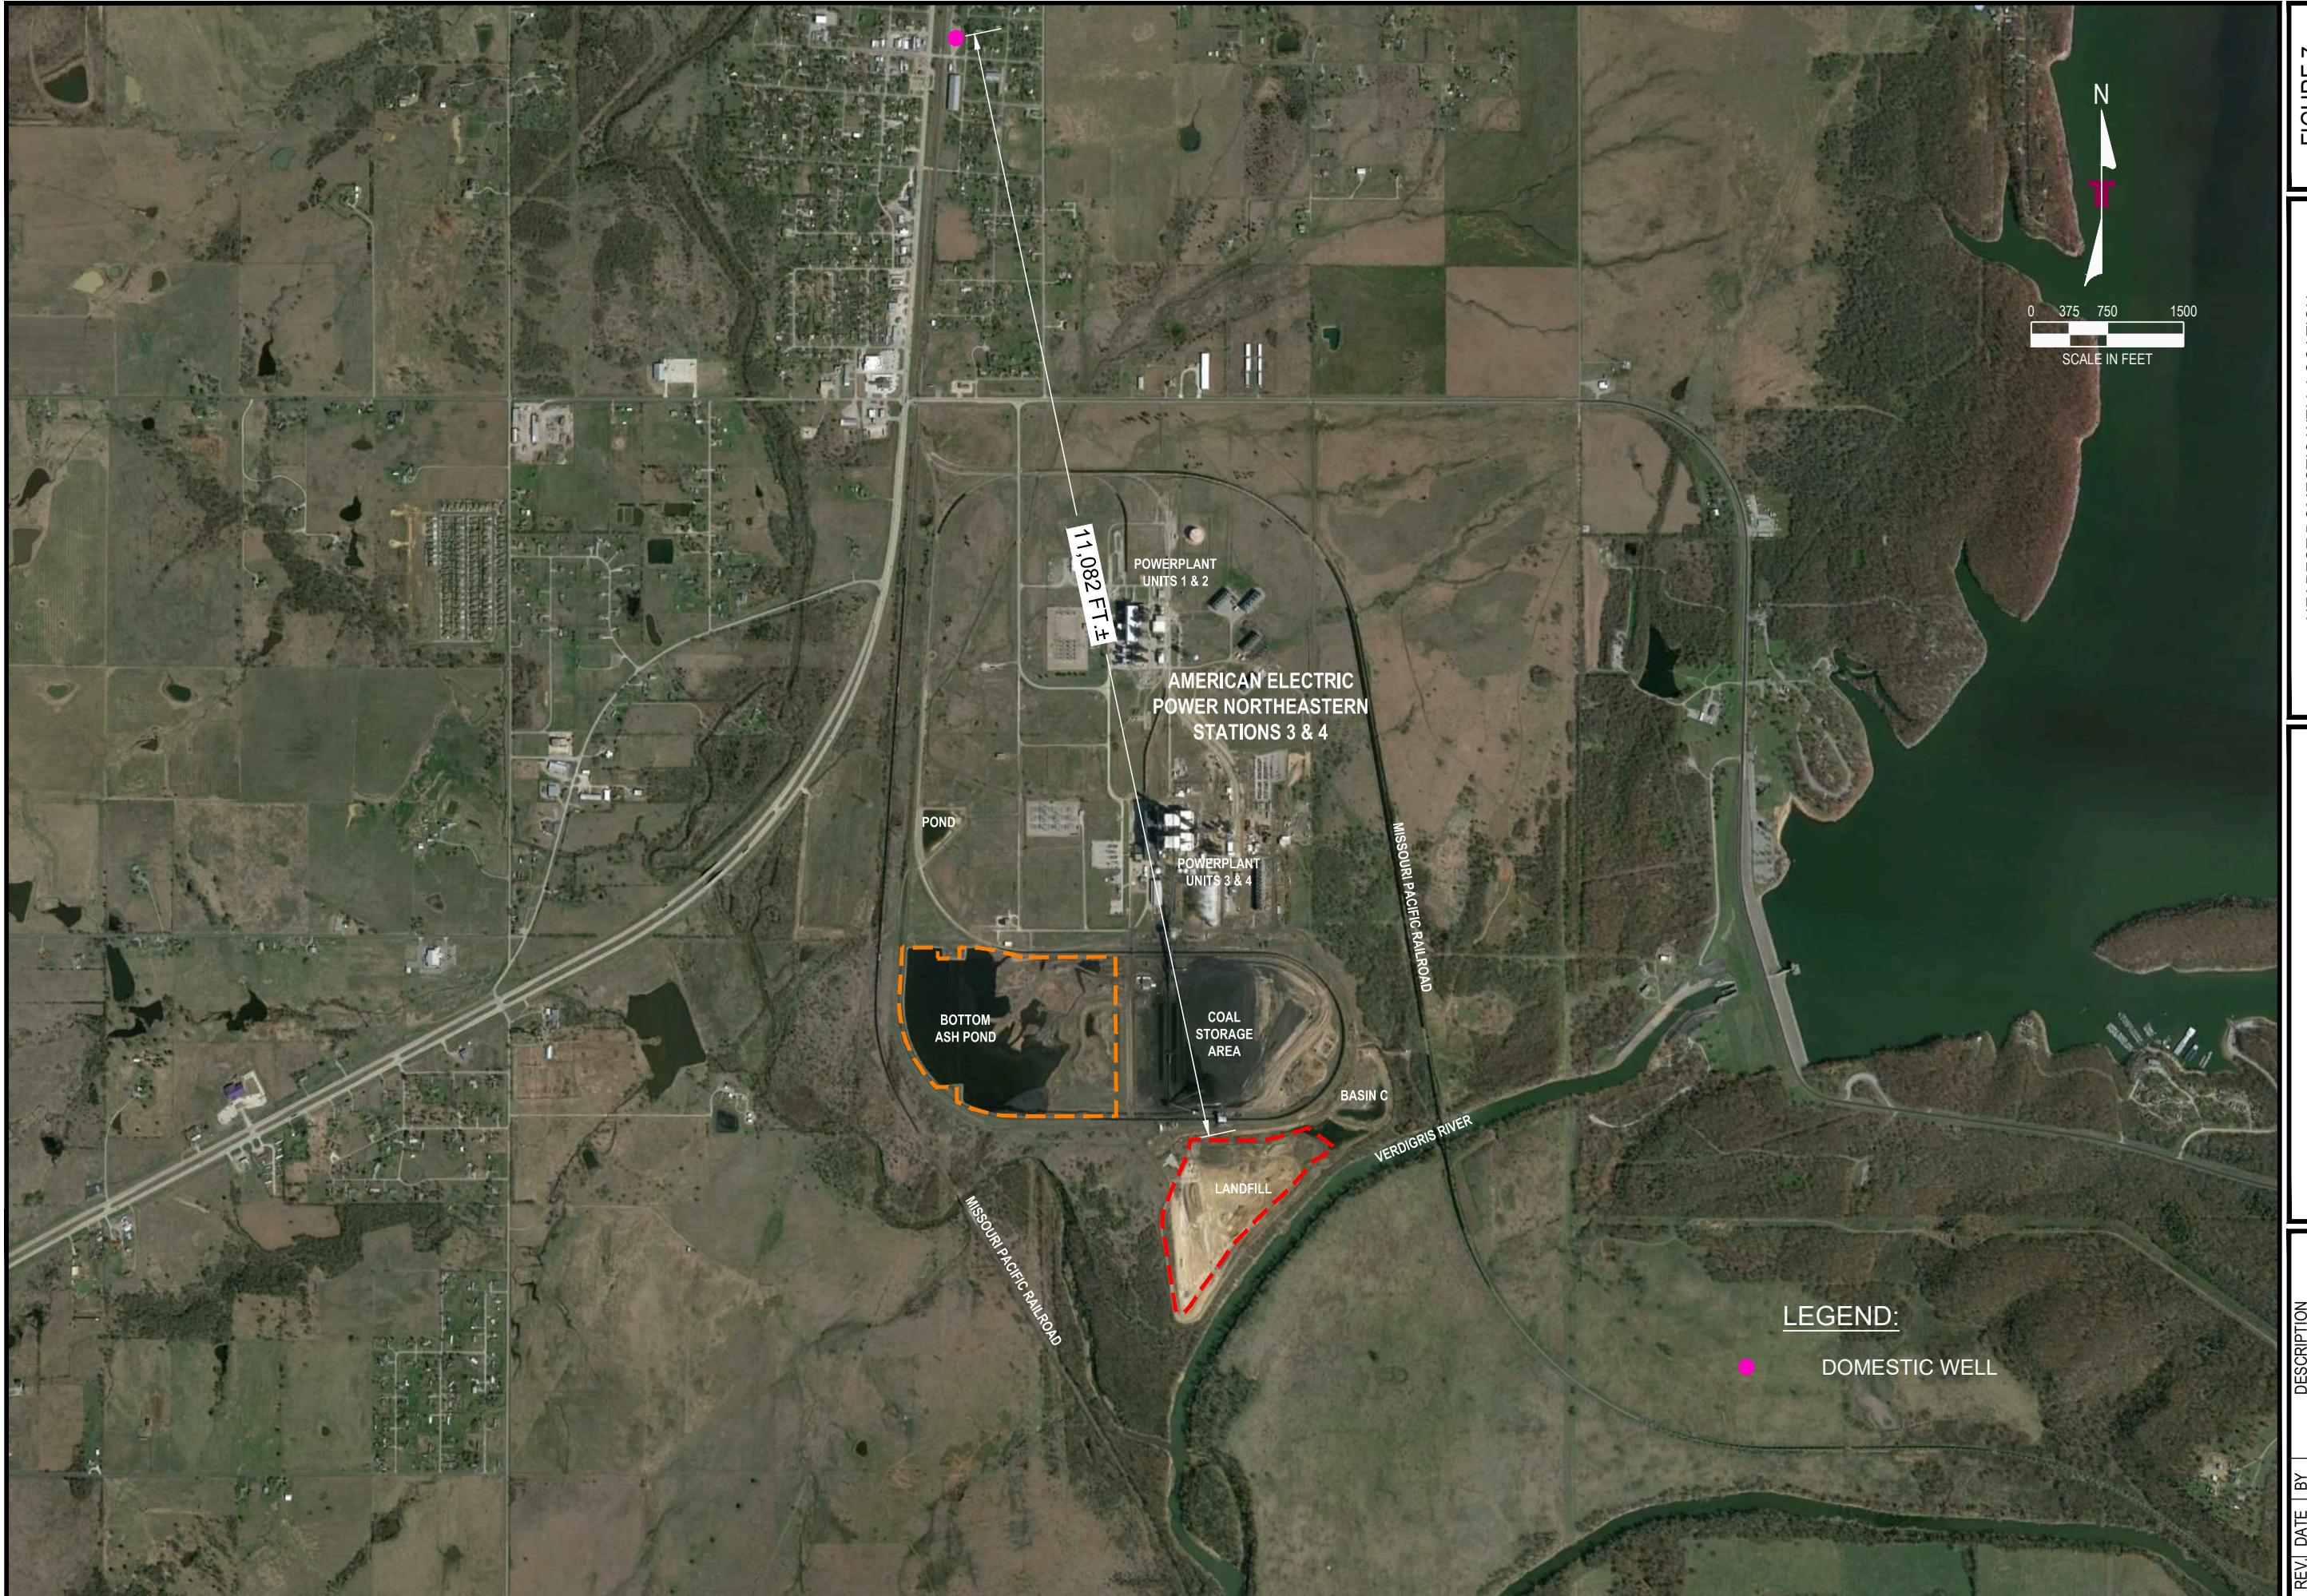

Terrcon
Consulting Engineers and Scientists

25809 1-30 SOUTH
PH. (501) 847-9292

BRYANT, AR 72022
FAX. (501) 847-9210

REV.	DATE	BY	DESCRIPTION

TABLE 1
 NORTHEASTERN STATION 3 & 4
 NON-HAZARDOUS INDUSTRIAL WASTE (NHIW) LANDFILL
 WELL LEVEL DATA
 GROUNDWATER ELEVATIONS (FMSL)

Well	MW-3D	MW-6D	MW-7D	MW-8D	MW-9D	MW-15
Date						
03/20/08	595.14					
07/01/08	594.65					
10/01/08	594.20					
11/11/08	594.10	600.51	586.54	569.47		
11/20/08	593.81	600.59	574.25	567.12		
03/13/09	593.70	599.49	581.24	574.67		
06/16/09	593.74	599.98	577.00	576.20		
09/29/09	593.53	599.83	574.77	574.36		
12/28/09	593.44	599.76	575.28	577.70		
03/09/10	593.70	599.98	571.96	576.87		
06/16/10	593.52	600.27	572.64	587.94	586.32	
09/14/10	593.04	599.53	573.57	575.19	585.01	
12/14/10	593.16	599.45	571.36	571.56	583.30	
03/08/11	593.29	599.61	571.08	578.62	583.56	
06/07/11	593.04	599.98	572.38	584.69	584.97	
09/13/11	594.45	600.18	573.44	586.35	584.25	
12/13/11	593.70	600.48	572.49	590.51	584.96	
03/13/12	593.52	600.45	573.19	603.46	584.08	
06/12/12	593.42	600.39	573.52	602.35	584.45	
09/18/12	593.30	600.01	573.25	592.89	582.42	
12/10/12	593.34	600.39	573.42	595.63	582.16	
03/12/13	593.38	600.78	575.33	600.19	582.33	
06/11/13	593.42	601.38	575.74	604.77	582.71	
09/24/13	593.36	601.93	578.97	599.83	583.58	
12/17/13	593.37	601.91	579.75	597.83	582.28	
03/05/14	593.44	601.49	583.91	606.54	581.95	
06/09/14	593.65	601.90	587.37	603.14	581.17	
09/09/14	593.51	601.90	593.30	598.66	582.00	
03/10/15	593.76	601.85	599.76	599.14	581.43	
06/15/15	593.81	604.26	618.12	589.88	582.32	
12/14/15	593.78	603.57	596.11	585.16	581.41	
03/16/16	592.57	601.89	612.87	597.03	581.63	582.77
05/16/16	593.61	603.16	596.80	586.54	581.35	581.72
07/20/16	-	-	-	583.39	-	577.33
09/19/16	592.95	602.91	603.59	577.05	581.02	576.57
10/06/16	593.00	-	-	570.72	-	576.43
03/14/17	593.50	601.86	604.65	582.44	579.45	573.39
05/18/17	576.24	603.00	576.65	568.34	578.12	591.14
06/15/17	593.39	603.44	617.31	569.53	580.75	581.95
06/27/17	593.34	603.37	598.96	567.86	576.69	579.07
07/12/17	592.63	602.60	582.74	568.45	576.68	577.90
Seasonal High	595.14	604.26	618.12	606.54	586.32	591.14

TABLE 2
 NORTHEASTERN STATION 3 & 4
 NON-HAZARDOUS INDUSTRIAL WASTE (NHIW) LANDFILL
 MONITORING WELL/PIEZOMETER CONSTRUCTION DETAILS

Well Number	Latitude	Longitude	Ground Surface Elevation	Top of Casing Elevation	Borehole Depth ft.bls	Date Installed	Screen Material	Well Diameter inches	Top of Screen Depth ft. bls	Top of Screen Elevation ft. msl	Bottom of Screen Depth ft. bls	Bottom of Screen Elevation ft. msl
MW-3D	36° 25' 00.14299"	95° 41' 44.01366"	627.66	630.65	60	2/21/2008	PVC	2	49.7	580.95	60	567.66
MW-6D	36° 24' 54.41869"	95° 41' 51.01306"	633.72	636.66	55	10/23/2008	PVC	2	44.92	591.74	55.22	578.50
MW-7D	36° 25' 06.30327"	95° 41' 47.03123"	623.74	626.46	55	10/22/2008	PVC	2	45.25	581.21	55.55	568.19
MW-8D	36° 25' 04.35228"	95° 42' 10.11303"	626.04	629.32	60	10/21/2008	PVC	2	49.95	579.37	60.25	565.79
MW-9D	36° 24' 50.88110"	95° 41' 54.22530"	633.90	637.04	60	4/6/2010	PVC	2	49.7	587.34	60	573.90
MW-15	36° 24' 48.0816"	95° 41' 56.4658"	634.34	637.71	71	2/23/2016	PVC	2	61.05	576.66	71.45	562.89

APPENDIX 1

Boring & Monitoring Well Installation Logs

Boring Logs



Consulting Engineers and Scientists

25809 Interstate-30
PH. (501) 847-9292BRYANT, AR 72022
FAX. (501) 847-9210**FIELD BORING LOG**

BORING NO.: B-1/MW-1

PAGE: 1 of 1

TOTAL DEPTH: 35 FEET BELOW GROUND SURFACE (BGS)

CLIENT: AMERICAN ELECTRIC POWER

JOB NO.: 216-003-35077150-003

LOGGED BY: MR

DATE DRILLED: 2/18/08

DRILLING METHOD: AIR HAMMER

SAMPLING METHOD: NX ROCK CORE

Depth BGS	N:	E:	TOC:	Litho. Symbol	Run #	% Recovery	RQD	Remarks
	DESCRIPTION							
0	0'-2' CLAY, dark brown, slightly moist, some silt, firm.	2'-3.5' CLAY, red, dry, some limestone fragments.						0'-4' Hollow Stem Auger Cored 4'-35' Reamed out with 6" Air Hammer
5	3.5'-35' LIMESTONE, tan, massive bedded, micritic with some calcite crystals, some horizontal bedding plane fractures.	- Becoming gray, dry.		1 4'-14'	95	73		Penetration Rate (P.R.) = 0.5 ft/min
10								
15								
20								
25								
30								
35	Total Depth = 35'							NA = Not Available Core sample stuck in barrel and damaged during retrieval.



25809 Interstate-30

PH. (501) 847-9292

BRYANT, AR 72022

FAX. (501) 847-9210

FIELD BORING LOG

BORING NO.: B-2/MW-2

PAGE: 1 of 2

TOTAL DEPTH: 59 FEET BELOW GROUND SURFACE (BGS)

CLIENT: AMERICAN ELECTRIC POWER

JOB NO.: 216-003-35077150-004

LOGGED BY: MR

DATE DRILLED: 2/19/08

DRILLING METHOD: HSA / AIR HAMMER

SAMPLING METHOD: CONTINUOUS SAMPLER

Depth BGS	N: E: TOC: DESCRIPTION	Litho. Symbol	Run #	% Recovery	RQD	Remarks
0	0'-9' GRAVELY CLAY, red to brown, dry, trace silt, firm.	●				H.S.A. 0'-28'. Air Hammer 28'-59'
5		●				5'-7' Pushed shelby tube. Poor recovery due to gravel.
10	9'-10' SILTY SAND, gray, dry 10'-22' SILT, tan, soft to hard bedded layers, dry to 19'.				
15					
20					Wet at 19'.
25	22'-28' GRAVELY CLAY, brown, some limestone rock fragments, wet.	●				Hard Limestone bed 23' to 24'.
30	28'-33' LIMESTONE, gray, massive bedded, dry.					Auger refusal at 28' (Limestone).
35	33'-55' SHALE, gray to black, hard to weathered, dry.					



Consulting Engineers and Scientists

25809 Interstate-30
PH. (501) 847-9292

BRYANT, AR. 72022
FAX. (501) 847-9210

FIELD BORING LOG

BORING NO.: B-2/MW-2

PAGE: 2 of 2

TOTAL DEPTH: 59' FEET BELOW GROUND SURFACE (BGS)

CLIENT: AMERICAN ELECTRIC POWER

PROJECT: NE PLANT | ANDELL

JOB NO.: 216-003-35077150-004

DRILLING CO : MOHAWK

LOGGED BY: MR

DRILLER: KEVIN

DATE DRILLED: 2/19/08

RIG TYPE: STRATASTAR 25

DRILLING METHOD: HSA/HAMMER

SAMPLING METHOD: CONTINUOUS SAMPLER



Consulting Engineers and Scientists

25809 Interstate-30
PH. (501) 847-9292

BRYANT, AR. 72022
FAX (501) 847-9210

FIELD BORING LOG

BORING NO.: B-3/MW-3 PAGE: 1

TOTAL DEPTH: 60 FEET BELOW GROUND SURFACE (BGS)

CLIENT: AMERICAN ELECTRIC POWER

PROJECT: NE PLANT LANDER

JOB NO.: 216-003-35077150-005

D R I L L I N G C O . M O H A W K

LOGGED BY: MR

DRILLER: KEVIN

DATE DRILLED: 2/20/08

RIG TYPE: STRATASTAR 25

DRILLING METHOD: HSA / AIR HAMMER

SAMPLING METHOD: CONTINUOUS SAMPLER



Consulting Engineers and Scientists

25809 Interstate-30
PH. (501) 847-9292

BRYANT, AR. 72022
FAX. (501) 847-9210

FIELD BORING LOG

BORING NO.: B-3/MW-3

PAGE: 2

TOTAL DEPTH: 60 FEET BELOW GROUND SURFACE (BGS)

Depth BGS	DESCRIPTION	Litho. Symbol	Run #	% Recovery	RQD	Remarks
40						
45	45'-60' SHALE, black, hard, dry.					No show of groundwater, but water seeped in boring overnight.
50						
55						
60	T.D. @ 60'					
65						
70						
75						



Consulting Engineers and Scientists

25809 Interstate-30
PH. (501) 847-9292BRYANT, AR. 72022
FAX. (501) 847-9210

FIELD BORING LOG

BORING NO.: B-4/MW-4 PAGE: 1

TOTAL DEPTH: 50 FEET BELOW GROUND SURFACE (BGS)

CLIENT: AMERICAN ELECTRIC POWER

PROJECT: NE PLANT LANDFILL

JOB NO.: 216-003-35077150-006

DRILLING CO.: MOHAWK

LOGGED BY: MR

DRILLER: KEVIN

DATE DRILLED: 2/21/08

RIG TYPE: STRASTASTAR 25

DRILLING METHOD: HSA / AIR HAMMER

SAMPLING METHOD: CONTINUOUS SAMPLER / NX ROCK CORE

Depth BGS	N:	E:	ELEV:	Litho. Symbol	Run #	% Recovery	RQD	Remarks
	DESCRIPTION							
0	0'-16' GRAVELY CLAY, brown, dry, some limestone rock fragments.							H.S.A. 0'-16' cored 16'-35' Reamed out with 6" air hammer.
5								
10								
13'	Some silt and fine sand.							
15								
16'	16'-38' LIMESTONE, gray, massive bedding, some thin shale beds, some horizontal bedding plane features.			1	16'-20'	50	60	Rock at 16'.
20				2	20'-25'	80	50	
25				3	25'-30'	95	80	
30	2" Vertical fracture.			4	30'-35'	95	75	



Consulting Engineers and Scientists

25809 Interstate-30
PH. (501) 847-9292

BRYANT, AR. 72022
FAX. (501) 847-9210

FIELD BORING LOG

BORING NO.: B-4/MW-4

PAGE: 2

TOTAL DEPTH: 50 FEET BELOW GROUND SURFACE (BGS)

Depth BGS	DESCRIPTION	Litho. Symbol	Run #	% Recovery	RQD	Remarks
38'-40'	SHALE, black, hard.					
40						
45						
50	T.D. @ 50'					Wet at 45'.
55						
60						
65						
70						
75						



Consulting Engineers and Scientists

25809 Interstate-30
PH. (501) 847-9292BRYANT, AR 72022
FAX. (501) 847-9210

FIELD BORING LOG

BORING NO.: MW-1D

PAGE: 1 of 2

TOTAL DEPTH: 55 FEET BELOW GROUND SURFACE (BGS)

CLIENT: AMERICAN ELECTRIC POWER

PROJECT: NE PLANT LANDFILL

JOB NO.: 216-003-35087115-017

DRILLING CO.: MOHAWK

LOGGED BY: CLANCY McCLINTOCK

DRILLER: KEVIN

DATE DRILLED: 9/30/08

RIG TYPE: STRASTAR 25/CME 55

DRILLING METHOD: HOLLOW STEM AUGER

SAMPLING METHOD: SPLIT SPOON/NX ROCK CORE

Depth Elev.	BGS	N: 36° 24' 59.77" E: 95° 92' 01.47" G.S. ELEV. 635.23	DESCRIPTION	Litho. Symbol	Run #	% Recovery	RQD	Blow Count per 0.5'	Remarks
				DESCRIPTION	Run #	% Recovery			
0	0'-3.5'	GRAVELLY CLAY dark brown, Limestone fragments							
5	3.5'-41'	LIMESTONE gray, crystalline, some thin mud seams, some bedding plane fractures, dry		1	95	40			
10				2	40	0			
15				3	100	44			
20				4	85	27			PR=0.5ft/min. Void at 9'-11.5'
25				5	90	28			
30				6	90	45			Wet zones 18.5'-20' PR=0.35ft/min.
35				7	100	68			
				8					PR=0.25ft/min.



Consulting Engineers and Scientists

25809 Interstate-30
PH. (501) 847-9292BRYANT, AR 72022
FAX. (501) 847-9210

FIELD BORING LOG

BORING NO.: MW-1D

PAGE: 2 of 2

TOTAL DEPTH: 55 FEET BELOW GROUND SURFACE (BGS)

Elev.	Depth BGS	DESCRIPTION	Litho. Symbol	Run #	% Recovery	RQD	Blow Count per 0.5'	Remarks
	40							
	41'-55' SHALE	dark gray to black, hard, some bedding plane fractures		8	60	64		
	45			9	80	65		
	50			10	100	48		
	55	Total Depth = 55'						
	60							
	65							
	70							
	75							
	80							
	85							
	90							
	95							



Consulting Engineers and Scientists

25809 Interstate-30
PH. (501) 847-9292BRYANT, AR 72022
FAX. (501) 847-9210

FIELD BORING LOG

BORING NO.: MW-2S

PAGE: 1 of 1

TOTAL DEPTH: 33.5 FEET BELOW GROUND SURFACE (BGS)

CLIENT: AMERICAN ELECTRIC POWER

PROJECT: NE PLANT LANDFILL

JOB NO.: 216-003-35087115-018

DRILLING CO.: MOHAWK

LOGGED BY: CLANCY McCLINTOCK

DRILLER: KEVIN

DATE DRILLED: 9/30/08

RIG TYPE: STRASTAR 25/CME 55

DRILLING METHOD: HOLLOW STEM AUGER

SAMPLING METHOD: SPLIT SPOON/NX ROCK CORE

	N: 36° 24' 47.57" E: 95° 41' 56.87" G.S. ELEV. 634.45	DESCRIPTION	Litho. Symbol	Run #	% Recovery	RQD	Blow Count per 0.5'	Remarks
Depth Elev.	BGS							
0	0'-9' CLAY dark brown, Limestone fragments						4-5-6 6	
5							4-6-4 6	
10	9'-9.5' ASH gray to dark gray, dry 9.5'-10.5' GRAVELLY CLAY brown, dry 10.5'-21' ASH tan, very fine, wet at 12'						5-6-8 6	
15							9-6-7 6	
20							3-3-3 6	
21	21'-25' GRAVELLY CLAY red to black, trace silt, moist						9-17-17 6	
25	25'-28.5' LIMESTONE gray, massive bedded			1	20	70	2-8-9 6	
28.5							1 6	
30	28.5'-33.5' LIMESTONE gray with increasing thin interlayered shale beds			2	40	29		
33.5	Total Depth = 33.5'							



Consulting Engineers and Scientists

25809 Interstate-30
PH (501) 847-9292

BRYANT, AR, 72022

FAX (501) 847-9210

FIELD BORING LOG

BORING NO.: MW-3S

PAGE: 1 of 1

TOTAL DEPTH: 29 **FEET BELOW GROUND SURFACE (BGS)**

CLIENT: AMERICAN ELECTRIC POWER

PROJECT: NE PLANT LANDFILL

JOB NO.: 216-003-35087115-019

DRILLING CO.: MOHAWK

LOGGED BY: CLANCY McCLINTOCK

DRILLER: KEVIN

DATE DRILLED: 10/1/08

RIG TYPE: STRASTA STAR 25/CME 55

DRILLING METHOD: HOLLOW STEM AUGER

SAMPLING METHOD: SPLIT SPOON/NX ROCK CORE



Consulting Engineers and Scientists

25809 Interstate-30
PH. (501) 847-9292BRYANT, AR 72022
FAX. (501) 847-9210

FIELD BORING LOG

BORING NO.: MW-4S

PAGE: 1 of 1

TOTAL DEPTH: 30 FEET BELOW GROUND SURFACE (BGS)

CLIENT: AMERICAN ELECTRIC POWER

PROJECT: NE PLANT LANDFILL

JOB NO.: 216-003-35087115-020

DRILLING CO.: MOHAWK

LOGGED BY: CLANCY McCLINTOCK

DRILLER: KEVIN

DATE DRILLED: 10/2/08

RIG TYPE: STRASTAR 25/CME 55

DRILLING METHOD: HOLLOW STEM AUGER

SAMPLING METHOD: SPLIT SPOON/NX ROCK CORE

Elev. Depth BGS	DESCRIPTION	Litho. Symbol	Run #	% Recovery	RQD	Blow Count per 0.5'	Remarks
0	0'-12' GRAVELLY CLAY brown, some silt, hard, dry					4-5-6 6	
ST 5	Shelby Tube from 3'-5'					6-17-17 6	
10						7-7-8 6	
12	12'-30' LIMESTONE gray to dark gray, crystalline, dry					29-25-50+ 6	
15			1	20	50		
20	- Some thin mud seams, dry		2	20	71		
25			3	95	90		
30	Total Depth = 30'						
35							



Consulting Engineers and Scientists

25809 Interstate-30
PH. (501) 847-9292BRYANT, AR 72022
FAX. (501) 847-9210

FIELD BORING LOG

BORING NO.: MW-5D

PAGE: 1 of 2

TOTAL DEPTH: 55 FEET BELOW GROUND SURFACE (BGS)

CLIENT: AMERICAN ELECTRIC POWER

PROJECT: NE PLANT LANDFILL

JOB NO.: 216-003-35087115-021

DRILLING CO.: MOHAWK

LOGGED BY: CLANCY McCLINTOCK

DRILLER: KEVIN

DATE DRILLED: 10/7/08

RIG TYPE: STRASTAR 25/CME 55

DRILLING METHOD: HOLLOW STEM AUGER

SAMPLING METHOD: SPLIT SPOON/NX ROCK CORE

Depth Elev.	BGS	DESCRIPTION	Litho. Symbol	Run #	% Recovery	RQD	Blow Count per 0.5'	Remarks
0		0'-10' GRAVELLY CLAY brown, silty with orange mottles, dry						
ST		Shelby Tube from 3'-5'						
5								
ST		Shelby Tube from 8'-10'						
10		10'-40' LIMESTONE gray, crystalline, some bedding plane fractures		1	60	61		
15		- Some thin shale beds		2	100	39		PR=0.2 ft/min.
20				3	100	36		
25				4	100	58		
30				5	90	39		
35				6	20	31		
				7	100	58		



Consulting Engineers and Scientists

25809 Interstate-30
PH. (501) 847-9292BRYANT, AR 72022
FAX. (501) 847-9210

FIELD BORING LOG

BORING NO.: MW-5D

PAGE: 2 of 2

TOTAL DEPTH: 55 FEET BELOW GROUND SURFACE (BGS)

Elev.	Depth BGS	DESCRIPTION	Litho. Symbol	Run #	% Recovery	RQD	Blow Count per 0.5'	Remarks
	40	40'-55' SHALE dark gray, dry						
	45			8	100	75		
	50			9	100	81		
	55	Total Depth = 55'						
	60							
	65							
	70							
	75							
	80							
	85							
	90							
	95							



Consulting Engineers and Scientists

25809 Interstate-30
PH (501) 847-9292

BRYANT, AR, 72022

FAX (501) 847-9210

FIELD BORING LOG

BORING NO.: MW-5S

PAGE: 1 of 1

TOTAL DEPTH: 30 FEET BELOW GROUND SURFACE (BGS)

CLIENT: AMERICAN ELECTRIC POWER

PROJECT: NE PLANT LANDFILL

JOB NO.: 216-003-35087115-022

DRILLING CO.: MOHAWK

LOGGED BY: CLANCY McCLINTOCK

DRILLER: KEVIN

DATE DRILLED: 9/30/08

RIG TYPE: STRATASTAR 25/CME 55

DRILLING METHOD: HOLLOW STEM AUGER

SAMPLING METHOD: SPLIT SPOON/NX ROCK CORE



Consulting Engineers and Scientists

25809 Interstate-30
PH. (501) 847-9292BRYANT, AR 72022
FAX. (501) 847-9210

FIELD BORING LOG

BORING NO.: MW-6D

PAGE: 1 of 2

TOTAL DEPTH: 57 FEET BELOW GROUND SURFACE (BGS)

CLIENT: AMERICAN ELECTRIC POWER

PROJECT: NE PLANT LANDFILL

JOB NO.: 216-003-35087115-023

DRILLING CO.: MOHAWK

LOGGED BY: CLANCY McCLINTOCK

DRILLER: KEVIN

DATE DRILLED: 10/2/08

RIG TYPE: STRASTAR 25/CME 55

DRILLING METHOD: HOLLOW STEM AUGER

SAMPLING METHOD: SPLIT SPOON/NX ROCK CORE

Depth Elev.	BGS	N: 36° 24' 54.41" E: 95° 41' 51.01" G.S. ELEV. 633.72	DESCRIPTION	Litho. Symbol	Run #	% Recovery	RQD	Blow Count per 0.5'	Remarks
0		0'-12' GRAVELLY CLAY red to brown with orange mottles, dry, some limestone fragments						7-6-5 6	
ST 5		Shelby Tube from 3'-5'						8-7-8 6	
ST 10		Shelby Tube from 8'-10'						9-10-7 6	
12		12'-15' ASH tan, wet						5-5-16 6	
15		15'-28.5' GRAVELLY CLAY red to brown, dry						12-12-13 6	
20								10-13-8 6	
25								7-7-5 6	
28.5		28.5'-33.5' LIMESTONE interbedded with thin shale beds						50+ 6	Wet at 28' PR=0.25 ft/min.
33.5		33.5'-57' SHALE dark gray with some thin fissile beds, hard & brittle			1	95	76		
35					2	100	83		



Consulting Engineers and Scientists

25809 Interstate-30
PH. (501) 847-9292BRYANT, AR 72022
FAX. (501) 847-9210**FIELD BORING LOG**

BORING NO.: MW-6D

PAGE: 2 of 2

TOTAL DEPTH: 57 FEET BELOW GROUND SURFACE (BGS)

Elev.	Depth BGS	DESCRIPTION	Litho. Symbol	Run #	% Recovery	RQD	Blow Count per 0.5'	Remarks
	40			3	100	90		
	45			4	100	67		
	50			5	100	92		
	55							
	60	Total Depth = 57'						
	65							
	70							
	75							
	80							
	85							
	90							
	95							



Consulting Engineers and Scientists

25809 Interstate-30
PH (501) 847-9292

BRYANT, AR, 72022

FAX (501) 847-9210

FIELD BORING LOG

BORING NO.: MW-6S

PAGE: 1 of 1

TOTAL DEPTH: 25 FEET BELOW GROUND SURFACE (BGS)

CLIENT: AMERICAN ELECTRIC POWER

PROJECT: NE PLANT LANDFILL

JOB NO.: 216-003-35087115-024

DRILLING CO.: MOHAWK

LOGGED BY: CLANCY McCLINTOCK

DRILLER: KEVIN

DATE DRILLED: 10/6/08

RIG TYPE: STRATASTAR 25/CME 55

DRILLING METHOD: HOLLOW STEM AUGER

SAMPLING METHOD: SPLIT SPOON/NX ROCK CORE



Consulting Engineers and Scientists

25809 Interstate-30
PH. (501) 847-9292BRYANT, AR. 72022
FAX. (501) 847-9210

FIELD BORING LOG

BORING NO.: MW-7D

PAGE: 1 of 2

TOTAL DEPTH: 55 FEET BELOW GROUND SURFACE (BGS)

CLIENT: AMERICAN ELECTRIC POWER

PROJECT: NE PLANT LANDFILL

JOB NO.: 216-003-35087115-025

DRILLING CO.: MOHAWK

LOGGED BY: CLANCY McCLINTOCK

DRILLER: KEVIN

DATE DRILLED: 10/9/08

RIG TYPE: STRASTAR 25/CME 55

DRILLING METHOD: HOLLOW STEM AUGER

SAMPLING METHOD: SPLIT SPOON/NX ROCK CORE

Depth Elev.	BGS	DESCRIPTION	Litho. Symbol	Run #	% Recovery	RQD	Blow Count per 0.5'	Remarks
0	0'-16.5'	GRAVELLY CLAY gray and red, mottled, wet						
5								
ST		Shelby Tube from 8'-10', dry						
10								
15								
		16.5'-38' LIMESTONE dark gray, fossiliferous, some thin shale bedding						
20								
25								
30								
35								
		38'-55' SHALE dark gray with intermittent limestone beds						



Consulting Engineers and Scientists

25809 Interstate-30
PH. (501) 847-9292BRYANT, AR 72022
FAX. (501) 847-9210

FIELD BORING LOG

BORING NO.: MW-7D

PAGE: 2 of 2

TOTAL DEPTH: 55 FEET BELOW GROUND SURFACE (BGS)

Elev.	Depth BGS	DESCRIPTION	Litho. Symbol	Run #	% Recovery	RQD	Blow Count per 0.5'	Remarks
	40			5	100	88		
	45			6	100	87		
	50			7	100	91		
	55	Total Depth = 55'						
	60							
	65							
	70							
	75							
	80							
	85							
	90							
	95							



Consulting Engineers and Scientists

25809 Interstate-30
PH (501) 847-9292

BRYANT, AR, 72022

FAX (501) 847-9210

FIELD BORING LOG

BORING NO.: MW-7S

PAGE: 1 of 1

TOTAL DEPTH: 30 FEET BELOW GROUND SURFACE (BGS)

CLIENT: AMERICAN ELECTRIC POWER

PROJECT: NE PLANT LANDFILL

JOB NO.: 216-003-35087115-026

DRILLING CO.: MOHAWK

LOGGED BY: CLANCY McCLINTOCK

DRILLER: KEVIN

DATE DRILLED: 10/2/08

RIG TYPE: STRATASTAR 25/CME 55

DRILLING METHOD: HOLLOW STEM AUGER

SAMPLING METHOD: SPLIT SPOON/NX ROCK CORE



Consulting Engineers and Scientists

25809 Interstate-30
PH. (501) 847-9292BRYANT, AR 72022
FAX. (501) 847-9210

FIELD BORING LOG

BORING NO.: MW-8D

PAGE: 1 of 2

TOTAL DEPTH: 60 FEET BELOW GROUND SURFACE (BGS)

CLIENT: AMERICAN ELECTRIC POWER

PROJECT: NE PLANT LANDFILL

JOB NO.: 216-003-35087115-027

DRILLING CO.: MOHAWK

LOGGED BY: CLANCY McCLINTOCK

DRILLER: KEVIN

DATE DRILLED: 10/13/08

RIG TYPE: STRASTAR 25/CME 55

DRILLING METHOD: HOLLOW STEM AUGER

SAMPLING METHOD: SPLIT SPOON/NX ROCK CORE

Elev. Depth BGS	DESCRIPTION	Litho. Symbol	Run #	% Recovery	RQD	Blow Count per 0.5'	Remarks
0	0'-43' LIMESTONE light gray to dark gray, crystalline, some bedding plane fractures, fossiliferous, shale beds becoming thicker at 29'					5-17-50+ 6	
5			1	90	79		
10			2	90	79		
15			3	100	79		
20			4	100	79		
25			5	100	79		
30			6	100	79		
35			7	100	79		
			8	100	79		
			9	100	79		



Consulting Engineers and Scientists

25809 Interstate-30
PH. (501) 847-9292BRYANT, AR 72022
FAX. (501) 847-9210

FIELD BORING LOG

BORING NO.: MW-8D

PAGE: 2 of 2

TOTAL DEPTH: 60 FEET BELOW GROUND SURFACE (BGS)

Elev.	Depth BGS	DESCRIPTION	Litho. Symbol	Run #	% Recovery	RQD	Blow Count per 0.5'	Remarks
	40			10	100	66		
	43'-60' SHALE dark gray, some mud seams, wet			11	100	68		Wet at 45'
	45			12	100	83		
	50			13	100	78		
	55							
	60	Total Depth = 60'						
	65							
	70							
	75							
	80							
	85							
	90							
	95							



Consulting Engineers and Scientists

25809 Interstate-30
PH. (501) 847-9292BRYANT, AR 72022
FAX. (501) 847-9210

FIELD BORING LOG

BORING NO.: MW-8S

PAGE: 1 of 1

TOTAL DEPTH: 40 FEET BELOW GROUND SURFACE (BGS)

CLIENT: AMERICAN ELECTRIC POWER

PROJECT: NE PLANT LANDFILL

JOB NO.: 216-003-35087115-028

DRILLING CO.: MOHAWK

LOGGED BY: CLANCY McCLINTOCK

DRILLER: KEVIN

DATE DRILLED: 10/15/08

RIG TYPE: STRASTAR 25/CME 55

DRILLING METHOD: HOLLOW STEM AUGER

SAMPLING METHOD: SPLIT SPOON/NX ROCK CORE

Depth Elev.	BGS	DESCRIPTION	Litho. Symbol	Run #	% Recovery	RQD	Blow Count per 0.5'	Remarks
0	0'-40'	LIMESTONE light gray, crystalline, dry with bedding plane fractures		1	85	10		
5				2	80	9		
10				3	100	93		
15				4	95	90		
20								
25								
30								
35								
		Total Depth = 40'						

Terracon

Consulting Engineers and Scientists

25809 Interstate-30
PH. (501) 847-9292

BRYANT, AR 72022
FAX. (501) 847-9210

FIELD BORING LOG

BORING NO.: MW-9S

PAGE: 1 of 1

TOTAL DEPTH: 33.5 FEET BELOW GROUND SURFACE (BGS)

CLIENT: AMERICAN ELECTRIC POWER

PROJECT: NE PLANT LANDFILL

JOB NO.: 216-003-35107060-002

DRILLING CO.: MOHAWK

LOGGED BY: CLANCY McCLINTOCK

DRILLER: KEVIN WILKIE

DATE DRILLED: 4/7/2010

RIG TYPE: GEFco

DRILLING METHOD: HOLLOW STEM AUGER

SAMPLING METHOD: SPLIT SPOON

	N: -8587.14	E: 1916.816	G.S. ELEV. 633.98	Litho. Symbol	Run #	% Recovery	RQD	Blow Count per 0.5'	Remarks
	DESCRIPTION								
Depth Elev. BGS									
633.98	0	0'-10.5' GRAVELLY CLAY brown, silty, soft, dry	HSA						
628.98	5							5' - 6.5' 5-11-20 13	
623.98	10	10.5'-20' ASH tan, slightly gravelly, soft, moist						10' - 11.5' 7-12-10 15	Moist at 10.5'
618.98	15							15' - 16.5' 18-17-50/2 15	Hard layer from 16.5' - 17'
613.98	20	20'-26' ASH tan, slightly gravelly, soft, wet						20' - 21.5' 9-13-7 18	Wet at 20'
608.98	25	26'-28.5' ASH dark brown, slightly gravelly, soft, wet						25' - 26.5' 15-40-50/4 15	
603.98	30	28.5'-33.5' HSA - SHALE							Resistance at 28.5' (shale)
	35	Total Depth of Boring = 33.5' bgs							

Terracon

Consulting Engineers and Scientists

25809 Interstate-30
PH. (501) 847-9292

BRYANT, AR. 72022
FAX. (501) 847-9210

FIELD BORING LOG

BORING NO.: MW-9D

PAGE: 1 of 2

TOTAL DEPTH: 60 FEET BELOW GROUND SURFACE (BGS)

CLIENT: AMERICAN ELECTRIC POWER

PROJECT: NE PLANT LANDFILL

JOB NO.: 216-003-35107060-001

DRILLING CO.: MOHAWK

LOGGED BY: CLANCY McCLINTOCK

DRILLER: KEVIN WILKIE

DATE DRILLED: 4/6/2010

RIG TYPE: GEFco

DRILLING METHOD: HOLLOW STEM AUGER, AIR HAMMER, WIRE LINE CORING WITH AIR

SAMPLING METHOD: SPLIT SPOON & WIRE LINE CORING

Depth Elev. BGS	N: -8597.75 E: 1910.436 G.S. ELEV. 633.90	DESCRIPTION	Litho. Symbol	Run #	% Recovery	RQD	Blow Count per 0.5'	Remarks
633.90	0	0'-5' GRAVELLY CLAY brown, slightly silty, soft, dry	HSA					
628.90	5	5'-10.5' GRAVELLY CLAY brown, slightly silty, soft, dry (gravel becoming larger)					5' - 6.5' 3-5-7 15	
623.90	10	10.5'-12' ASH gray to tan, slightly gravelly, soft, wet					10' - 11.5' 7-7-8 16	Wet at 10.5'
618.90	15	12'-20.5' ASH tan, slightly gravelly, soft, wet					15' - 16.5' 27-22-50/0.5 18	Hard layer from 16' - 17'
613.90	20	20.5'-21' COAL black					20' - 21.5' 10-10-4 18	Wet at 21'
608.90	25	21'-26.5' ASH tan, slightly gravelly, soft, wet					25' - 26.5' 9-21-18 18	
603.90	30	26.5'-27' SANDY SHALE gray 27'-28.5' CLAY brown, slightly gravelly, soft, wet 28.5'-30' HSA - SHALE dark gray						Resistance at 28.5' (shale)
598.90	35	30'-38' SHALE dark gray, thin horizontal bedding, some fossils present	WLC	30' - 38' 1	100	93		ROP=0.5ft/min.
		38'-40' SHALE dark gray, thin horizontal bedding, some fossils present		2	80	64		



Consulting Engineers and Scientists

25809 Interstate-30
PH. (501) 847-9292BRYANT, AR 72022
FAX. (501) 847-9210

FIELD BORING LOG

BORING NO.: MW-9D

PAGE: 2 of 2

TOTAL DEPTH: 60 FEET BELOW GROUND SURFACE (BGS)

Elev.	Depth BGS	DESCRIPTION	Litho. Symbol	Run #	% Recovery	RQD	Blow Count per 0.5'	Remarks
593.90	40	40'-60' <u>SHALE</u> dark gray, thin horizontal bedding, some fossils present		38' - 48' 2	80	64		ROP=0.25ft/min.
588.90	45							
583.90	50			48' - 58' 3	100	96		ROP=0.5ft/min.
578.90	55							
573.90	60	Over drill to 60' with air hammer Total Depth of Boring = 60' bgs						
	65							
	70							
	75							
	80							
	85							
	90							
	95							



25809 Interstate-30
PH. (501) 847-9292

BRYANT, AR. 72022
FAX. (501) 847-9210

FIELD BORING LOG

BORING NO.: MW-10D

PAGE: 1 of 2

TOTAL DEPTH: 68 FEET BELOW GROUND SURFACE (BGS)

CLIENT: AMERICAN ELECTRIC POWER

PROJECT: NE PLANT LANDFILL

JOB NO.: 216-003-35107060-003

DRILLING CO.: MOHAWK

LOGGED BY: CLANCY McCLINTOCK

DRILLER: KEVIN WILKIE

DATE DRILLED: 4/7/2010 thru 4/9/2010

RIG TYPE: GEFco

DRILLING METHOD: AIR HAMMER, WIRE LINE CORING WITH AIR

SAMPLING METHOD: WIRE LINE CORING

	N: -7762.059	E: 764.463	G.S. ELEV. 636.14	Litho. Symbol	Run #	% Recovery	RQD	Blow Count per 0.5'	Remarks
	DESCRIPTION								
Depth Elev.	BGS								
636.14	0	0'-3' <u>TOPSOIL</u> black	HSA						HSA: 0' - 3' AIR HAMMER: 3' - 68'
631.14	5	3'-22' <u>LIMESTONE</u> light gray, fine graded, micritic, fossils and calcite crystals present, massive bedding, mostly horizontal bedding, some angular bedding @ ~30°	WLC		3' - 13' 1	90	76		WLC: 3' - 68' Resistance at 3' ROP=0.5ft/min.
626.14	10								
621.14	15				13' - 23' 2	100	94		
616.14	20								ROP=0.5ft/min.
611.14	25	22'-32' <u>LIMESTONE</u> becoming more gray, fine graded, micritic, fossils and calcite crystals present, massive bedding, mostly horizontal bedding present, massive bedding, mostly horizontal bedding, some angular bedding @ ~30°							
606.14	30	24' - 32' Becoming weathered and fossil increase 29' - 30' Highly weakened zone			23' - 33' 3	100	80		ROP=0.5ft/min. Wet at 29' - 30'
601.14	35	31' - 35' Thin shale layers in Limestone 32'-46' <u>LIMESTONE</u> gray, crystalline, fossils and calcite crystals present, bedding becoming thinner, moist between bedding planes, some small cavities with calcite crystal growth			33' - 46' 4	80	52		ROP=0.5ft/min.



Consulting Engineers and Scientists

25809 Interstate-30
PH. (501) 847-9292BRYANT, AR 72022
FAX. (501) 847-9210**FIELD BORING LOG**

BORING NO.: MW-10D

PAGE: 2 of 2

TOTAL DEPTH: 68 FEET BELOW GROUND SURFACE (BGS)

Elev.	Depth BGS	DESCRIPTION	Litho. Symbol	Run #	% Recovery	RQD	Blow Count per 0.5'	Remarks
596.14	40	32'-46' <u>LIMESTONE</u> gray, crystalline, fossils and calcite crystals present, bedding becoming thinner, moist between bedding planes, some small cavities with calcite crystal growth		33' - 46' 4	80	52		ROP=0.5ft/min.
591.14	45	46'-68' <u>SHALE</u> dark gray to black, few fossils, thin bedding, H.C. odor, dry, hard		46' - 53' 5	95	61		ROP=0.5ft/min.
586.14	50			53' - 63' 6	98	85		ROP=0.5ft/min.
581.14	55			63' - 68' 7	95	48		ROP=0.25ft/min.
576.14	60	Total Depth of Boring = 68' bgs						
571.14	65							
	70							
	75							
	80							
	85							
	90							
	95							



Consulting Engineers and Scientists

25809 Interstate-30
PH. (501) 847-9292BRYANT, AR. 72022
FAX. (501) 847-9210

FIELD BORING LOG

BORING NO.: MW-10S

PAGE: 1 of 1

TOTAL DEPTH: 33 FEET BELOW GROUND SURFACE (BGS)

CLIENT: AMERICAN ELECTRIC POWER

PROJECT: NE PLANT LANDFILL

JOB NO.: 216-003-35107060-004

DRILLING CO.: MOHAWK

LOGGED BY: CLANCY McCLINTOCK

DRILLER: KEVIN WILKIE

DATE DRILLED: 4/12/2010 & 4/13/2010

RIG TYPE: GEFco

DRILLING METHOD: AIR HAMMER, WIRE LINE CORING WITH AIR

SAMPLING METHOD: WIRE LINE CORING

Depth Elev. BGS	N: -7751.238 E: 763.103 G.S. ELEV. 636.36	DESCRIPTION	Litho. Symbol	Run #	% Recovery	RQD	Blow Count per 0.5'	Remarks
636.36	0	0'-3' <u>TOPSOIL</u> brown with silty clay	HSA					
631.36	5	3'-10' <u>LIMESTONE</u> gray, some fossils, micritic, massive bedding, dry	WLC					
626.36	10	10'-33' <u>LIMESTONE</u> gray, crystalline, some fossils, micritic, massive bedding, moist between bedding planes		3' - 13' 1	90	62		ROP=0.25ft/min.
621.36	15			13' - 23' 2	100	100		ROP=0.25ft/min.
616.36	20							
611.36	25	26' - 33' Becomes weathered between bedding planes and becomes a darker gray		23' - 33' 3	100	64		ROP=0.5ft/min.
606.36	30							
	35	Total Depth of Boring = 33' bgs						



Consulting Engineers and Scientists

25809 Interstate-30
PH. (501) 847-9292BRYANT, AR 72022
FAX. (501) 847-9210

FIELD BORING LOG

BORING NO.: MW-11D

PAGE: 1 of 1

TOTAL DEPTH: 48 FEET BELOW GROUND SURFACE (BGS)

CLIENT: AMERICAN ELECTRIC POWER

PROJECT: NE PLANT LANDFILL

JOB NO.: 216-003-35107060-005

DRILLING CO.: MOHAWK

LOGGED BY: CLANCY McCLINTOCK

DRILLER: KEVIN WILKIE

DATE DRILLED: 4/13/2010 / 4/14/2010

RIG TYPE: GEFco

DRILLING METHOD: AIR HAMMER, WIRE LINE CORING WITH AIR

SAMPLING METHOD: WIRE LINE CORING

Depth Elev.	BGS	N: -8419.377 E: 935.471 G.S. ELEV. 625.97	DESCRIPTION	Litho. Symbol	Run #	% Recovery	RQD	Blow Count per 0.5'	Remarks
625.97	0	0'-3' <u>LIMESTONE</u>	WLC						AIR HAMMER: 0' - 3' & 3' - 48' WLC: 3' - 48'
620.97	5	3'-27' <u>LIMESTONE</u> gray, crystalline, lots of fossils, calcite crystals, hard, few small cavities with crystal growth			3' - 13' 1	100	75		ROP=0.25ft/min.
615.97	10								Moist at 10'
610.97	15	26' - 33' Becomes weathered between bedding planes and becomes a darker gray			13' - 23' 2	100	83		ROP=0.25ft/min.
605.97	20								
600.97	25								
595.97	30	27'-32' <u>LIMESTONE</u> dark gray, some fossils, micritic, thin interlayered shale in LS			23' - 33' 3	90	33		ROP=0.25ft/min.
590.97	35	32'-48' <u>SHALE</u> dark gray to black, some fossils, thin bedding			33' - 43' 4	100	71		ROP=0.25ft/min.



Consulting Engineers and Scientists

25809 Interstate-30
PH. (501) 847-9292BRYANT, AR 72022
FAX. (501) 847-9210

FIELD BORING LOG

BORING NO.: MW-11D

PAGE: 2 of 2

TOTAL DEPTH: 48 FEET BELOW GROUND SURFACE (BGS)

Elev.	Depth BGS	DESCRIPTION	Litho. Symbol	Run #	% Recovery	RQD	Blow Count per 0.5'	Remarks
585.97	40			33' - 43' 4	100	71		ROP=0.25ft/min.
580.97	45			43' - 48' 5	100	91		ROP=0.25ft/min.
	50	Total Depth of Boring = 48' bgs						
	55							
	60							
	65							
	70							
	75							
	80							
	85							
	90							
	95							



Consulting Engineers and Scientists

25809 Interstate-30
PH (501) 847-9292

BRYANT, AR. 72022

FIELD BORING LOG

BORING NO.: MW-11S

PAGE: 1 of 1

TOTAL DEPTH: 28 **FEET BELOW GROUND SURFACE (BGS)**

CLIENT: AMERICAN ELECTRIC POWER			PROJECT: NE PLANT LANDFILL											
JOB NO.: 216-003-35107060-006			DRILLING CO.: MOHAWK											
LOGGED BY: CLANCY McCLINTOCK			DRILLER: KEVIN WILKIE											
DATE DRILLED: 4/14/2010 / 4/15/2010			RIG TYPE: GEFco											
DRILLING METHOD: AIR HAMMER, WIRE LINE CORING WITH AIR														
SAMPLING METHOD: WIRE LINE CORING														
	N: -8429.094	E: 938.143	G.S. ELEV. 625.91	Litho. Symbol	Run #	% Recovery	RQD	Blow Count per 0.5'	Remarks					
Elev.	Depth BGS	DESCRIPTION												
625.91	0	0'-1.5' <u>LIMESTONE</u>		WLC					AIR HAMMER: 0' - 1.5' & 1.5' - 28' WLC: 1.5' - 28'					
620.91	5	1.5'-10' <u>LIMESTONE</u> gray, crystalline, lots of fossils, calcite crystals, crystal growth in cavities			1.5' - 12' 1	80	31		Water in hole while drilling with Air hammer					
615.91	10	10' - 18' thin bedding, increase in fossils and calcite crystals, very hard			12' - 18' 2	50	0							
610.91	15				18' - 23' 3	25	0							
605.91	20	18' - 28' a few thin interbedded shale layers			23' - 28' 4	80	36		ROP=0.25ft/min.					
	25													
	30	Total Depth of Boring = 28' bgs												
	35													



25809 Interstate-30
PH. (501) 847-9292

BRYANT, AR. 72022
FAX. (501) 847-9210

FIELD BORING LOG

BORING NO.: MW-12D

PAGE: 1 of 2

TOTAL DEPTH: 42 FEET BELOW GROUND SURFACE (BGS)

CLIENT: AMERICAN ELECTRIC POWER

PROJECT: NE PLANT LANDFILL

JOB NO.: 216-003-35107060-007

DRILLING CO.: MOHAWK

LOGGED BY: CLANCY McCLINTOCK

DRILLER: KEVIN WILKIE

DATE DRILLED: 4/15/2010 / 4/16/2010 / 4/19/2010

RIG TYPE: GEFco

DRILLING METHOD: AIR HAMMER, WIRE LINE CORING WITH AIR

SAMPLING METHOD: WIRE LINE CORING

	N: -8778.028	E: 1088.459	G.S. ELEV. 620.91	Litho. Symbol	Run #	% Recovery	RQD	Blow Count per 0.5'	Remarks
	DESCRIPTION								
Depth Elev.	BGS								
620.91	0	0'-2' <u>LIMESTONE</u>		[WLC]					AIR HAMMER: 0' - 2' & 2' - 42' WLC: 2' - 42'
615.91	5	2'-11' <u>LIMESTONE</u> gray, crystalline, high fossil content, calcite crystal growth, dry			2' - 7' 1	95	15		ROP=0.1ft/min.
610.91	10	11' - 19' Becoming a darker gray 11' - 22' Very thin shale layers interbedded in limestone			7' - 12' 2	90	51		
605.91	15								
600.91	20	19'-22' <u>LIMESTONE</u> dark gray, becoming very crystalline, thin bedding, high fossil content, brittle			12' - 22' 3	95	29		
595.91	25	22'-42' <u>SHALE</u> dark gray, few fossils, natural gas odor			22' - 28' 4	100	74		Water at 32'
590.91	30				28' - 32' 5	100	80		
585.91	35				32' - 42' 6	95	94		



Consulting Engineers and Scientists

25809 Interstate-30
PH. (501) 847-9292BRYANT, AR 72022
FAX. (501) 847-9210

FIELD BORING LOG

BORING NO.: MW-12D

PAGE: 2 of 2

TOTAL DEPTH: 42 FEET BELOW GROUND SURFACE (BGS)

Elev.	Depth BGS	DESCRIPTION	Litho. Symbol	Run #	% Recovery	RQD	Blow Count per 0.5'	Remarks
580.91	40			32' - 42' 6	95	94		ROP=0.1ft/min.
	45	Total Depth of Boring = 42' bgs						
	50							
	55							
	60							
	65							
	70							
	75							
	80							
	85							
	90							
	95							



Consulting Engineers and Scientists

25809 Interstate-30
PH. (501) 847-9292BRYANT, AR. 72022
FAX. (501) 847-9210

FIELD BORING LOG

BORING NO.: MW-12S

PAGE: 1 of 1

TOTAL DEPTH: 20 FEET BELOW GROUND SURFACE (BGS)

CLIENT: AMERICAN ELECTRIC POWER

PROJECT: NE PLANT LANDFILL

JOB NO.: 216-003-35107060-008

DRILLING CO.: MOHAWK

LOGGED BY: CLANCY McCLINTOCK

DRILLER: KEVIN WILKIE

DATE DRILLED: 4/19/2010

RIG TYPE: GEFco

DRILLING METHOD: AIR HAMMER, WIRE LINE CORING WITH AIR

SAMPLING METHOD: WIRE LINE CORING

Depth Elev. BGS	N: -8786.771 E: 1083.029 G.S. ELEV. 620.65	DESCRIPTION	Litho. Symbol	Run #	% Recovery	RQD	Blow Count per 0.5'	Remarks
620.65	0	0'-5' <u>LIMESTONE</u> [WLC]						AIR HAMMER: 0' - 5' & 5' - 20' WLC: 5' - 20'
615.65	5	5'-13.5' <u>LIMESTONE</u> gray, crystalline, high fossil content, calcite crystal growth in a few cavities, dry		5' - 13' 1	38	17		
610.65	10							
605.65	15	13.5'-20' <u>LIMESTONE</u> dark gray, some calcite crystal growth, few fossils, few thin interbedded shale layers, dry		13' - 18' 2	80	62		
600.65	20	Total Depth of Boring = 20' bgs		18' - 20' 3	100	83		
	25							
	30							
	35							



Consulting Engineers and Scientists

25809 Interstate-30
PH. (501) 847-9292BRYANT, AR. 72022
FAX. (501) 847-9210

FIELD BORING LOG

BORING NO.: MW-13D

PAGE: 1 of 2

TOTAL DEPTH: 45 FEET BELOW GROUND SURFACE (BGS)

CLIENT: AMERICAN ELECTRIC POWER

PROJECT: NE PLANT LANDFILL

JOB NO.: 216-003-35107060-009

DRILLING CO.: MOHAWK

LOGGED BY: CLANCY McCLINTOCK

DRILLER: KEVIN WILKIE

DATE DRILLED: 4/20/2010

RIG TYPE: GEFco

DRILLING METHOD: AIR HAMMER, WIRE LINE CORING WITH AIR

SAMPLING METHOD: WIRE LINE CORING

Depth Elev. BGS	N: -9108.428 E: 1354.192 G.S. ELEV. 616.11	DESCRIPTION	Litho. Symbol	Run #	% Recovery	RQD	Blow Count per 0.5'	Remarks
616.11	0	0'-4' <u>LIMESTONE</u>	[WLC]					AIR HAMMER: 0' - 4' & 4' - 45' WLC: 4' - 42'
611.11	5	4'-11' <u>LIMESTONE</u> dark gray, crystalline, fossils present, massive bedding, calcite crystal growth, biomicritic		4' - 11' 1	95	58		
606.11	10	11'-13' <u>LIMESTONE</u> gray, crystalline, high fossil content, dry						Very hard at 11' - 12' Switched to small air hammer (4") at 11' - 12'
601.11	15	13'-21' <u>SHALE</u> dark gray, HC odor, few fossils		11' - 22' 2	90	53		
596.11	20	21' - 42' Becoming darker and more fine		22' - 27' 3	100	90		
591.11	25			27' - 32' 4	100	100		
586.11	30			32' - 45' 5	95	78		
581.11	35							



Consulting Engineers and Scientists

25809 Interstate-30
PH. (501) 847-9292BRYANT, AR 72022
FAX. (501) 847-9210**FIELD BORING LOG**

BORING NO.: MW-13D

PAGE: 2 of 2

TOTAL DEPTH: 45 FEET BELOW GROUND SURFACE (BGS)

Elev.	Depth BGS	DESCRIPTION	Litho. Symbol	Run #	% Recovery	RQD	Blow Count per 0.5'	Remarks
576.11	40			32' - 42' 5	95	78		
	Air hammer to 45'							
571.11	45	Total Depth of Boring = 45' bgs						
	50							
	55							
	60							
	65							
	70							
	75							
	80							
	85							
	90							
	95							



Consulting Engineers and Scientists

25809 Interstate-30
PH. (501) 847-9292BRYANT, AR 72022
FAX. (501) 847-9210

FIELD BORING LOG

BORING NO.: MW-13S

PAGE: 1 of 1

TOTAL DEPTH: 15 FEET BELOW GROUND SURFACE (BGS)

CLIENT: AMERICAN ELECTRIC POWER

PROJECT: NE PLANT LANDFILL

JOB NO.: 216-003-35107060-010

DRILLING CO.: MOHAWK

LOGGED BY: CLANCY McCLINTOCK

DRILLER: KEVIN WILKIE

DATE DRILLED: 4/20/2010 & 4/21/2010

RIG TYPE: GEFco

DRILLING METHOD: AIR HAMMER, WIRE LINE CORING WITH AIR

SAMPLING METHOD: WIRE LINE CORING

Depth Elev. BGS	N: -9107.785 E: 1344.689 G.S. ELEV. 616.20	DESCRIPTION	Litho. Symbol	Run #	% Recovery	RQD	Blow Count per 0.5'	Remarks
616.20	0 - 3.5' <u>LIMESTONE</u>	WLC						AIR HAMMER: 0' - 3.5' & 3.5' - 15' WLC: 3.5' - 15'
611.20	3.5'-9' <u>LIMESTONE</u> gray, few fossils, micritic, calcite crystal growth, massive bedding, dry			3.5' - 8' 1	80	33		
606.20	9' - 10' Dark gray with interbedded thin shale layers 10' - 12.5' Gray with high fossil content, crystalline			8' - 13.5' 2	90	14		
601.20	12.5'-15' <u>SHALE</u> dark gray, limey			13.5' - 15' 3	100	51		
	Total Depth of Boring = 15' bgs							
	20							
	25							
	30							
	35							



Consulting Engineers and Scientists

25809 I-30 South
PH. (501) 847-9292BRYANT, AR 72022
FAX. (501) 847-9210

FIELD BORING LOG

BORING NO.: MW-14

PAGE: 1 of 1

TOTAL DEPTH: 76' FEET BELOW GROUND SURFACE (BGS)

CLIENT: AEP

PROJECT: NE - CCR WELL INSTALL

JOB NO.: 35157183

DRILLING CO.: AECI

LOGGED BY: RAH

DRILLER: GARY MOYERS

DATE DRILLED: 03/01/2016

RIG TYPE: CME 75 BUGGY

DRILLING METHOD: HSA / AIR ROTARY

SAMPLING METHOD: 5' CONTINUOUS SAMPLER, LOGGED BY CUTTINGS

N:	E:	G.S. ELEV.	Litho. Symbol	% Recovery	RQD	Remarks
DESCRIPTION						
Depth BGS						
0	0'-6' SILTY CLAY W/ LIMESTONE GRAVEL tan and gray clay w/intermittent gravel					
10	6'-43' SILTY CLAY W/ LIMESTONE GRAVEL crystalline to micritic					6' - 76' logged by cuttings
20						
30						
40						
50	43'-76' SHALE light gray to gray, hard					
60						
70						fracture @ 67' w/ moist cuttings
80	Total Depth of Boring at 76' bgs					BoB @ 76'



Consulting Engineers and Scientists

25809 I-30 South
PH. (501) 847-9292BRYANT, AR. 72022
FAX. (501) 847-9210

FIELD BORING LOG

BORING NO.: MW-15

PAGE: 1 of 1

TOTAL DEPTH: 71' FEET BELOW GROUND SURFACE (BGS)

CLIENT: AEP

PROJECT: NE - CCR WELL INSTALL

JOB NO.: 35157183

DRILLING CO.: AECI

LOGGED BY: RAH

DRILLER: GARY MOYERS

DATE DRILLED: 02/23/2016

RIG TYPE: CME 75 BUGGY

DRILLING METHOD: HSA / AIR ROTARY

SAMPLING METHOD: 5' CONTINUOUS SAMPLER, LOGGED BY CUTTINGS

N:	E:	G.S. ELEV.	Litho. Symbol	% Recovery	RQD	Remarks
DESCRIPTION						
Depth BGS						
0	0'-11' SILTY, GRAVELLY, CLAY FILL brown and red					
10	11'-15' ASH tan, fine and dry					
15	15'-27' SILTY CLAY W/ ZONES OF GRAVELLY CLAY stiff, brown, dry					
27	27'-30' WEATHERED L.S. W/ GRAVELLY CLAY					
30	30'-41' L.S. crystalline, hard, light gray to gray					30' - 71' logged by cuttings
41	41'-71' SHALE hard, gray to dingy					
50						water not encountered while drilling
60						
70	Total Depth of Boring at 71' bgs					BoB @ 71'
80						



Consulting Engineers and Scientists

25809 I-30 South
PH. (501) 847-9292BRYANT, AR. 72022
FAX. (501) 847-9210

FIELD BORING LOG

BORING NO.: MW-16

PAGE: 1 of 1

TOTAL DEPTH: 61' FEET BELOW GROUND SURFACE (BGS)

CLIENT: AEP

PROJECT: NE - CCR WELL INSTALL

JOB NO.: 35157183

DRILLING CO.: AECI

LOGGED BY: RAH

DRILLER: GARY MOYERS

DATE DRILLED: 02/25/2016

RIG TYPE: CME 75 BUGGY

DRILLING METHOD: HSA / AIR ROTARY

SAMPLING METHOD: 5' CONTINUOUS SAMPLER, LOGGED BY CUTTING

Depth BGS	Sample Interval	N: E: DESCRIPTION	ELEV:	Litho. Symbol	Split Spoon Sample Interval	Recovery	Comments
0		0'-10' SILTY CLAY W/ SOME GRAVEL dark brown					
5							
10		10'-26' ASH tan, fine					moisture beginning @ 19'
15							
20							
25							
26		26'-27' SILTY CLAY dark gray to black					28' - 61' logged by cuttings
27		27'-28' clay w/ bentonite slurry greenish gray, dry					
28		28'-61' SHALE dark gray, hard					
30							
35							
40							
45							
50							
55							
60		Total Depth of Boring at 61' bgs					
65							



Consulting Engineers and Scientists

25809 I-30 South
PH. (501) 847-9292BRYANT, AR 72022
FAX. (501) 847-9210

FIELD BORING LOG

BORING NO.: MW-17

PAGE: 1 of 1

TOTAL DEPTH: 56' FEET BELOW GROUND SURFACE (BGS)

CLIENT: AEP

PROJECT: NE - CCR WELL INSTALL

JOB NO.: 35157183

DRILLING CO.: AECI

LOGGED BY: RAH

DRILLER: GARY MOYERS

DATE DRILLED: 02/29/2016

RIG TYPE: CME 75 BUGGY

DRILLING METHOD: HSA / AIR ROTARY

SAMPLING METHOD: 5' CONTINUOUS SAMPLER, LOGGED BY CUTTING

Depth BGS	Sample Interval	N: E: DESCRIPTION	ELEV:	Litho. Symbol	Split Spoon Sample Interval	Recovery	Comments
0		0'-12' SILTY, GRAVELLY CLAY FILL red and brown					
5							
10							
15		12'-13' ASH tan, fine and dry					
15		13'-25' SILTY CLAY W/ L.S. GRAVEL brown					
20							
25		25'-30' L.S. hard, light gray					25' - 56' logged by cuttings
30		30'-31' CLAY-FILLED ZONE moist					
35		31'-56' SHALE dark gray					fractures w/ moist cuttings@39',43',46',50'
40							
45							
50							
55							
60		Total Depth of Boring at 56' bgs					BoB @ 56'
65							



Consulting Engineers and Scientists

25809 Interstate-30
PH. (501) 847-9292BRYANT, AR 72022
FAX. (501) 847-9210

FIELD BORING LOG

BORING NO.: LP-1

PAGE: 1 of 1

TOTAL DEPTH: 28 FEET BELOW GROUND SURFACE (BGS)

CLIENT: AMERICAN ELECTRIC POWER

PROJECT: NE PLANT LANDFILL

JOB NO.: 216-003-35087115-029

DRILLING CO.: MOHAWK

LOGGED BY: MERRICK ROTENBERRY

DRILLER: KEVIN

DATE DRILLED: 10/17/08

RIG TYPE: CME 55

DRILLING METHOD: HOLLOW STEM AUGER

SAMPLING METHOD: SPLIT SPOON

Depth Elev. BGS	N: 36° 24' 53.23" E: 95° 41' 57.21" G.S. ELEV. 634.68	DESCRIPTION	Litho. Symbol	Run #	% Recovery	RQD	Blow Count per 0.5'	Remarks
0	0'-28' ASH tan to gray, alternating silty to hard layers						3,8,7 6"	
5							6,9,7 6"	
10							3,7,21 6"	
15	Soft						3,12,9 6"	
20	No recovery, soft						13,31,21 6"	
25	No recovery, soft						6,8,8 6"	Wet at 15'
30	Total Depth = 28'						6,5,2 6"	
35							1,2,4 6"	
							1,1,1 6"	Limestone at 28'



Consulting Engineers and Scientists

25809 Interstate-30
PH. (501) 847-9292BRYANT, AR 72022
FAX. (501) 847-9210

FIELD BORING LOG

BORING NO.: LP-2

PAGE: 1 of 1

TOTAL DEPTH: 30 FEET BELOW GROUND SURFACE (BGS)

CLIENT: AMERICAN ELECTRIC POWER

PROJECT: NE PLANT LANDFILL

JOB NO.: 216-003-35087115-030

DRILLING CO.: MOHAWK

LOGGED BY: MERRICK ROTENBERRY

DRILLER: KEVIN

DATE DRILLED: 10/15/08

RIG TYPE: CME 55

DRILLING METHOD: HOLLOW STEM AUGER

SAMPLING METHOD: SPLIT SPOON

Elev. Depth BGS	N: 36° 24' 59.19" E: 95° 41' 56.77" G.S. ELEV. 638.10	DESCRIPTION	Litho. Symbol	Run #	% Recovery	RQD	Blow Count per 0.5'	Remarks
0	0'-29' ASH tan to gray, alternating silty to hard layers						3,5,6 6"	
5							46,50+ 6"	
10							8,8,9 6"	
15							7,6,10 6"	
20	Soft						10,9,8 6"	Very moist at 12'
25							4,3,2 6"	
29							7,6,4 6"	Wet at 18'
30	29'-30' GRAVELLY CLAY dark brown, wet Total Depth = 30'						7,6,5 6"	
35							1,1,2 6"	
							2,2,4 6"	Limestone at 30'



Consulting Engineers and Scientists

25809 Interstate-30
PH. (501) 847-9292

BRYANT, AR. 72022

FAX. (501) 847-9210

FIELD BORING LOG

BORING NO.: LP-3

PAGE: 1 of 1

TOTAL DEPTH: 40 FEET BELOW GROUND SURFACE (BGS)

CLIENT: AMERICAN ELECTRIC POWER

PROJECT: NE PLANT LANDFILL

JOB NO.: 216-003-35087115-031

DRILLING CO.: MOHAWK

LOGGED BY: MERRICK ROTENBERRY

DRILLER: KEVIN

DATE DRILLED: 10/16/08

RIG TYPE: CME 55

DRILLING METHOD: HOLLOW STEM AUGER

SAMPLING METHOD: SPLIT SPOON

		N: 36° 24' 57.22"	E: 95° 41' 54.31"	G.S. ELEV. 649.39	Litho. Symbol	Run #	% Recovery	RQD	Blow Count per 0.5'	Remarks
		DESCRIPTION								
Elev.	Depth BGS									
	0	0'-38.5' ASH tan to gray, alternating silty to hard layers							4,3,4 6"	
	5								2,1,2 6"	
	10								2,2,2 6"	
	15								2,1,2 6"	
	20								4,8,10 6"	
	25								8,14,28 6"	
	30	Soft							4,2,1 6"	
	35								7,8,5 6"	
		38.5'-40' GRAVELLY CLAY dark brown							7,10,16 6"	Wet at 24'
									26,28,10 6"	
									1,2,2 6"	
									1 12"	
									0,1,2 6"	
		Total Depth = 40'			●	●				Limestone at 40'



Consulting Engineers and Scientists

25809 Interstate-30
PH. (501) 847-9292BRYANT, AR. 72022
FAX. (501) 847-9210

FIELD BORING LOG

BORING NO.: LP-4

PAGE: 1 of 1

TOTAL DEPTH: 21 FEET BELOW GROUND SURFACE (BGS)

CLIENT: AMERICAN ELECTRIC POWER

PROJECT: NE PLANT LANDFILL

JOB NO.: 216-003-35087115-032

DRILLING CO.: MOHAWK

LOGGED BY: MERRICK ROTENBERRY

DRILLER: KEVIN

DATE DRILLED: 10/15/08

RIG TYPE: CME 55

DRILLING METHOD: HOLLOW STEM AUGER

SAMPLING METHOD: SPLIT SPOON

Depth Elev. BGS	N: 36° 25' 03.55" E: 95° 41' 51.65" G.S. ELEV. 627.79	DESCRIPTION	Litho. Symbol	Run #	% Recovery	RQD	Blow Count per 0.5'	Remarks
0	0'-20.5' ASH tan to gray, alternating silty to hard layers						16,16,12 6"	
5							13,13,33 6"	
10	Soft						27,27,29 6"	
15							4,4,4 6"	
20	20.5'-21' GRAVELLY CLAY						1,1,1 6"	
	Total Depth = 21'						1,2,3 6"	
							3,3,4 6"	
							4,6,50+ 6"	
25								
30								
35								

Wet at 9'

Limestone at 21'



Consulting Engineers and Scientists

25809 Interstate-30
PH. (501) 847-9292BRYANT, AR 72022
FAX. (501) 847-9210

FIELD BORING LOG

BORING NO.: LP-5

PAGE: 1 of 1

TOTAL DEPTH: 27 FEET BELOW GROUND SURFACE (BGS)

CLIENT: AMERICAN ELECTRIC POWER

PROJECT: NE PLANT LANDFILL

JOB NO.: 216-003-35087115-033

DRILLING CO.: MOHAWK

LOGGED BY: MERRICK ROTENBERRY

DRILLER: KEVIN

DATE DRILLED: 10/16/08

RIG TYPE: CME 55

DRILLING METHOD: HOLLOW STEM AUGER

SAMPLING METHOD: SPLIT SPOON

Elev. Depth BGS	DESCRIPTION	Litho. Symbol	Run #	% Recovery	RQD	Blow Count per 0.5'	Remarks
0	0'-26' ASH tan to gray, alternating silty to hard layers					6,9,35 6"	No recovery
5						9,4,2 6"	
10						2,3,3 6" 6" 5,5,5	
15	Soft					8,9,9 6"	
20						6,12,29 6"	
25	26'-27' GRAVELLY CLAY					10,12,10 6" 26,50+ 6" 29,8,9 6"	
	Total Depth = 27'						Limestone at 27'
30							
35							



Consulting Engineers and Scientists

25809 Interstate-30
PH. (501) 847-9292BRYANT, AR 72022
FAX. (501) 847-9210

FIELD BORING LOG

BORING NO.: LP-6

PAGE: 1 of 1

TOTAL DEPTH: 16.5 FEET BELOW GROUND SURFACE (BGS)

CLIENT: AMERICAN ELECTRIC POWER

PROJECT: NE PLANT LANDFILL

JOB NO.: 216-003-35087115-034

DRILLING CO.: MOHAWK

LOGGED BY: MERRICK ROTENBERRY

DRILLER: KEVIN

DATE DRILLED: 10/16/08

RIG TYPE: CME 55

DRILLING METHOD: HOLLOW STEM AUGER


SAMPLING METHOD: SPLIT SPOON

	N: 36° 25' 03.97" E: 95° 41' 45.21" G.S. ELEV. 625.61	DESCRIPTION	Litho.	Run #	% Recovery	RQD	Blow Count per 0.5'	Remarks
			Symbol	#				
Depth Elev.	BGS							
	0	0'-15' ASH tan to gray, alternating silty to hard layers					2,5,7 6"	
	5						7,12,11 6"	
	10						16,50+ 6"	
	Soft						4,7,7 6"	
	15	15'-16.5' GRAVELLY CLAY					4,7,16 6"	
		Total Depth = 16.5'						
	20							
	25							
	30							
	35							

Monitoring Well Installation Logs

MONITORING WELL INSTALLATION RECORD

Job Name	AEP NORTHEASTERN PLANT LANDFILL	Well Number	MW-1
Job Number	35077150	Installation Date	2/19/08
Datum Elevation	638.89	Location	OOLOGAH, OK.
Datum for Water Level Measurement	T.O.C.	Surface Elevation	635.75
Screen Diameter & Material	2" PVC	Slot Size	0.01
Riser Diameter & Material	2" PVC	Borehole Diameter	6.25"
Granular Backfill Material	12-20 SAND	Terracon Representative	MERRICK ROTENBERRY
Drilling Method	AIR ROTARY	Drilling Contractor	MOHAWK

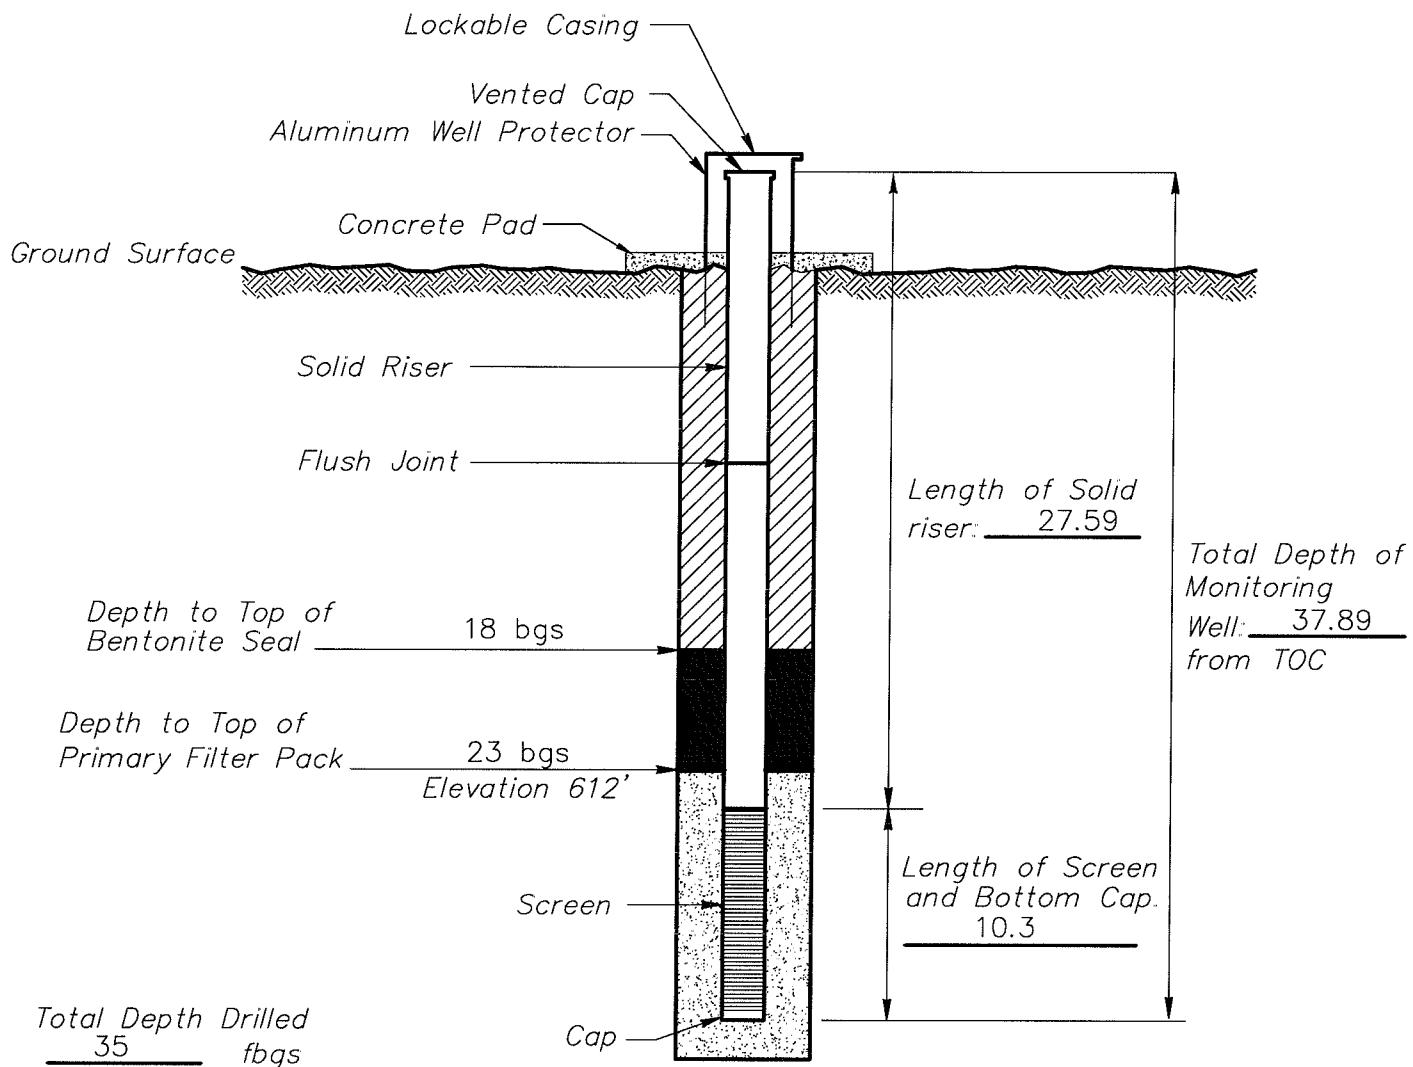

Bentonite Chips



Bentonite Plug



Granular Backfill

(Not to Scale)

Terracon
Consulting Engineers and Scientists

25809 I-30
PH. (501) 847-9292

BRYANT, AR 72022
FAX (501) 847-9210

MONITORING WELL INSTALLATION RECORD

PROJECT NUMBER: 216-003-35077150


WELL NUMBER: MW-1

DRAWING NUMBER: 015

CHECKED BY: MR

MONITORING WELL INSTALLATION RECORD

Job Name	AEP NORTHEASTERN PLANT LANDFILL	Well Number	MW-2
Job Number	35077150	Installation Date	3/4/08
Datum Elevation	638.19	Location	OOLOGAH, OK.
Datum for Water Level Measurement	T.O.C.	Surface Elevation	634.82
Screen Diameter & Material	2" PVC	Slot Size	0.01
Riser Diameter & Material	2" PVC	Borehole Diameter	6.25"
Granular Backfill Material	12-20 SAND	Terracon Representative	MERRICK ROTENBERRY
Drilling Method	AIR ROTARY	Drilling Contractor	MOHAWK

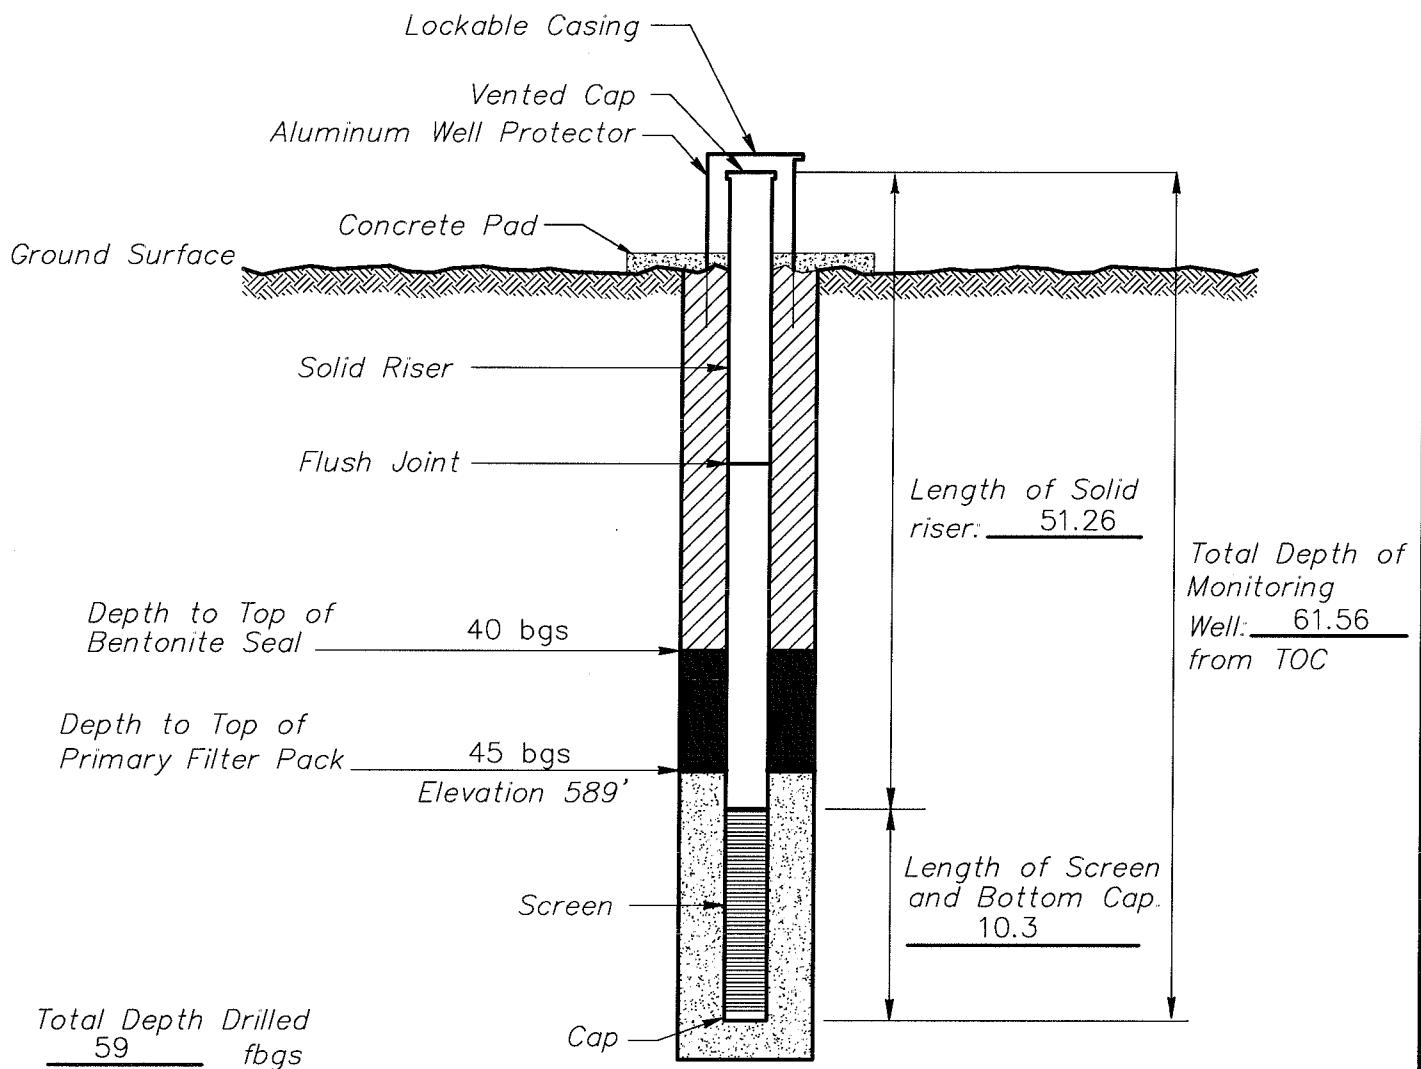

Bentonite Chips



Bentonite Plug



Granular Backfill

(Not to Scale)



25809 I-30
PH. (501) 847-9292

BRYANT, AR 72022
FAX. (501) 847-9210

MONITORING WELL INSTALLATION RECORD

PROJECT NUMBER: 216-003-35077150


WELL NUMBER: MW-2

DRAWING NUMBER: 016

CHECKED BY: MR

MONITORING WELL INSTALLATION RECORD

Job Name	AEP NORTHEASTERN PLANT LANDFILL	Well Number	MW-3
Job Number	35077150	Installation Date	2/21/08
Datum Elevation	630.65	Location	OOLOGAH, OK.
Datum for Water Level Measurement	T.O.C.	Surface Elevation	627.66
Screen Diameter & Material	2" PVC	Slot Size	0.01
Riser Diameter & Material	2" PVC	Borehole Diameter	6.25"
Granular Backfill Material	12-20 SAND	Terracon Representative	MERRICK ROTENBERRY
Drilling Method	AIR ROTARY	Drilling Contractor	MOHAWK

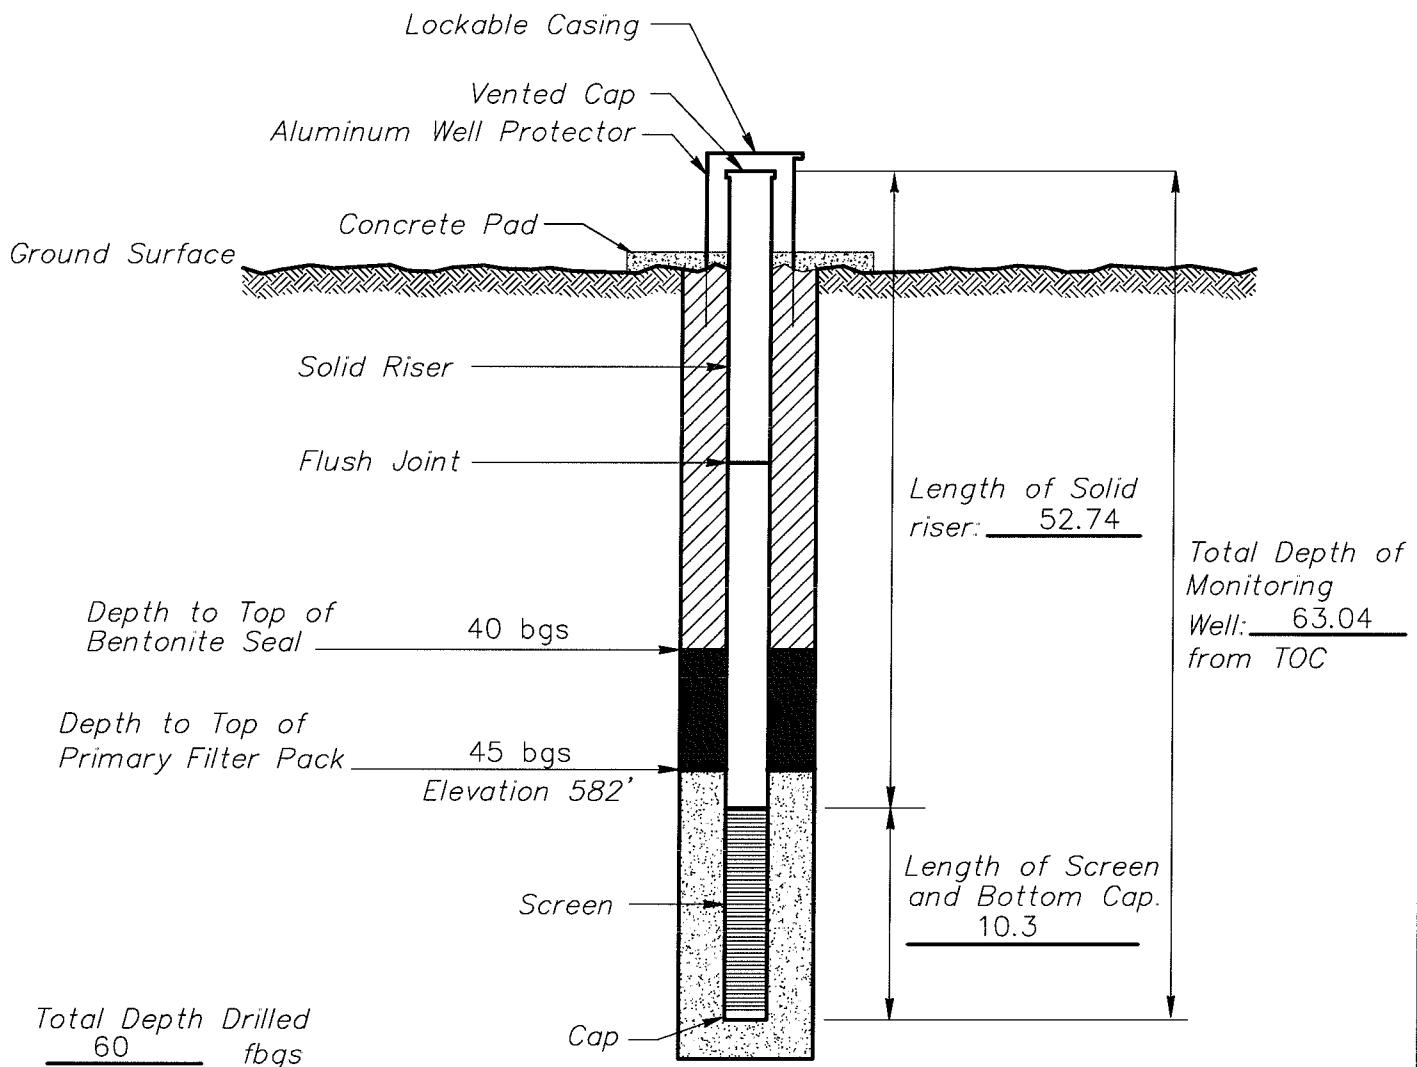

- Bentonite Chips
- Bentonite Plug
- Granular Backfill

(Not to Scale)

Terracon
Consulting Engineers and Scientists

25808 I-30
PH. (501) 847-9292

BRYANT, AR 72022
FAX. (501) 847-9210

MONITORING WELL INSTALLATION RECORD

PROJECT NUMBER: 216-003-35077150


WELL NUMBER: MW-3

DRAWING NUMBER: 017

CHECKED BY: MR

MONITORING WELL INSTALLATION RECORD

Job Name	AEP NORTHEASTERN PLANT LANDFILL	Well Number	MW-4
Job Number	35077150	Installation Date	2/22/08
Datum Elevation	625.00	Location	OOLOGAH, OK.
Datum for Water Level Measurement	T.O.C.	Surface Elevation	621.93
Screen Diameter & Material	2" PVC	Slot Size	0.01
Riser Diameter & Material	2" PVC	Borehole Diameter	6.25"
Granular Backfill Material	12-20 SAND	Terracon Representative	MERRICK ROTENBERRY
Drilling Method	AIR ROTARY	Drilling Contractor	MOHAWK

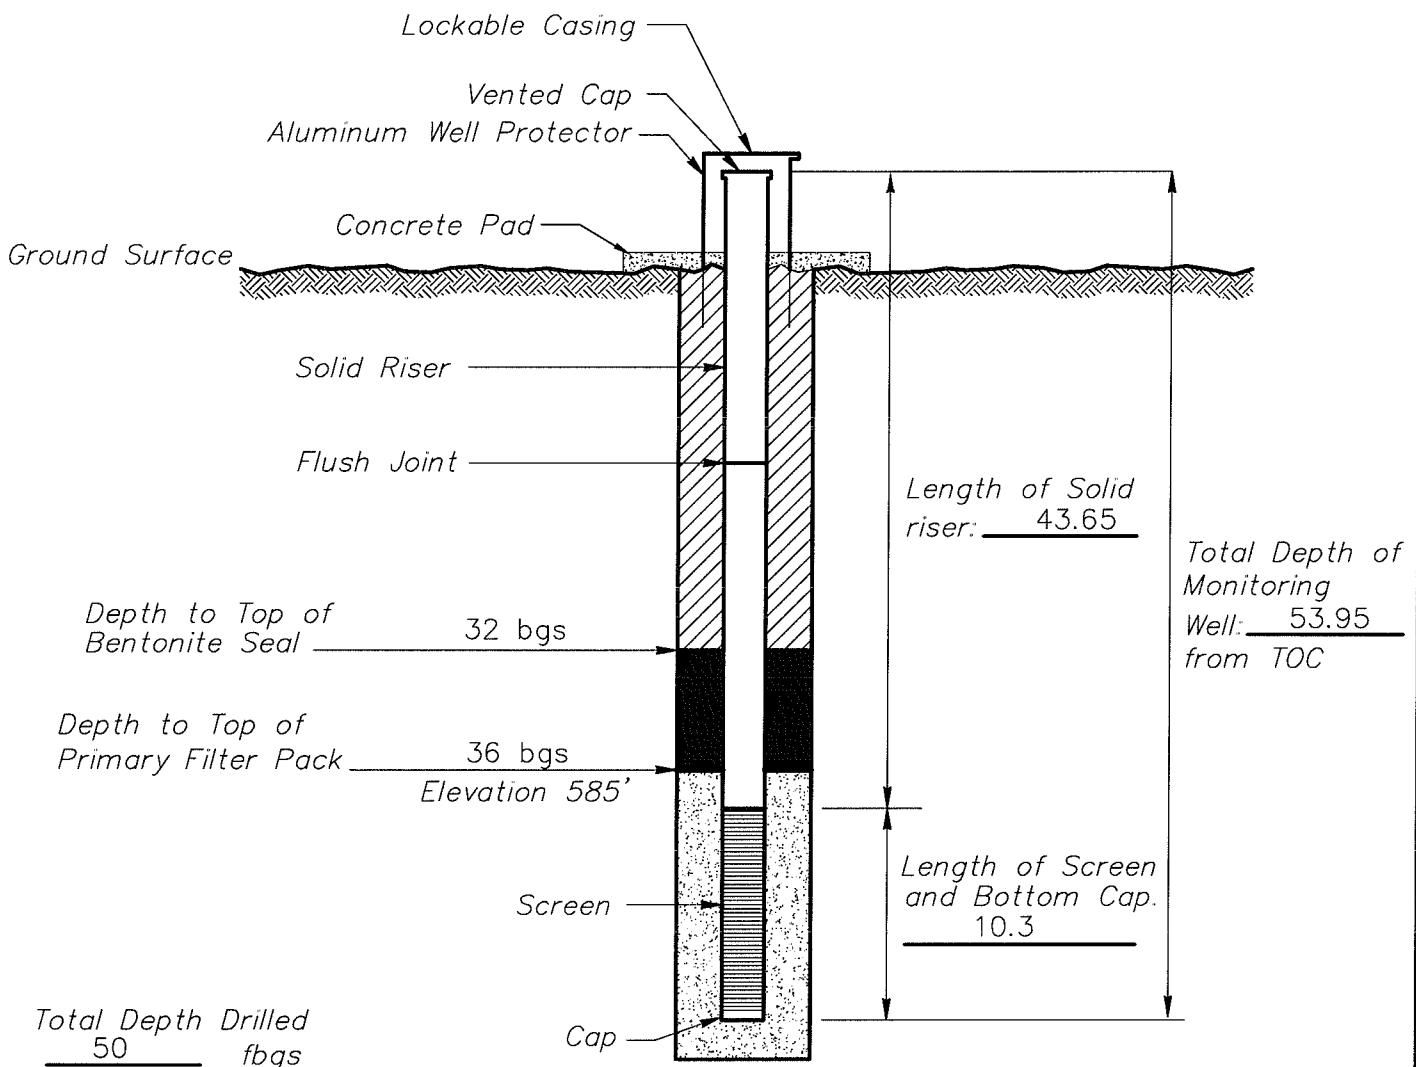

- Bentonite Chips
- Bentonite Plug
- Granular Backfill

Terracon
Consulting Engineers and Scientists

25809 I-30
PH. (501) 847-9292

BRYANT, AR 72022
FAX. (501) 847-9210

MONITORING WELL INSTALLATION RECORD

PROJECT NUMBER: 216-003-35077150


WELL NUMBER: MW-4

DRAWING NUMBER: 018

CHECKED BY: MR

MONITORING WELL INSTALLATION RECORD

Job Name	AMERICAN ELECTRIC POWER – NE PLANT	Well Number	MW-1D
Job Number	35087115	Installation Date	10/23/08
Datum Elevation	638.07	Surface Elevation	635.23
Datum for Water Level Measurement	T.O.C.		
Screen Diameter & Material	2" PVC	Slot Size	0.01"
Riser Diameter & Material	2" PVC	Borehole Diameter	6.25"
Granular Backfill Material	12–20 SAND	Terracon Representative	MR/JA
Drilling Method	HOLLOW STEM AUGER/AIR ROTARY	Drilling Contractor	MOHAWK

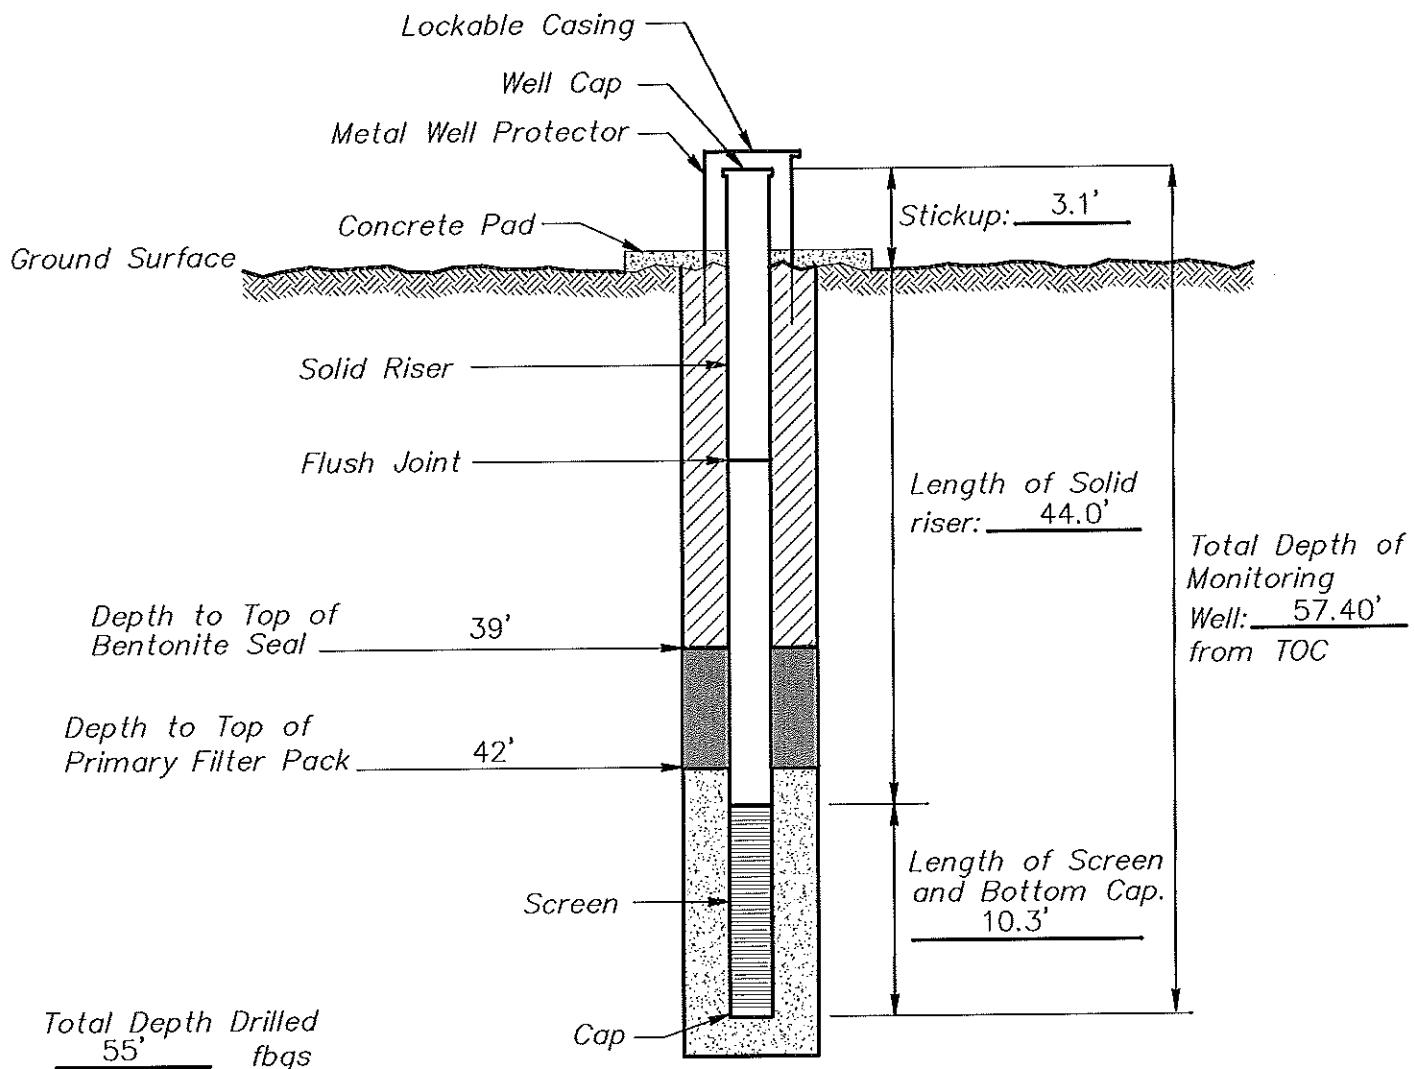

- Portland/Bentonite Grout
- Bentonite Pellets
- Granular Backfill

(Not to Scale)

Terracon
Consulting Engineers and Scientists

25809 Interstate 30 South
PH (501) 847-9292

BRYANT, AR 72022
FAX (501) 847-9210

MONITORING WELL INSTALLATION RECORD

PROJECT NUMBER: 216-003-35087115


WELL NUMBER: MW-1D

DRAWING NUMBER: 035

CHECKED BY: MR

MONITORING WELL INSTALLATION RECORD

Job Name	AMERICAN ELECTRIC POWER - NE PLANT	Well Number	MW-2S
Job Number	35087115	Installation Date	10/13/08
Datum Elevation	637.37	Location	OOLOGAH, OK.
Datum for Water Level Measurement	T.O.C.		
Screen Diameter & Material	2" PVC	Slot Size	0.01"
Riser Diameter & Material	2" PVC	Borehole Diameter	6.25"
Granular Backfill Material	12-20 SAND	Terracon Representative	MR/JA
Drilling Method	HOLLOW STEM AUGER/AIR ROTARY	Drilling Contractor	MOHAWK

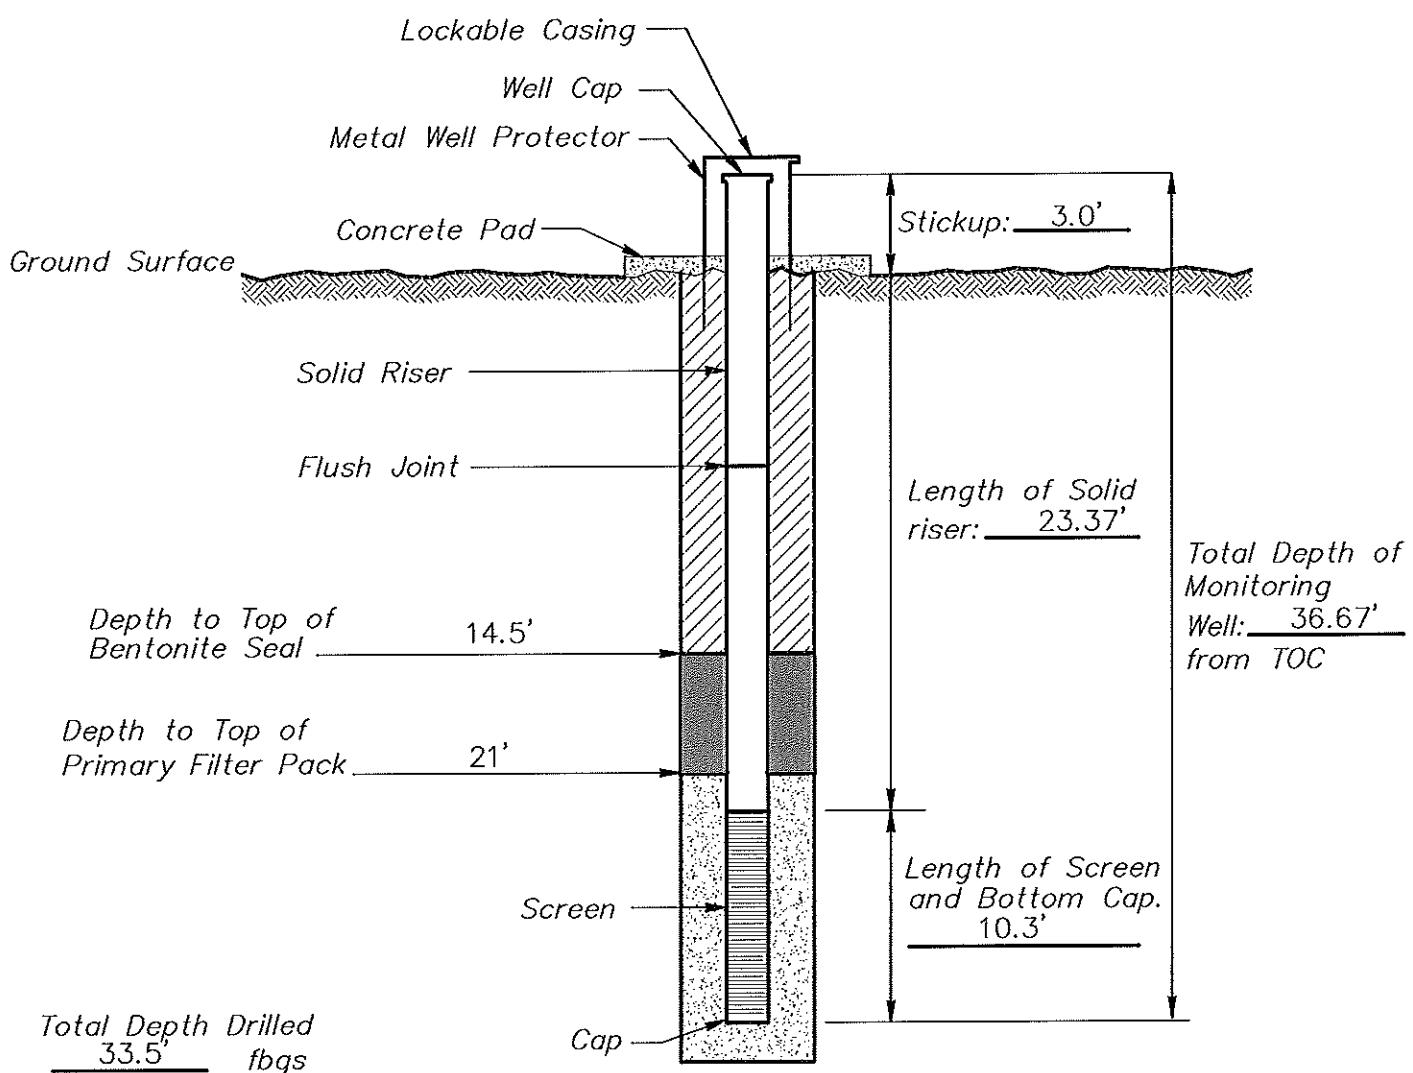

- Portland/Bentonite Grout
- Bentonite Pellets
- Granular Backfill

Terracon
Consulting Engineers and Scientists

25829 Interstate 30 South
PHL (501) 847-9292

BRYANT, AR 72022
FAX (501) 847-9210

MONITORING WELL INSTALLATION RECORD

PROJECT NUMBER: 216-003-35087115


WELL NUMBER: MW-2S

DRAWING NUMBER: 036

CHECKED BY: MR

MONITORING WELL INSTALLATION RECORD

Job Name	AMERICAN ELECTRIC POWER -- NE PLANT	Well Number	MW-3S
Job Number	35087115	Installation Date	10/13/08
Datum Elevation	630.19	Location	OOLOGAH, OK.
Datum for Water Level Measurement	T.O.C.	Surface Elevation	627.09
Screen Diameter & Material	2" PVC	Slot Size	0.01"
Riser Diameter & Material	2" PVC	Borehole Diameter	6.25"
Granular Backfill Material	12-20 SAND	Terracon Representative	MR/JA
Drilling Method	HOLLOW STEM AUGER/AIR ROTARY	Drilling Contractor	MOHAWK

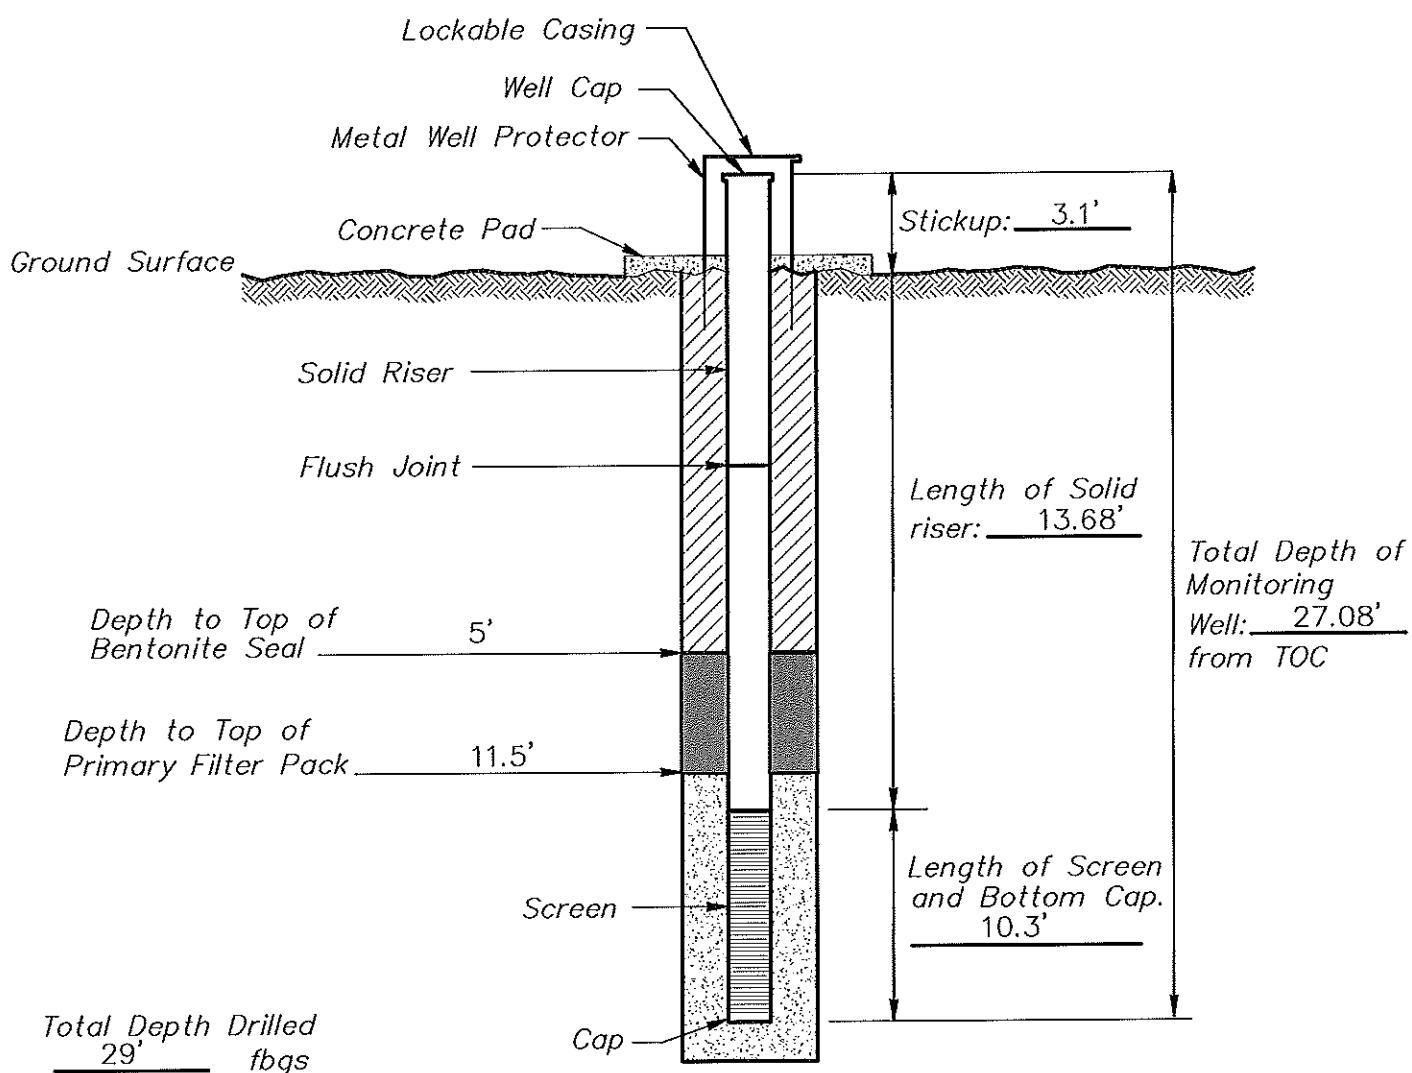

- Portland/Bentonite Grout
- Bentonite Pellets
- Granular Backfill

(Not to Scale)

Terracon
Consulting Engineers and Scientists

25809 Interstate 30 South
PH (501) 847-9292

BRYANT, AR 72022
FAX (501) 847-9210

MONITORING WELL INSTALLATION RECORD

PROJECT NUMBER: 216-003-35087115


WELL NUMBER: MW-3S

DRAWING NUMBER: 037

CHECKED BY: MR

MONITORING WELL INSTALLATION RECORD

Job Name	AMERICAN ELECTRIC POWER – NE PLANT	Well Number	MW-4S
Job Number	35087115	Installation Date	10/13/08
Datum Elevation	624.54	Surface Elevation	621.44
Datum for Water Level Measurement	T.O.C.		
Screen Diameter & Material	2" PVC	Slot Size	0.01"
Riser Diameter & Material	2" PVC	Borehole Diameter	6.25"
Granular Backfill Material	12–20 SAND	Terracon Representative	MR/JA
Drilling Method	HOLLOW STEM AUGER/AIR ROTARY	Drilling Contractor	MOHAWK

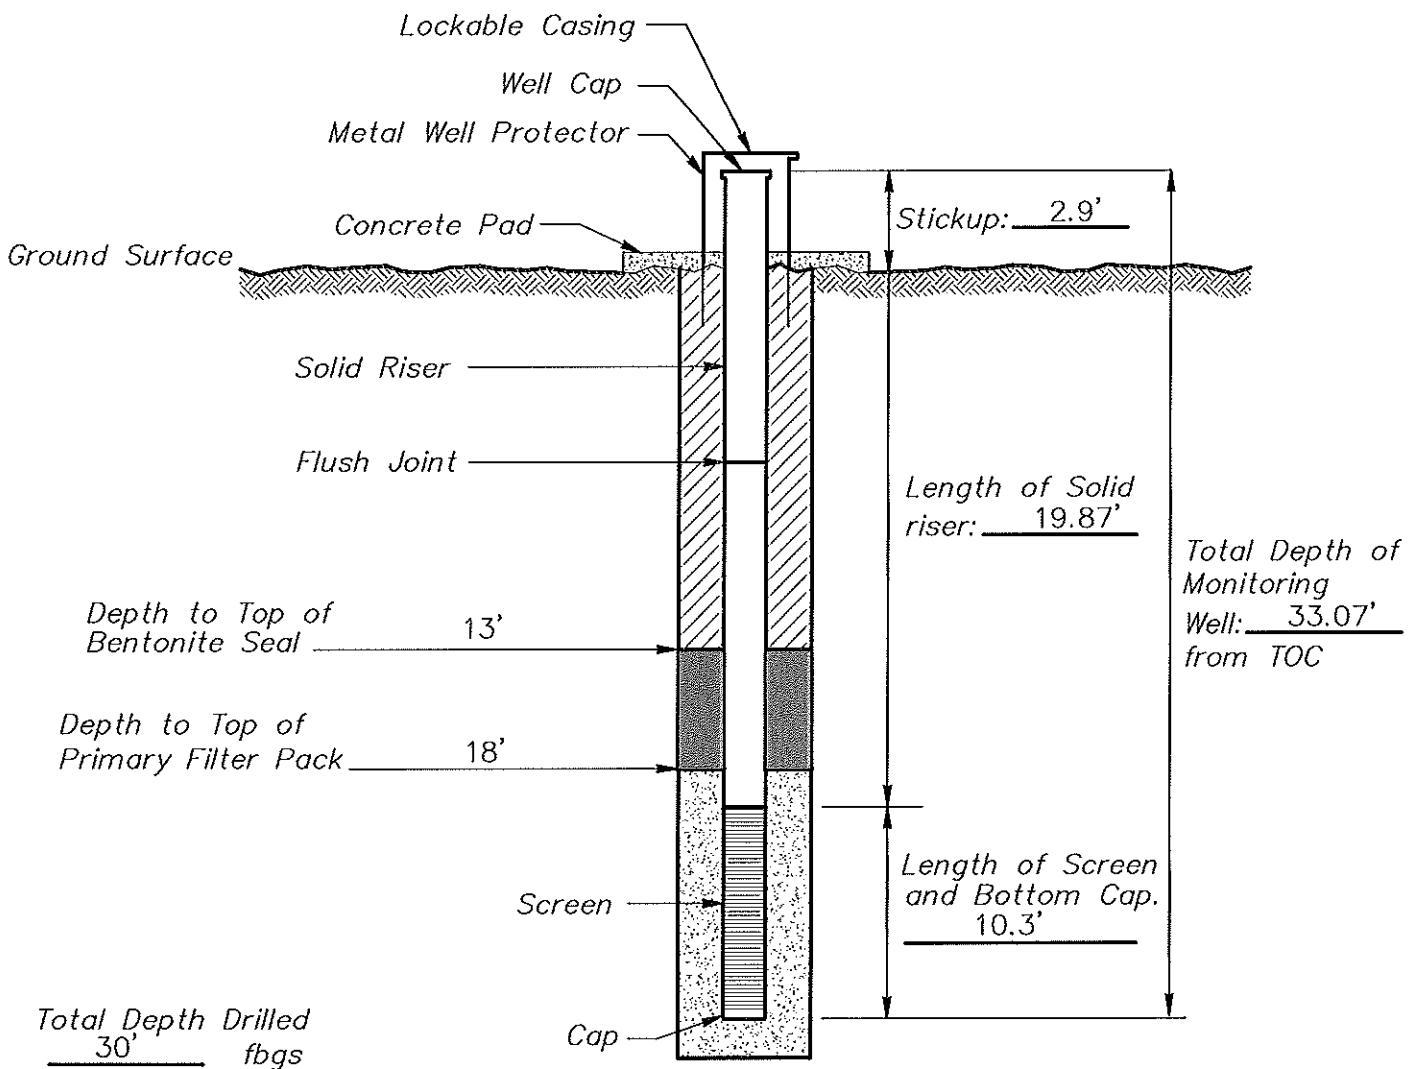

Portland/Bentonite Grout

Bentonite Pellets

Granular Backfill

(Not to Scale)

Terracon
Consulting Engineers and Scientists

25003 Interstate 30 South
PH (501) 847-9292

BRYANT, AR 72022
FAX (501) 847-9210

MONITORING WELL INSTALLATION RECORD

PROJECT NUMBER: 216-003-35087115


WELL NUMBER: MW-4S

DRAWING NUMBER: 038

CHECKED BY: MR

MONITORING WELL INSTALLATION RECORD

Job Name	AMERICAN ELECTRIC POWER - NE PLANT	Well Number	MW-5S
Job Number	35087115	Installation Date	10/21/08
Datum Elevation	636.72	Location	OOLOGAH, OK.
Datum for Water Level Measurement	T.O.C.		
Screen Diameter & Material	2" PVC	Slot Size	0.01"
Riser Diameter & Material	2" PVC	Borehole Diameter	6.25"
Granular Backfill Material	12-20 SAND	Terracon Representative	MR/JA
Drilling Method	HOLLOW STEM AUGER/AIR ROTARY	Drilling Contractor	MOHAWK

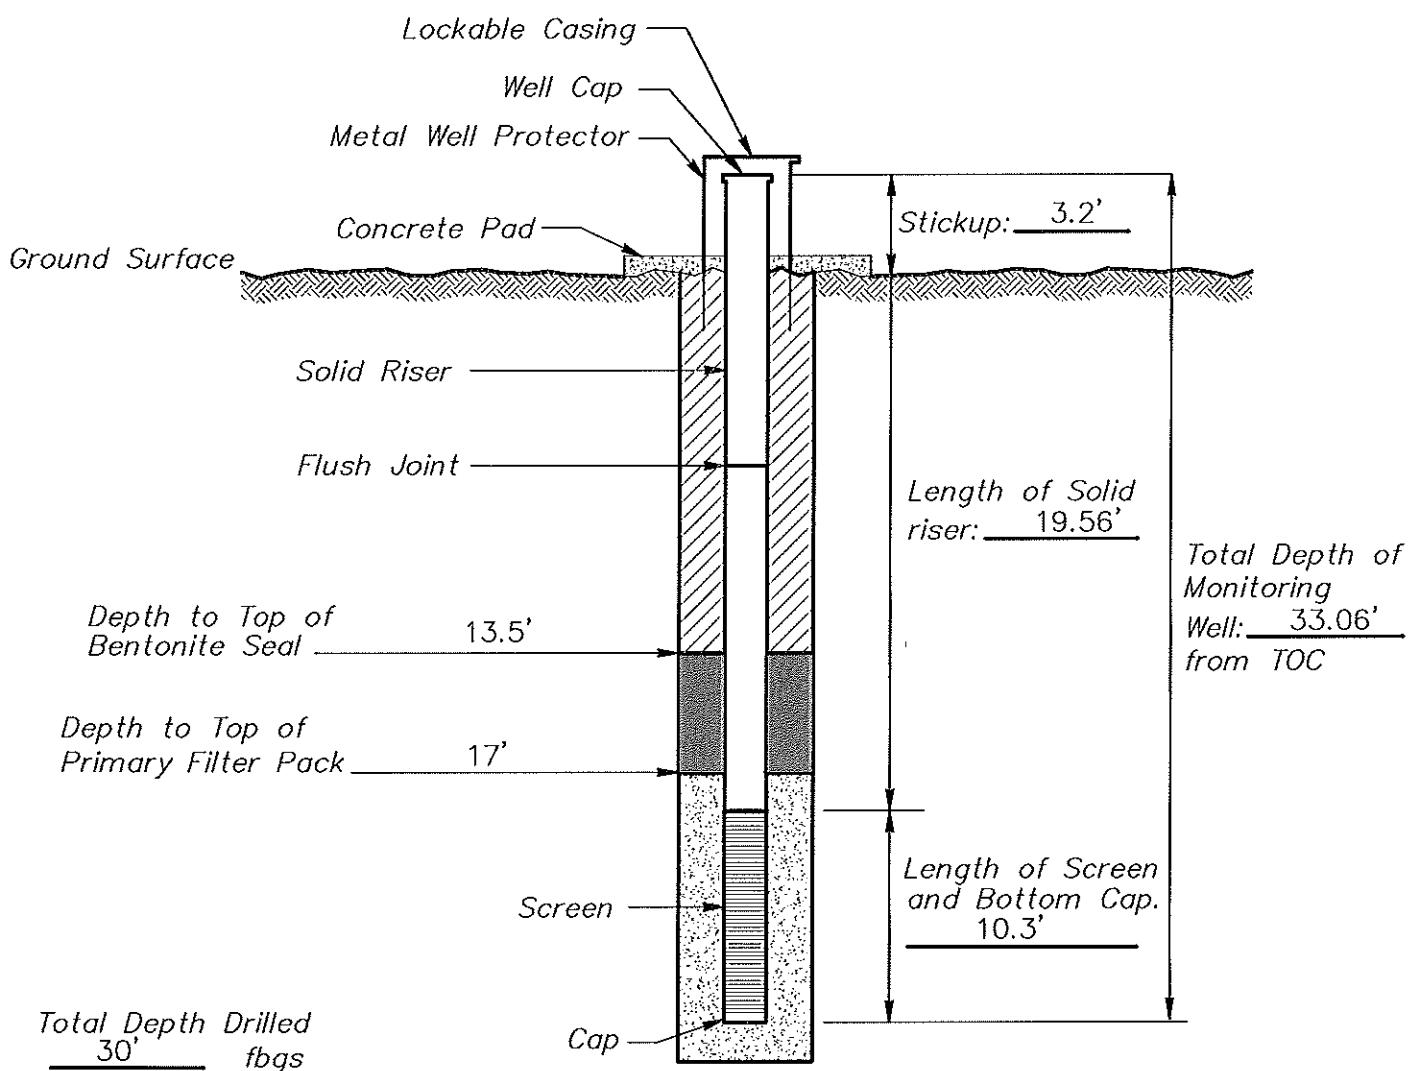

- Portland/Bentonite Grout
- Bentonite Pellets
- Granular Backfill

(Not to Scale)



25809 Interstate 30 South
PH. (501) 847-9292


BRYANT, AR 72022
FAX (501) 847-9210

MONITORING WELL INSTALLATION RECORD

PROJECT NUMBER: 216-003-35087115
WELL NUMBER: MW-5S
DRAWING NUMBER: 039 CHECKED BY: MR

MONITORING WELL INSTALLATION RECORD

Job Name	AMERICAN ELECTRIC POWER - NE PLANT	Well Number	MW-5D
Job Number	35087115	Installation Date	10/23/08
Datum Elevation	636.84	Location	OOLOGAH, OK.
Datum for Water Level Measurement	T.O.C.	Surface Elevation	633.83
Screen Diameter & Material	2" PVC	Slot Size	0.01"
Riser Diameter & Material	2" PVC	Borehole Diameter	6.25"
Granular Backfill Material	12-20 SAND	Terracon Representative	MR/JA
Drilling Method	HOLLOW STEM AUGER/AIR ROTARY	Drilling Contractor	MOHAWK

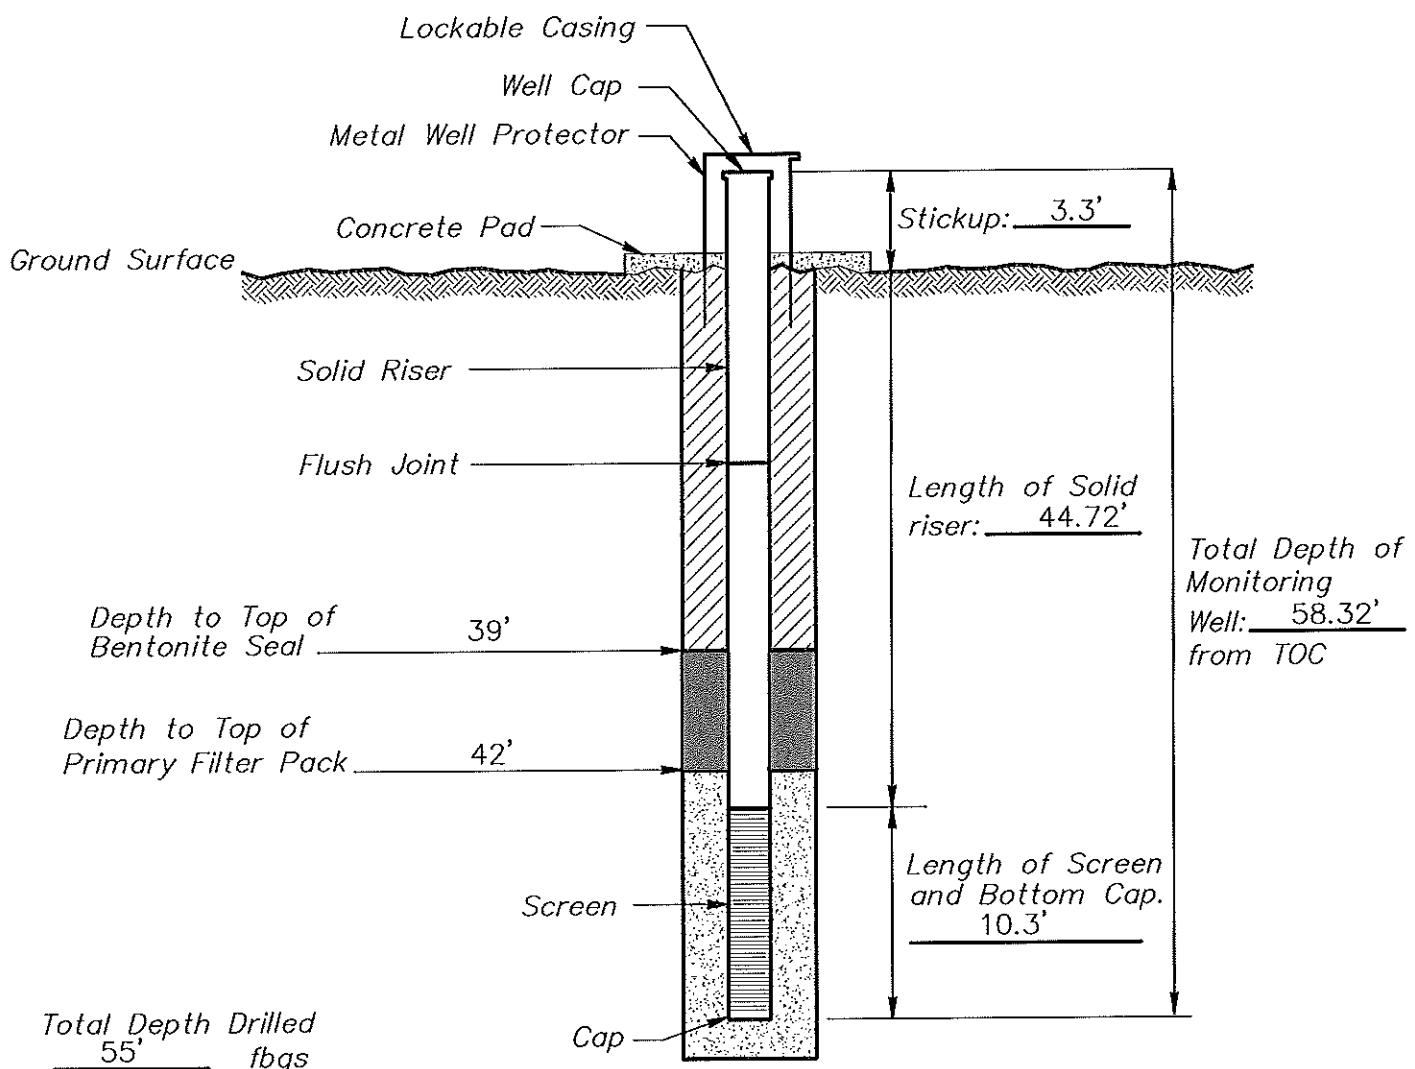

- Portland/Bentonite Grout
- Bentonite Pellets
- Granular Backfill

(Not to Scale)

Terracon
Consulting Engineers and Scientists

25809 Interstate 30 South
PHL (501) 847-9222

BRYANT, AR 72022
FAX (501) 847-9210

MONITORING WELL INSTALLATION RECORD

PROJECT NUMBER: 216-003-35087115


WELL NUMBER: MW-5D

DRAWING NUMBER: 040

CHECKED BY: MR

MONITORING WELL INSTALLATION RECORD

Job Name	AMERICAN ELECTRIC POWER – NE PLANT		Well Number	MW-6S	
Job Number	35087115	Installation Date	10/6/08	Location	OOLOGAH, OK.
Datum Elevation	636.80		Surface Elevation	633.66	
Datum for Water Level Measurement	T.O.C.				
Screen Diameter & Material	2" PVC		Slot Size	0.01"	
Riser Diameter & Material	2" PVC		Borehole Diameter	6.25"	
Granular Backfill Material	12–20 SAND	Terracon Representative	MR/JA		
Drilling Method	HOLLOW STEM AUGER/AIR ROTARY	Drilling Contractor	MOHAWK		

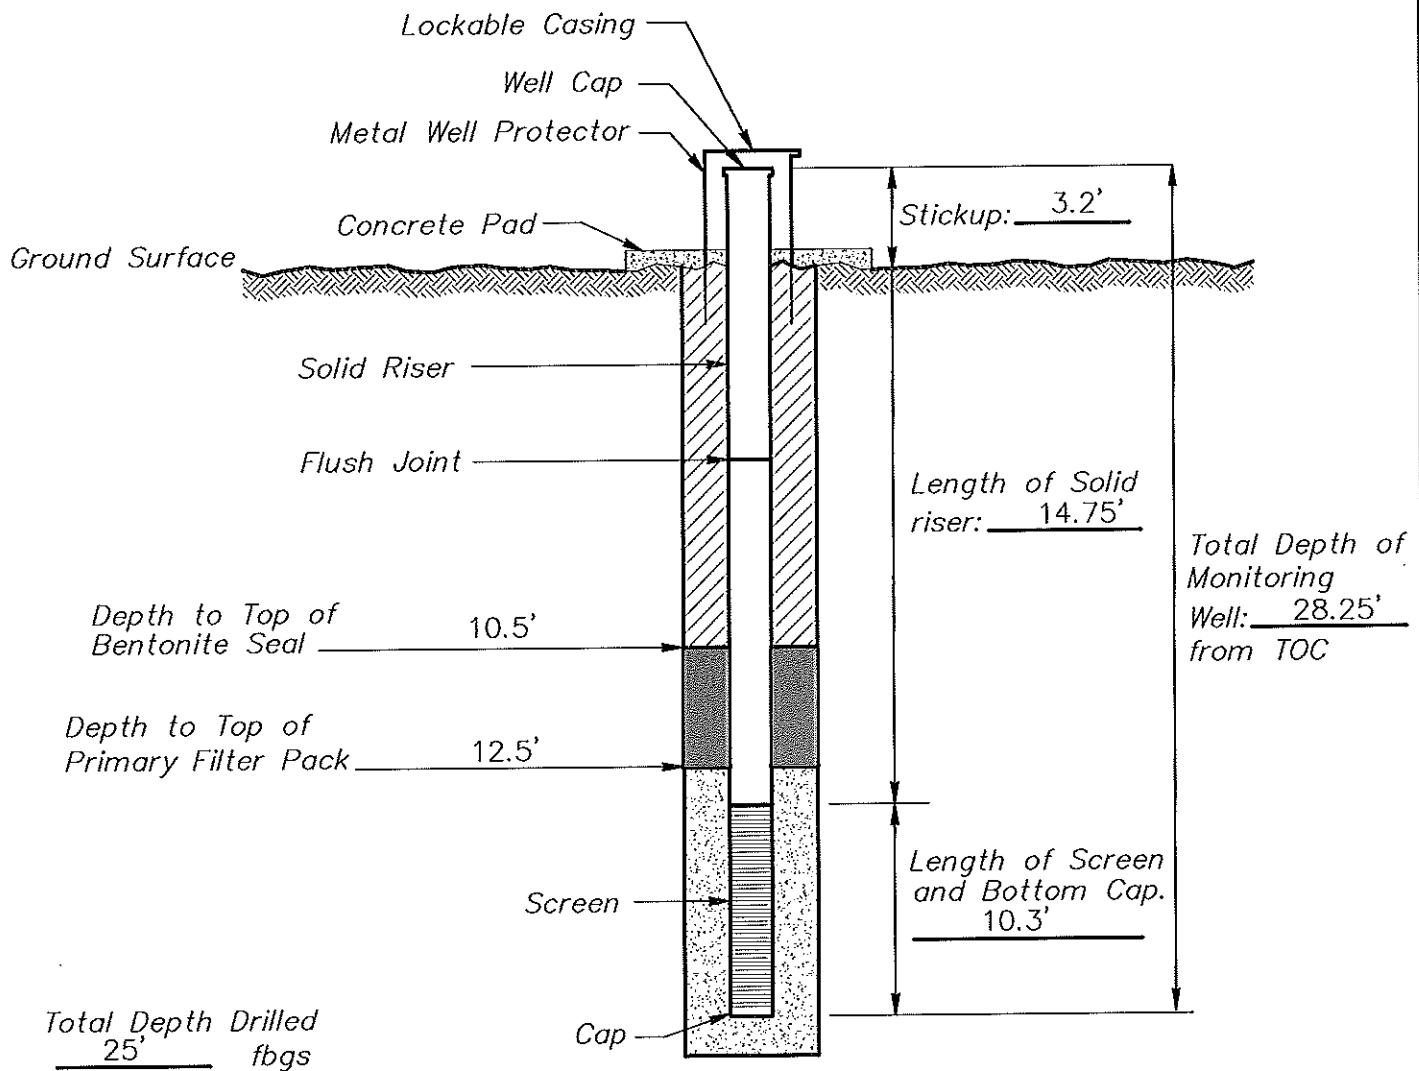

Portland/Bentonite Grout



Bentonite Pellets



Granular Backfill

(Not to Scale)

Terracon
Consulting Engineers and Scientists

25809 Interstate 30 South
PH. (501) 847-9292

BRYANT, AR 72022
FAX. (501) 847-9210

MONITORING WELL INSTALLATION RECORD

PROJECT NUMBER: 216-003-35087115


WELL NUMBER: MW-6S

DRAWING NUMBER: 041

CHECKED BY: MR

MONITORING WELL INSTALLATION RECORD

Job Name	AMERICAN ELECTRIC POWER - NE PLANT	Well Number	MW-6D
Job Number	35087115	Installation Date	10/23/08
Datum Elevation	636.66	Surface Elevation	633.72
Datum for Water Level Measurement	T.O.C.		
Screen Diameter & Material	2" PVC	Slot Size	0.01"
Riser Diameter & Material	2" PVC	Borehole Diameter	6.25"
Granular Backfill Material	12-20 SAND	Terracon Representative	MR/JA
Drilling Method	HOLLOW STEM AUGER/AIR ROTARY	Drilling Contractor	MOHAWK

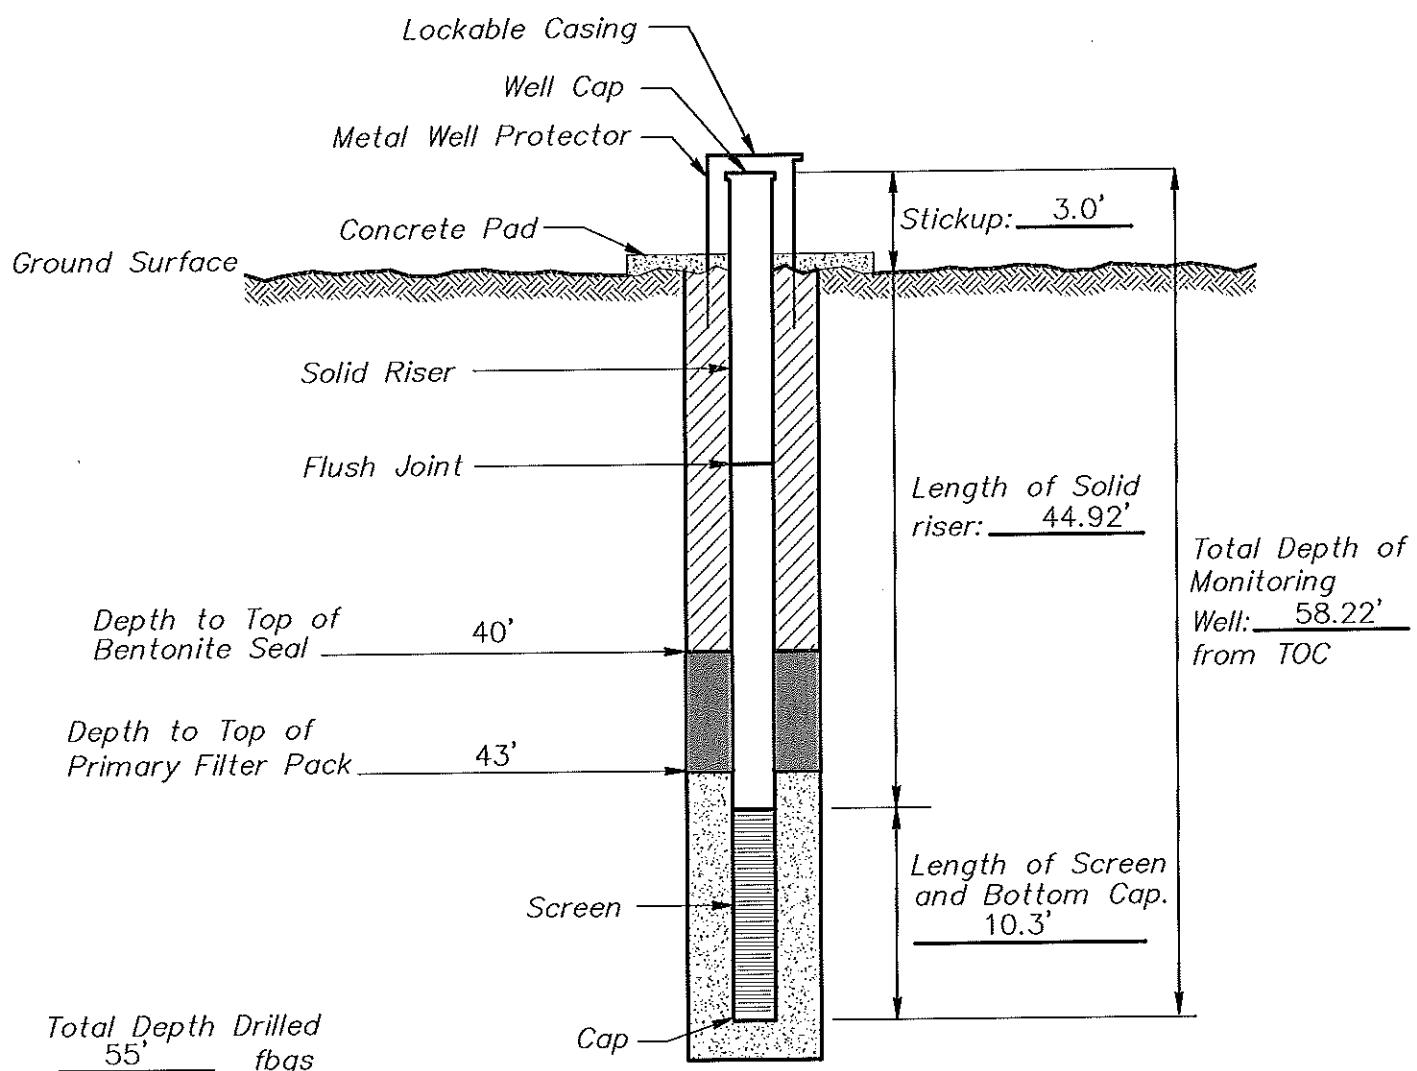

Portland/Bentonite Grout

Bentonite Pellets

(Not to Scale)

Granular Backfill

Terracon
Consulting Engineers and Scientists

26809 Interstate-30 South
FAX (501) 847-9210

MONITORING WELL INSTALLATION RECORD

PROJECT NUMBER: 216-003-35087115


WELL NUMBER: MW-6D

DRAWING NUMBER: 042

CHECKED BY: MR

MONITORING WELL INSTALLATION RECORD

Job Name	AMERICAN ELECTRIC POWER – NE PLANT	Well Number	MW-7S
Job Number	35087115	Installation Date	10/22/08
Datum Elevation	626.45	Surface Elevation	623.58
Datum for Water Level Measurement	T.O.C.		
Screen Diameter & Material	2" PVC	Slot Size	0.01"
Riser Diameter & Material	2" PVC	Borehole Diameter	6.25"
Granular Backfill Material	12–20 SAND	Terracon Representative	MR/JA
Drilling Method	HOLLOW STEM AUGER/AIR ROTARY	Drilling Contractor	MOHAWK

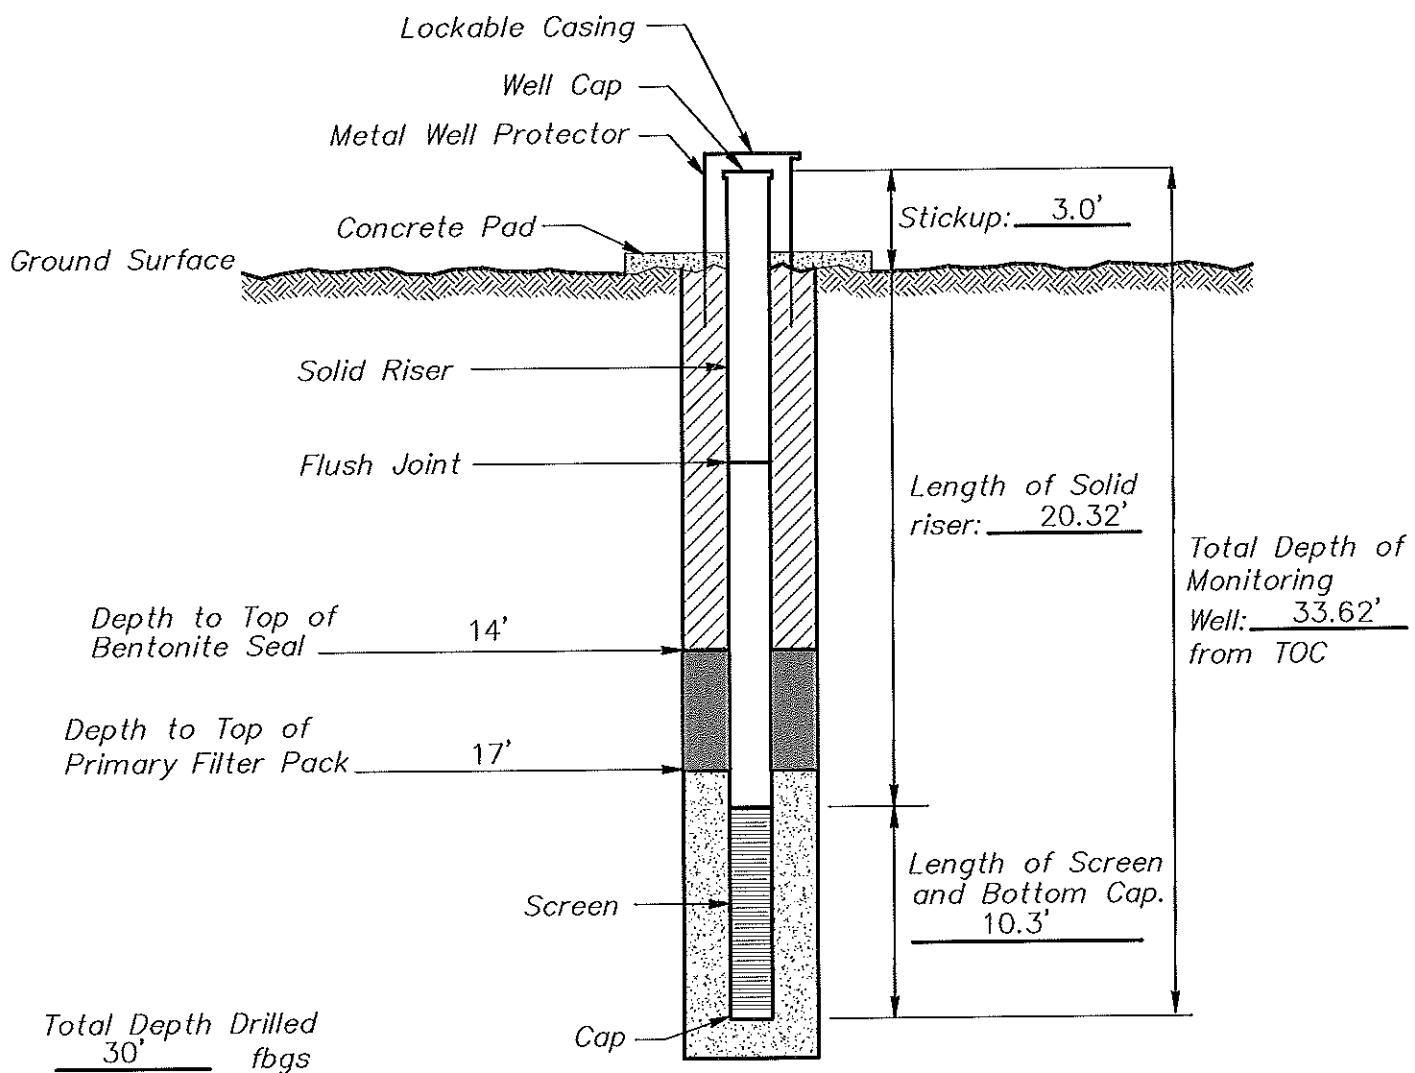

- Portland/Bentonite Grout
- Bentonite Pellets
- Granular Backfill

(Not to Scale)

Terracon
Consulting Engineers and Scientists

26809 Interstate 30 South
PH. (501) 847-9292

BRYANT, AR 72022
FAX. (501) 847-9210

MONITORING WELL INSTALLATION RECORD

PROJECT NUMBER: 216-003-35087115


WELL NUMBER: MW-7S

DRAWING NUMBER: 043

CHECKED BY: MR

MONITORING WELL INSTALLATION RECORD

Job Name	AMERICAN ELECTRIC POWER – NE PLANT	Well Number	MW-7D
Job Number	35087115	Installation Date	10/22/08
Datum Elevation	626.46	Surface Elevation	623.74
Datum for Water Level Measurement	T.O.C.		
Screen Diameter & Material	2" PVC	Slot Size	0.01"
Riser Diameter & Material	2" PVC	Borehole Diameter	6.25"
Granular Backfill Material	12-20 SAND	Terracon Representative	MR/JA
Drilling Method	HOLLOW STEM AUGER/AIR ROTARY	Drilling Contractor	MOHAWK

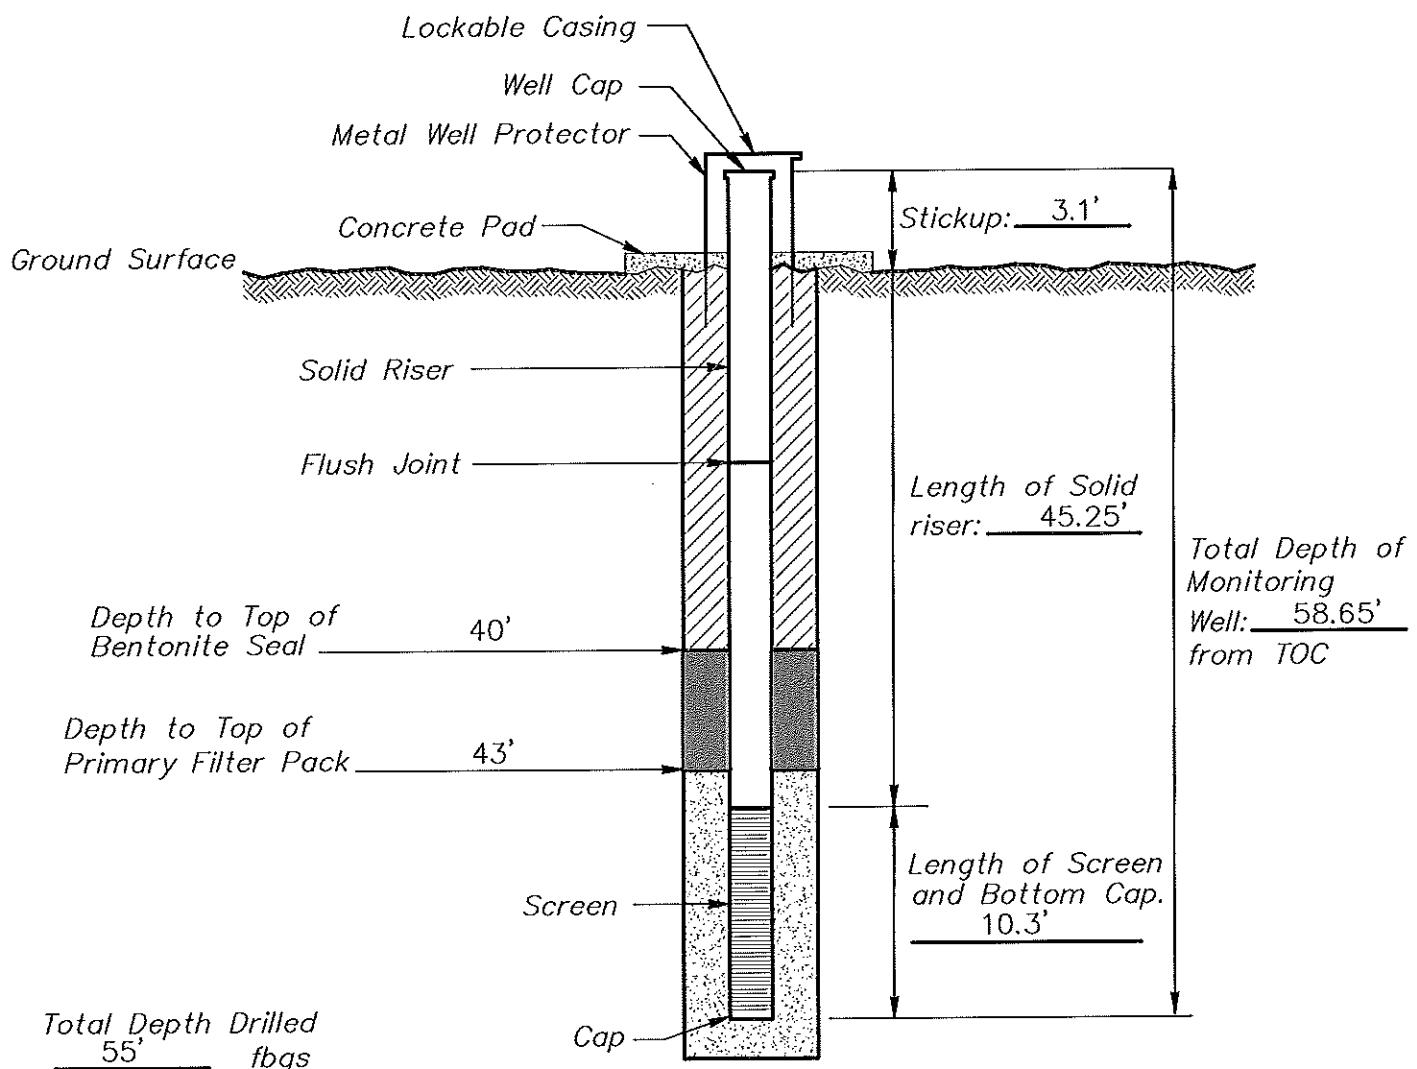

Portland/Bentonite Grout

Bentonite Pellets

Granular Backfill

(Not to Scale)

Terracon
Consulting Engineers and Scientists

25809 Interstate 30 South
PH: (501) 847-9222

BRYANT, AR 72022
FAX: (501) 847-9210

MONITORING WELL INSTALLATION RECORD

PROJECT NUMBER: 216-003-35087115


WELL NUMBER: MW-7D

DRAWING NUMBER: 044

CHECKED BY: MR

MONITORING WELL INSTALLATION RECORD

Job Name	AMERICAN ELECTRIC POWER – NE PLANT	Well Number	MW-8S
Job Number	35087115	Installation Date	10/21/08
Datum Elevation	628.71	Location	OOGAH, OK.
Datum for Water Level Measurement	T.O.C.		
Screen Diameter & Material	2" PVC	Slot Size	0.01"
Riser Diameter & Material	2" PVC	Borehole Diameter	6.25"
Granular Backfill Material	12-20 SAND	Terracon Representative	MR/JA
Drilling Method	HOLLOW STEM AUGER/AIR ROTARY	Drilling Contractor	MOHAWK

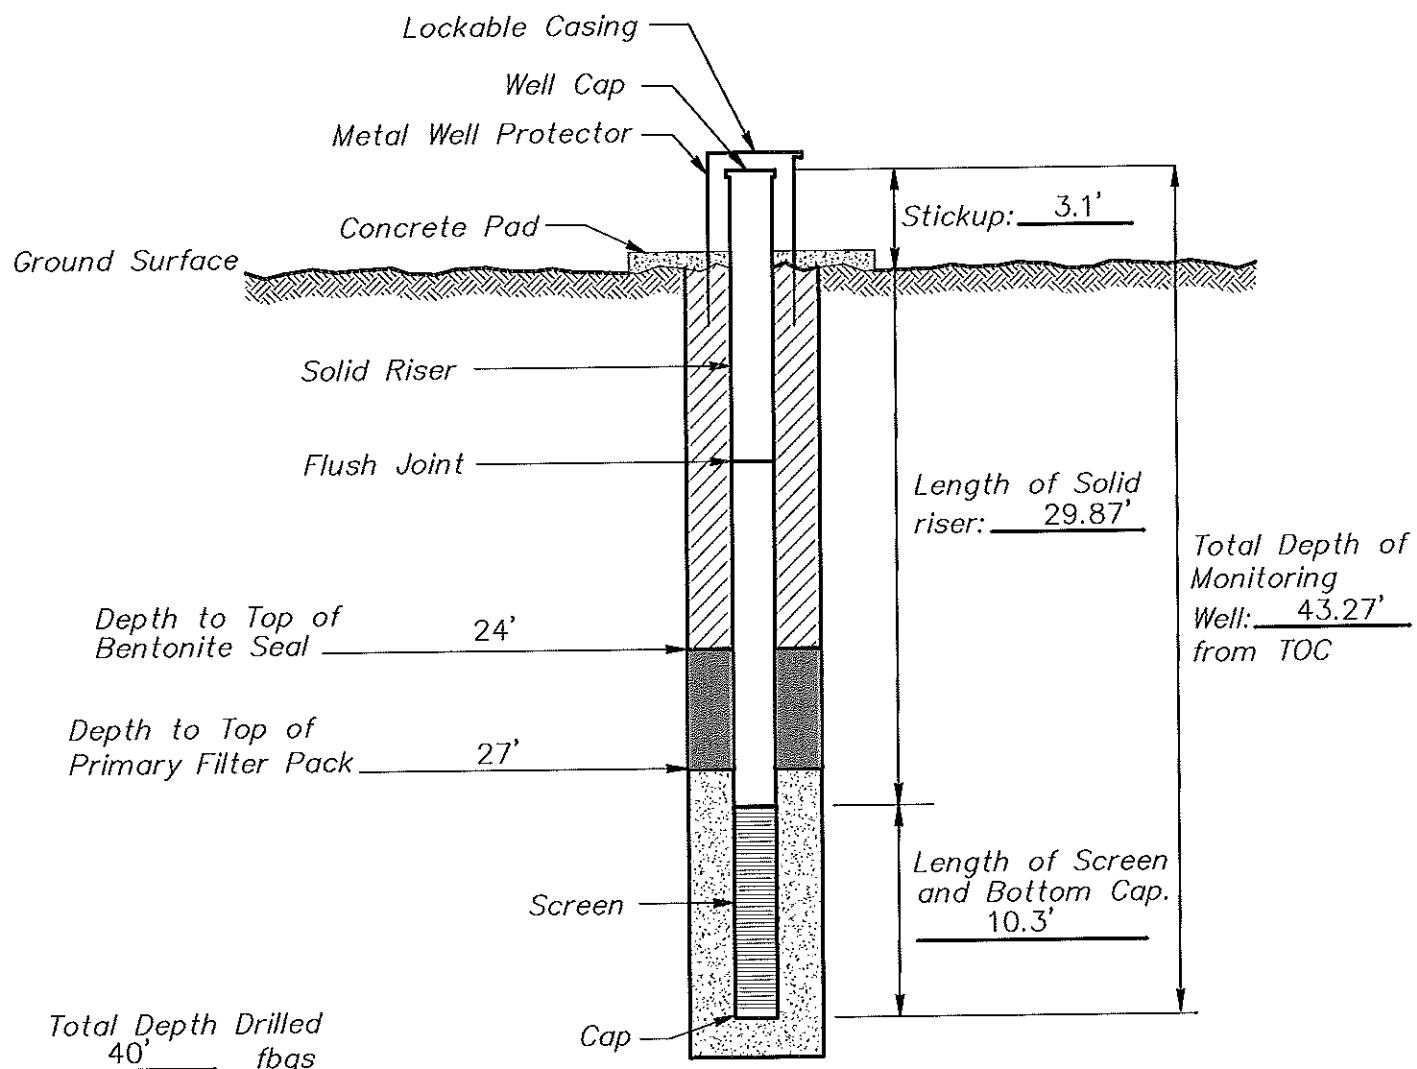

Portland/Bentonite Grout

Bentonite Pellets

(Not to Scale)

Granular Backfill

Terracon
Consulting Engineers and Scientists

25809 Interstate-30 South
PH. (501) 847-9232

BRYANT, AR 72022
FAX (501) 847-9210

MONITORING WELL INSTALLATION RECORD

PROJECT NUMBER: 216-003-35087115


WELL NUMBER: MW-8S

DRAWING NUMBER: 045

CHECKED BY: MR

MONITORING WELL INSTALLATION RECORD

Job Name	AMERICAN ELECTRIC POWER - NE PLANT	Well Number	MW-8D
Job Number	35087115	Installation Date	10/21/08
Datum Elevation	629.32	Location	OOLOGAH, OK.
Datum for Water Level Measurement	T.O.C.	Surface Elevation	626.04
Screen Diameter & Material	2" PVC	Slot Size	0.01"
Riser Diameter & Material	2" PVC	Borehole Diameter	6.25"
Granular Backfill Material	12-20 SAND	Terracon Representative	MR/JA
Drilling Method	HOLLOW STEM AUGER/AIR ROTARY	Drilling Contractor	MOHAWK

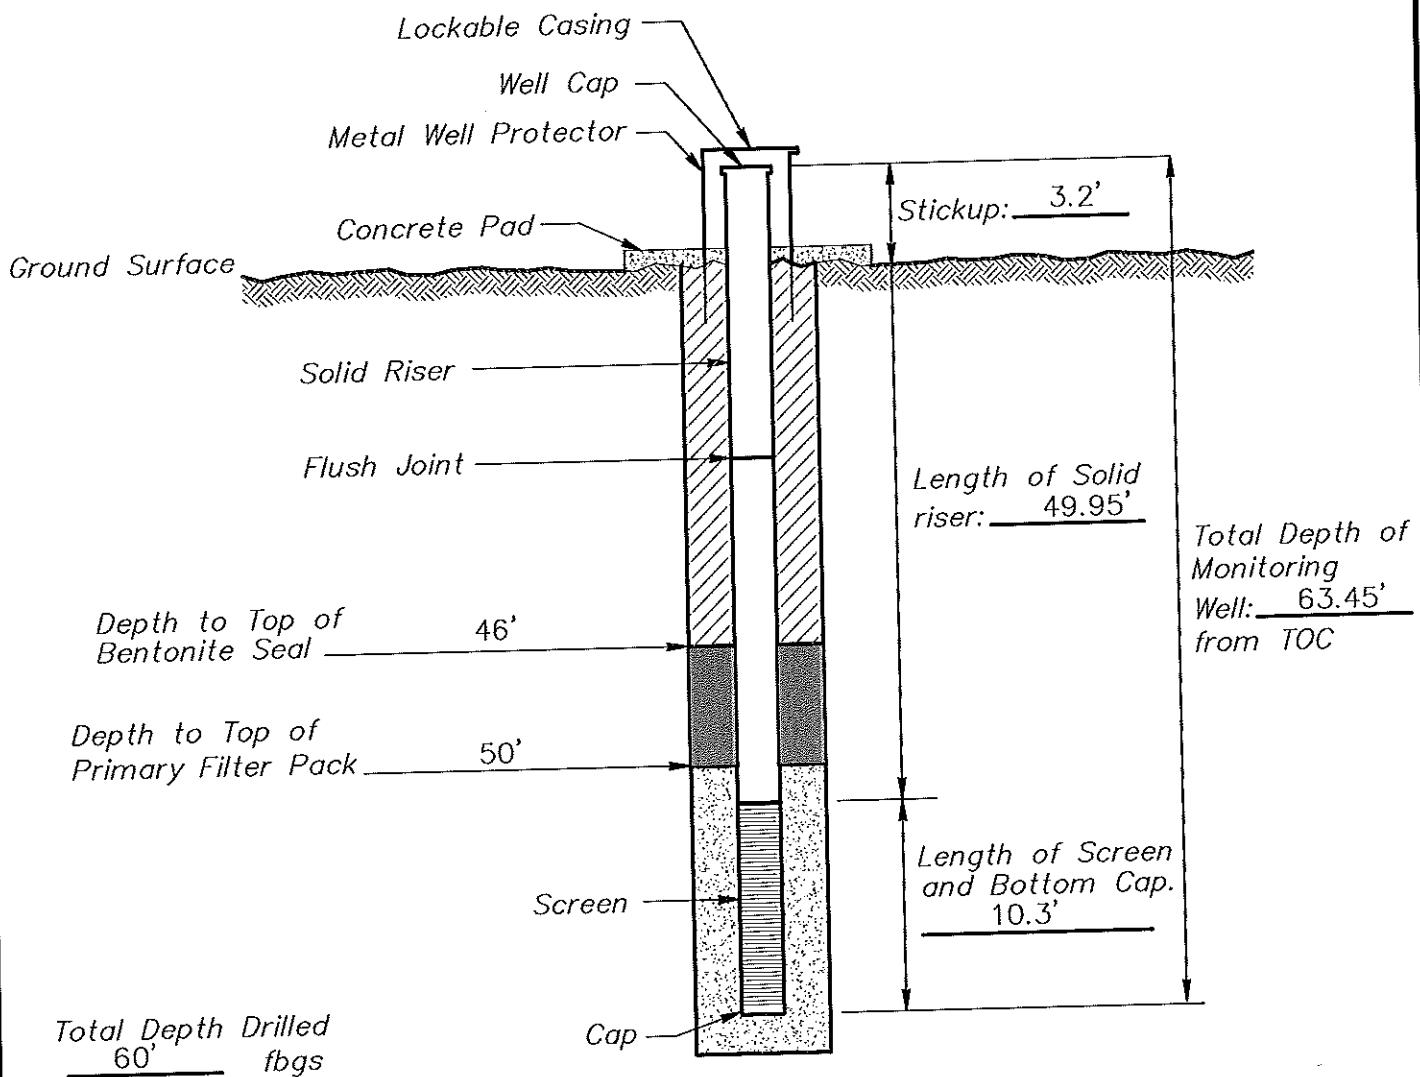

Portland/Bentonite Grout

Bentonite Pellets

Granular Backfill

(Not to Scale)

Terracon

Consulting Engineers and Scientists

25809 Interstate-30 South
PH. (501) 847-9292

BRYANT, AR 72022
FAX (501) 847-9210

MONITORING WELL INSTALLATION RECORD

PROJECT NUMBER: 216-003-35087115


WELL NUMBER: MW-8D

DRAWING NUMBER: 046

CHECKED BY: MR

MONITORING WELL INSTALLATION RECORD

Job Name	AEP NORTHEAST STATION HYDROGEOLOGIC INVESTIGATION	Well Number	MW-9S
Job Number	35107060	Installation Date	4/7/2010
Datum Elevation	636.94'	Location	OOLOGAH, OK.
Datum for Water Level Measurement	TOP OF CASING		
Screen Diameter & Material	2" PVC	Slot Size	0.01"
Riser Diameter & Material	2" PVC	Borehole Diameter	6"
Granular Backfill Material	12-20 SAND	Terracon Representative	CLANCY McCLINTOCK
Drilling Method	H.S.A., W.L.C., AIR HAMMER	Drilling Contractor	MOHAWK

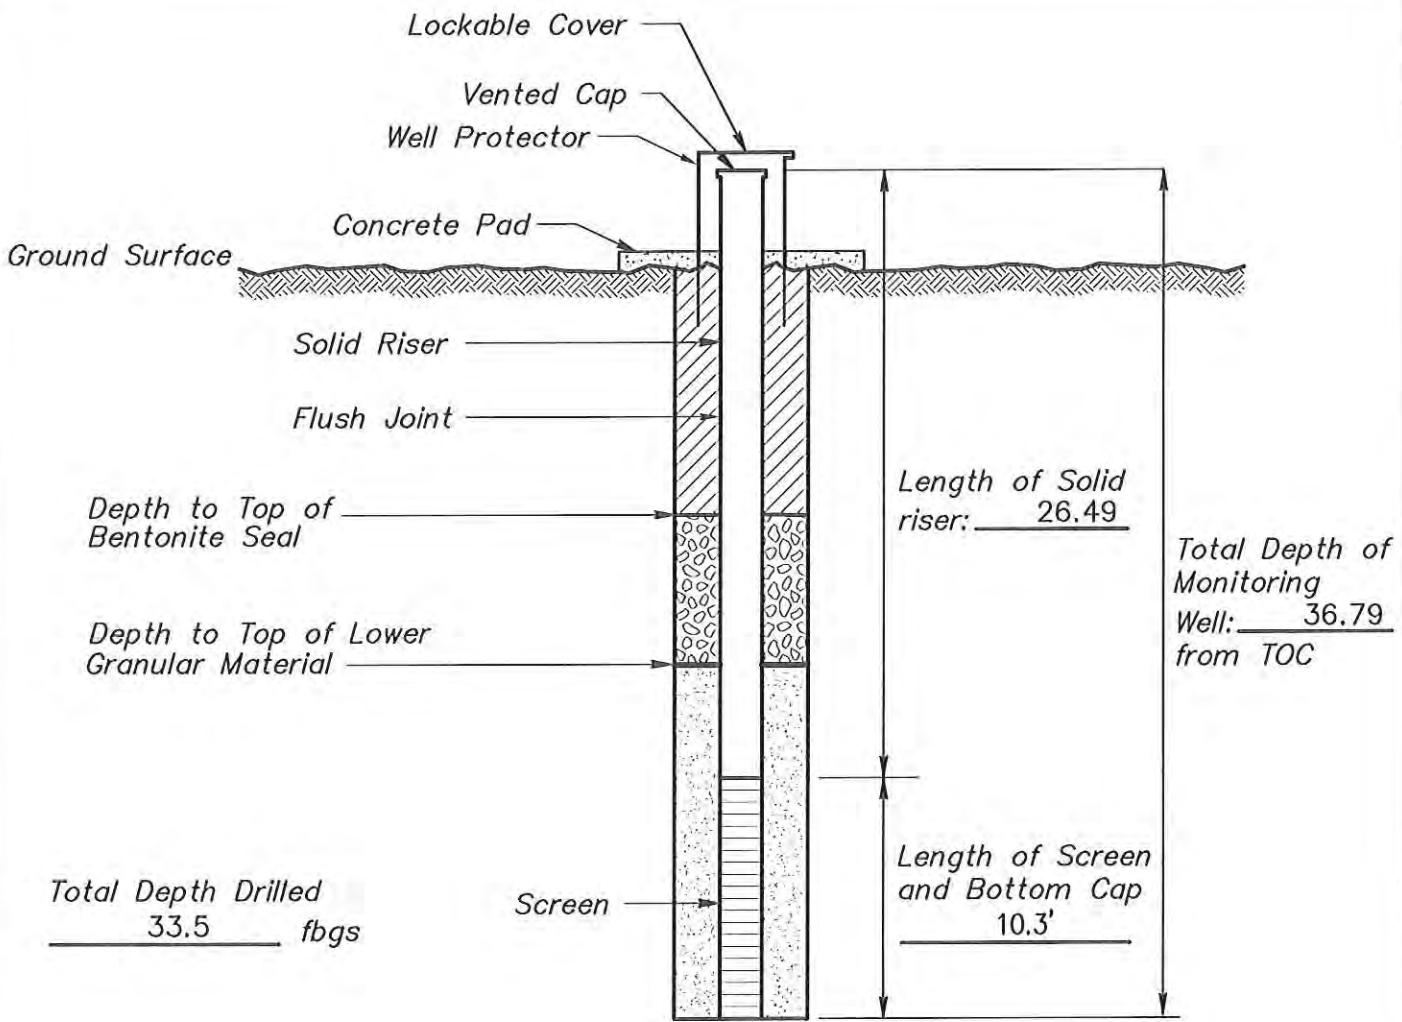

Portland-Bentonite Grout

(Not to Scale)

Bentonite Plug

Granular Backfill Material

Terracon
Consulting Engineers and Scientists

25609 INTERSTATE 30 S
PH (501) 847-9292

BRYANT, AR 72202
FAX (501) 847-9210

MONITORING WELL INSTALLATION RECORD

PROJECT NUMBER: 216-003-35107060


WELL NUMBER: MW-9S

DRAWING NUMBER: 011

CHECKED BY: MR

MONITORING WELL INSTALLATION RECORD

Job Name AEP NORTHEAST STATION HYDROGEOLOGIC INVESTIGATION Well Number MW-9D
 Job Number 35107060 Installation Date 4/6/2010 Location OOLOGAH, OK.
 Datum Elevation 637.04' Surface Elevation 633.90'
 Datum for Water Level Measurement TOP OF CASING
 Screen Diameter & Material 2" PVC Slot Size 0.01"
 Riser Diameter & Material 2" PVC Borehole Diameter 6"
 Granular Backfill Material 12-20 SAND Terracon Representative CLANCY McCLINTOCK
 Drilling Method H.S.A., W.L.C., AIR HAMMER Drilling Contractor MOHAWK

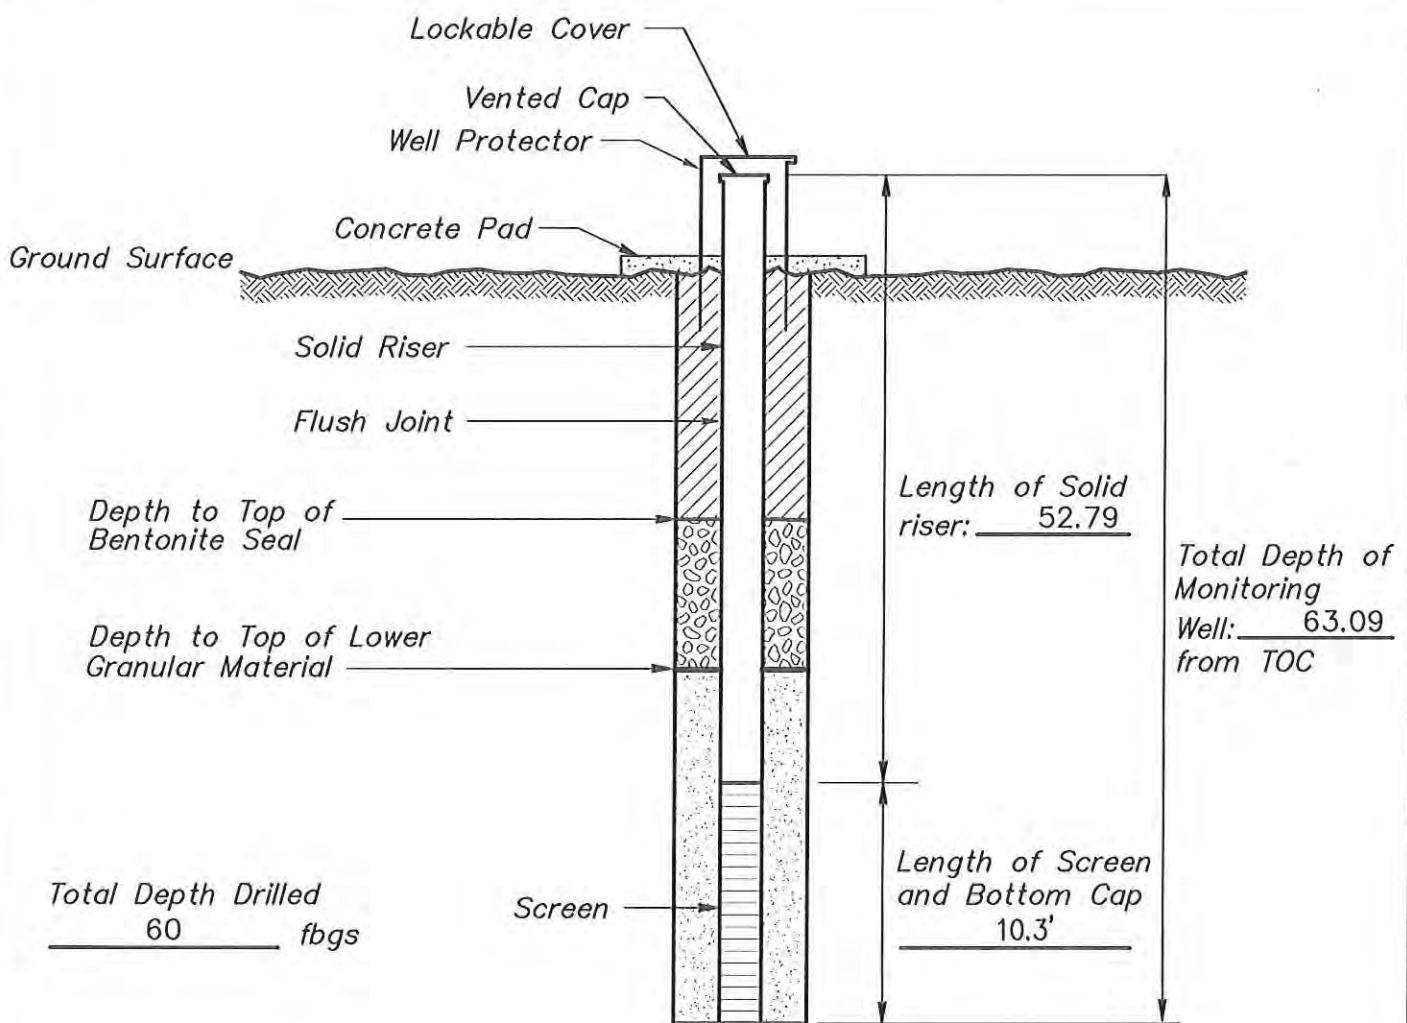

Portland-Bentonite Grout

Bentonite Plug

Granular Backfill Material

Terracon
Consulting Engineers and Scientists

26809 INTERSTATE 30 S
PH: (501) 847-9292

BRYANT, AR 72202
FAX: (501) 847-9210

MONITORING WELL INSTALLATION RECORD

PROJECT NUMBER: 216-003-35107060


WELL NUMBER: MW-9D

DRAWING NUMBER: 012

CHECKED BY: MR

MONITORING WELL INSTALLATION RECORD

Job Name AEP NORTHEAST STATION HYDROGEOLOGIC INVESTIGATION Well Number MW-10S
 Job Number 35107060 Installation Date 4/13/2010 Location OOLOGAH, OK.
 Datum Elevation 639.58' Surface Elevation 636.36'
 Datum for Water Level Measurement TOP OF CASING
 Screen Diameter & Material 2" PVC Slot Size 0.01"
 Riser Diameter & Material 2" PVC Borehole Diameter 6"
 Granular Backfill Material 12-20 SAND Terracon Representative CLANCY McCLINTOCK
 Drilling Method W.L.C., AIR HAMMER Drilling Contractor MOHAWK

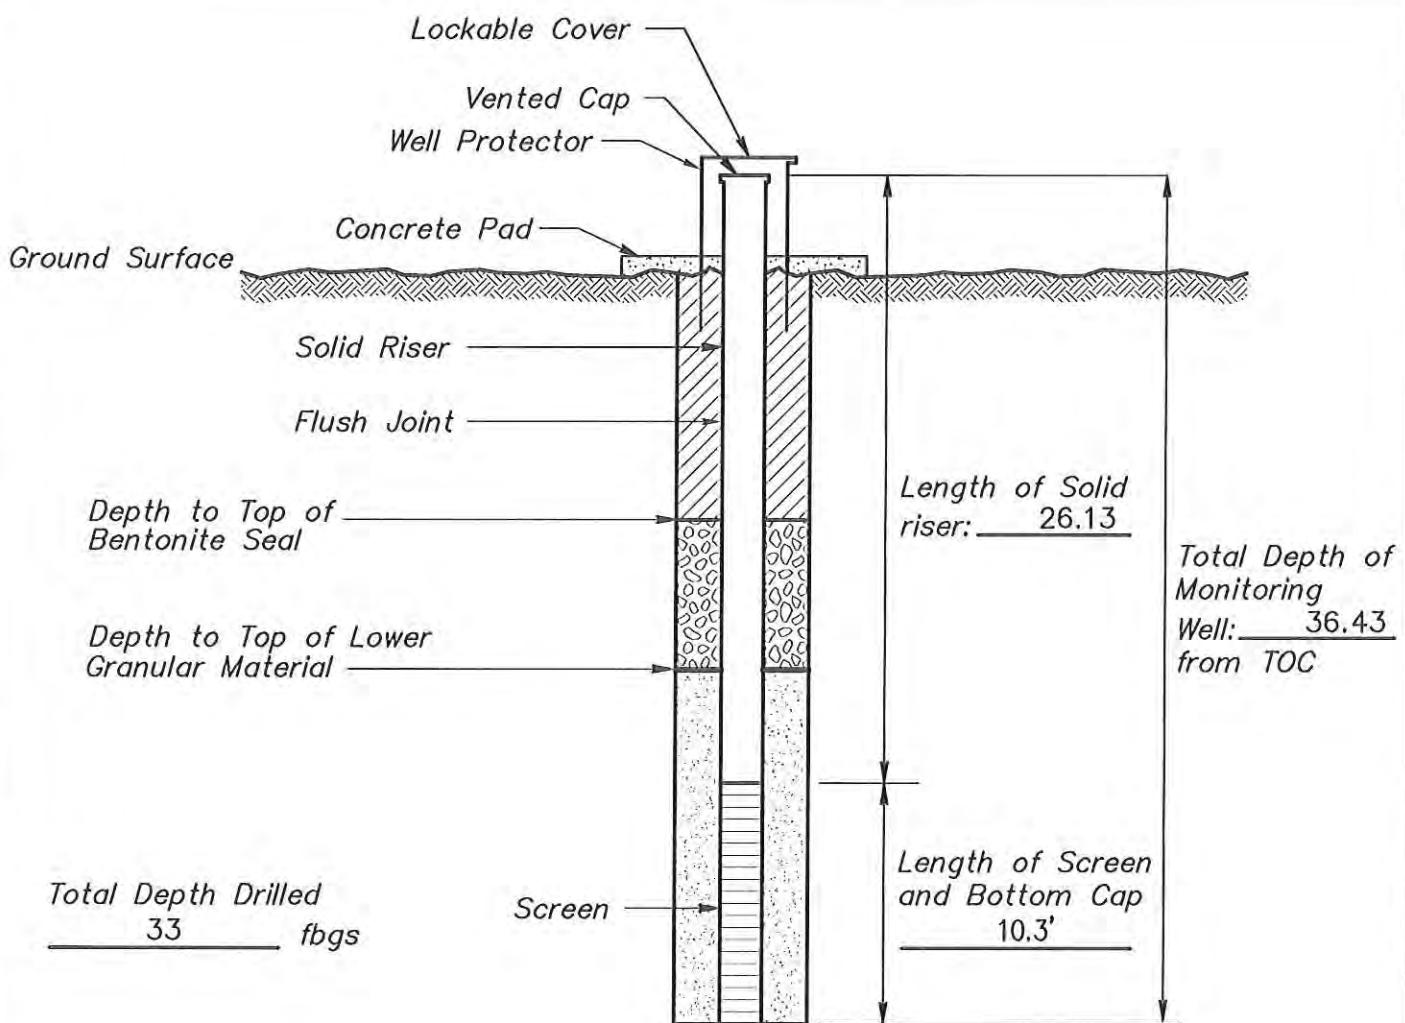

Portland-Bentonite Grout

(Not to Scale)

Bentonite Plug

Granular Backfill Material

Terracon
Consulting Engineers and Scientists

25809 INTERSTATE 30 S
PH. (501) 847-9292

BRYANT, AR 72202
FAX (501) 847-9210

MONITORING WELL INSTALLATION RECORD

PROJECT NUMBER: 216-003-35107060


WELL NUMBER: MW-10S

DRAWING NUMBER: 013

CHECKED BY: MR

MONITORING WELL INSTALLATION RECORD

Job Name	AEP NORTHEAST STATION HYDROGEOLOGIC INVESTIGATION	Well Number	MW-10D
Job Number	35107060	Installation Date	4/12/2010
Datum Elevation	639.32'	Surface Elevation	636.14'
Datum for Water Level Measurement	TOP OF CASING		
Screen Diameter & Material	2" PVC	Slot Size	0.01"
Riser Diameter & Material	2" PVC	Borehole Diameter	6"
Granular Backfill Material	12-20 SAND	Terracon Representative	CLANCY McCLINTOCK
Drilling Method	W.L.C., AIR HAMMER	Drilling Contractor	MOHAWK

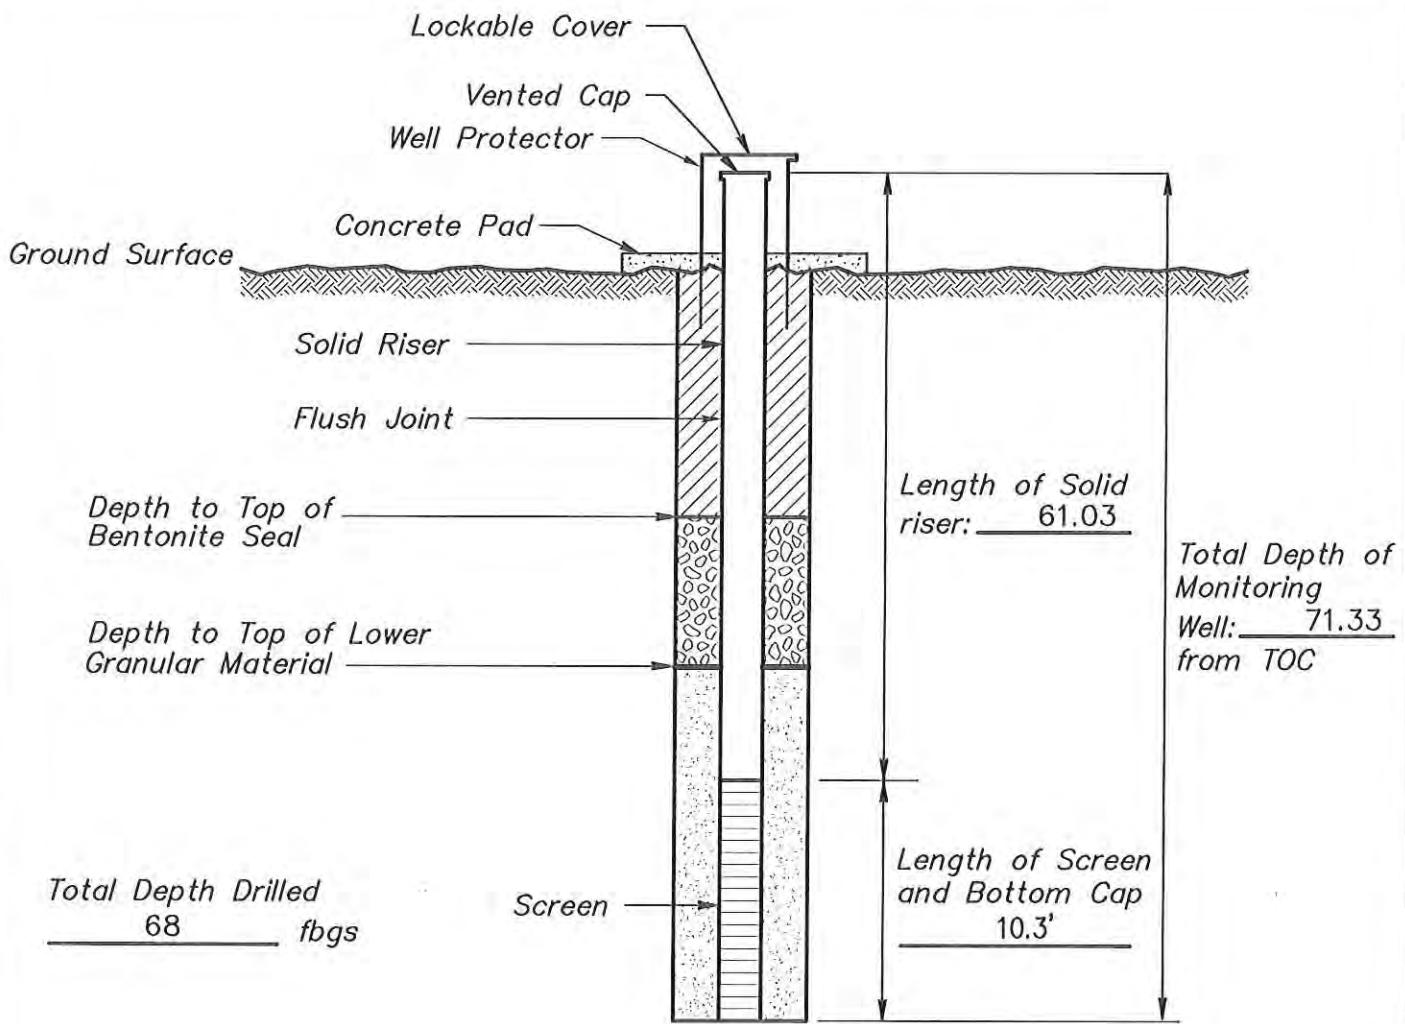

- Portland-Bentonite Grout
- Bentonite Plug
- Granular Backfill Material

Terracon
Consulting Engineers and Scientists

25809 INTERSTATE 30 S
PH (501) 847-9292

BRYANT, AR 72202
FAX (501) 847-9210

MONITORING WELL INSTALLATION RECORD

PROJECT NUMBER: 216-003-35107060


WELL NUMBER: MW-10D

DRAWING NUMBER: 014

CHECKED BY: MR

MONITORING WELL INSTALLATION RECORD

Job Name	AEP NORTHEAST STATION HYDROGEOLOGIC INVESTIGATION	Well Number	MW-11S
Job Number	35107060	Installation Date	4/15/2010
Datum Elevation	628.75'	Surface Elevation	625.91'
Datum for Water Level Measurement	TOP OF CASING		
Screen Diameter & Material	2" PVC	Slot Size	0.01"
Riser Diameter & Material	2" PVC	Borehole Diameter	6"
Granular Backfill Material	12-20 SAND	Terracon Representative	CLANCY McCLINTOCK
Drilling Method	W.L.C., AIR HAMMER	Drilling Contractor	MOHAWK

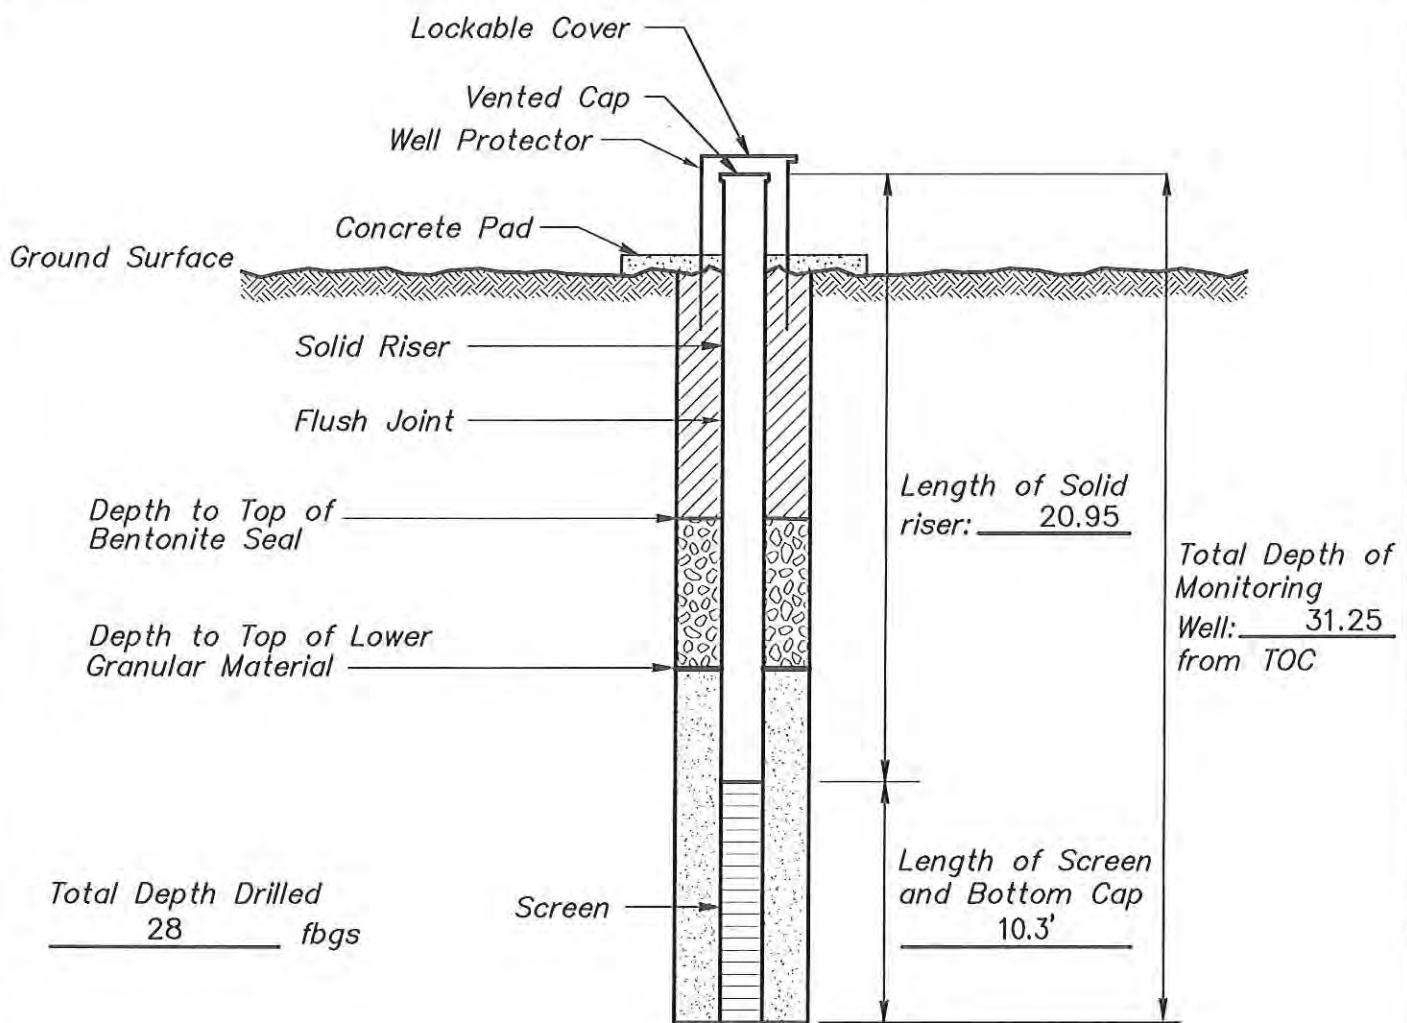

Portland-Bentonite Grout



Bentonite Plug



Granular Backfill Material

Terracon
Consulting Engineers and Scientists

25809 INTERSTATE 30 S
PH. (501) 847-9292

BRYANT, AR 72202
FAX (501) 847-9210

MONITORING WELL INSTALLATION RECORD

PROJECT NUMBER: 216-003-35107060


WELL NUMBER: MW-11S

DRAWING NUMBER: 015

CHECKED BY: MR

MONITORING WELL INSTALLATION RECORD

Job Name	AEP NORTHEAST STATION HYDROGEOLOGIC INVESTIGATION	Well Number	MW-11D
Job Number	35107060	Installation Date	4/14/2010
Datum Elevation	628.27'	Surface Elevation	625.97'
Datum for Water Level Measurement	TOP OF CASING		
Screen Diameter & Material	2" PVC	Slot Size	0.01"
Riser Diameter & Material	2" PVC	Borehole Diameter	6"
Granular Backfill Material	12-20 SAND	Terracon Representative	CLANCY McCLINTOCK
Drilling Method	W.L.C., AIR HAMMER	Drilling Contractor	MOHAWK

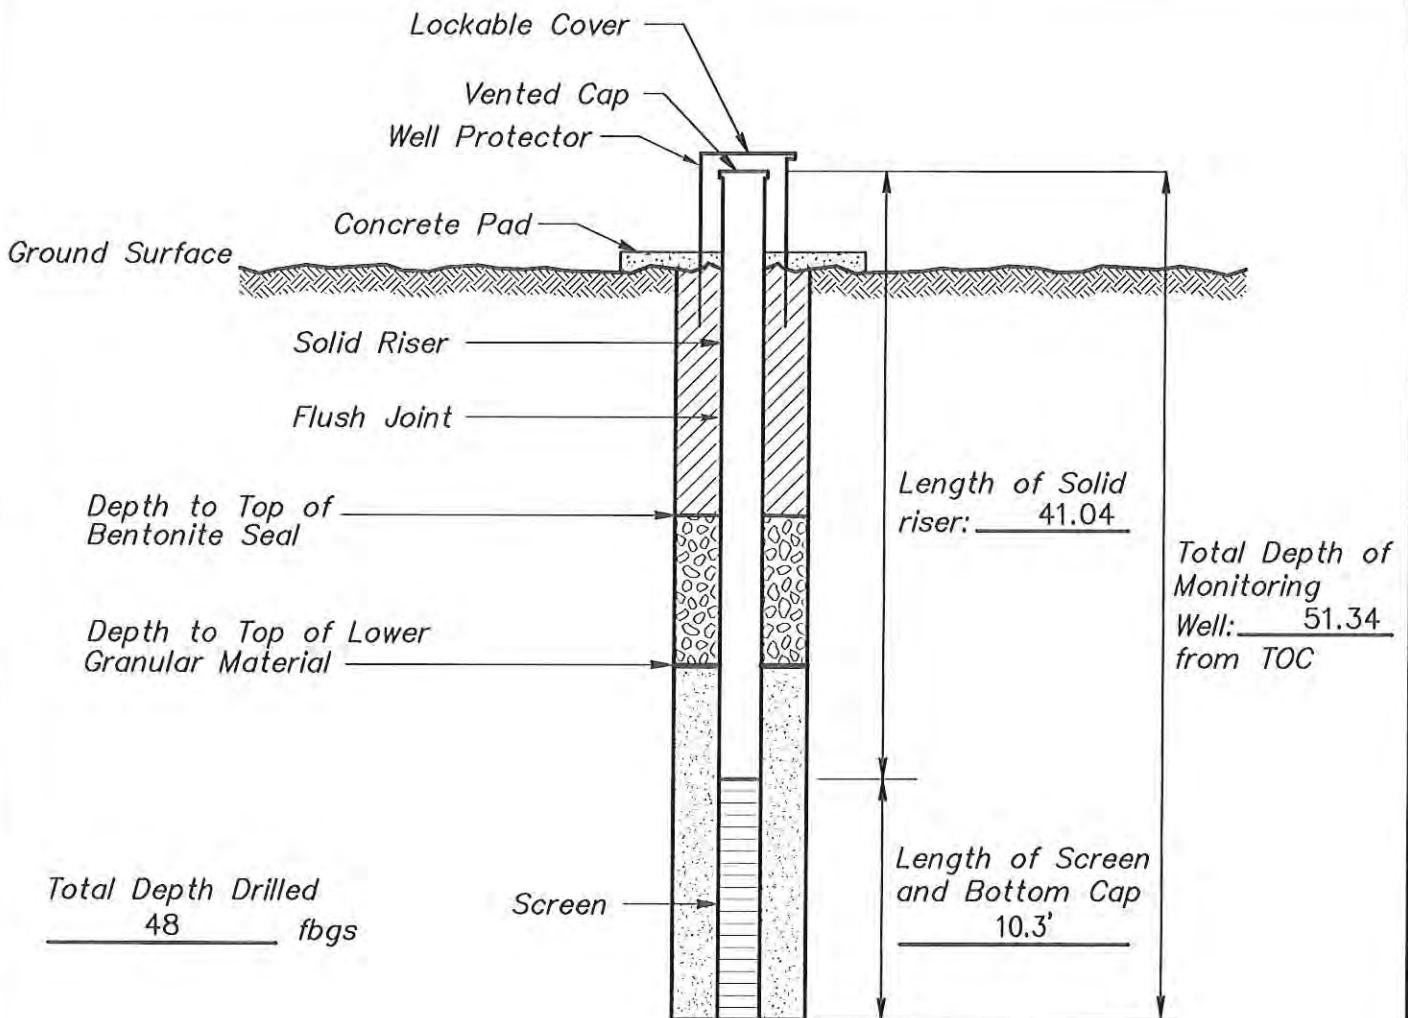

Portland-Bentonite Grout

(Not to Scale)

Bentonite Plug

Granular Backfill Material

Terracon
Consulting Engineers and Scientists

25809 INTERSTATE 30 S
PH (501) 847-9292

ERYANT, AR 72202
FAX (501) 847-9210

MONITORING WELL INSTALLATION RECORD

PROJECT NUMBER: 216-003-35107060


WELL NUMBER: MW-11D

DRAWING NUMBER: 016

CHECKED BY: MR

MONITORING WELL INSTALLATION RECORD

Job Name AEP NORTHEAST STATION HYDROGEOLOGIC INVESTIGATION Well Number MW-12S
 Job Number 35107060 Installation Date 4/19/2010 Location OOLOGAH, OK.
 Datum Elevation 623.50' Surface Elevation 620.65'
 Datum for Water Level Measurement TOP OF CASING
 Screen Diameter & Material 2" PVC Slot Size 0.01"
 Riser Diameter & Material 2" PVC Borehole Diameter 6"
 Granular Backfill Material 12-20 SAND Terracon Representative CLANCY McCLINTOCK
 Drilling Method W.L.C., AIR HAMMER Drilling Contractor MOHAWK

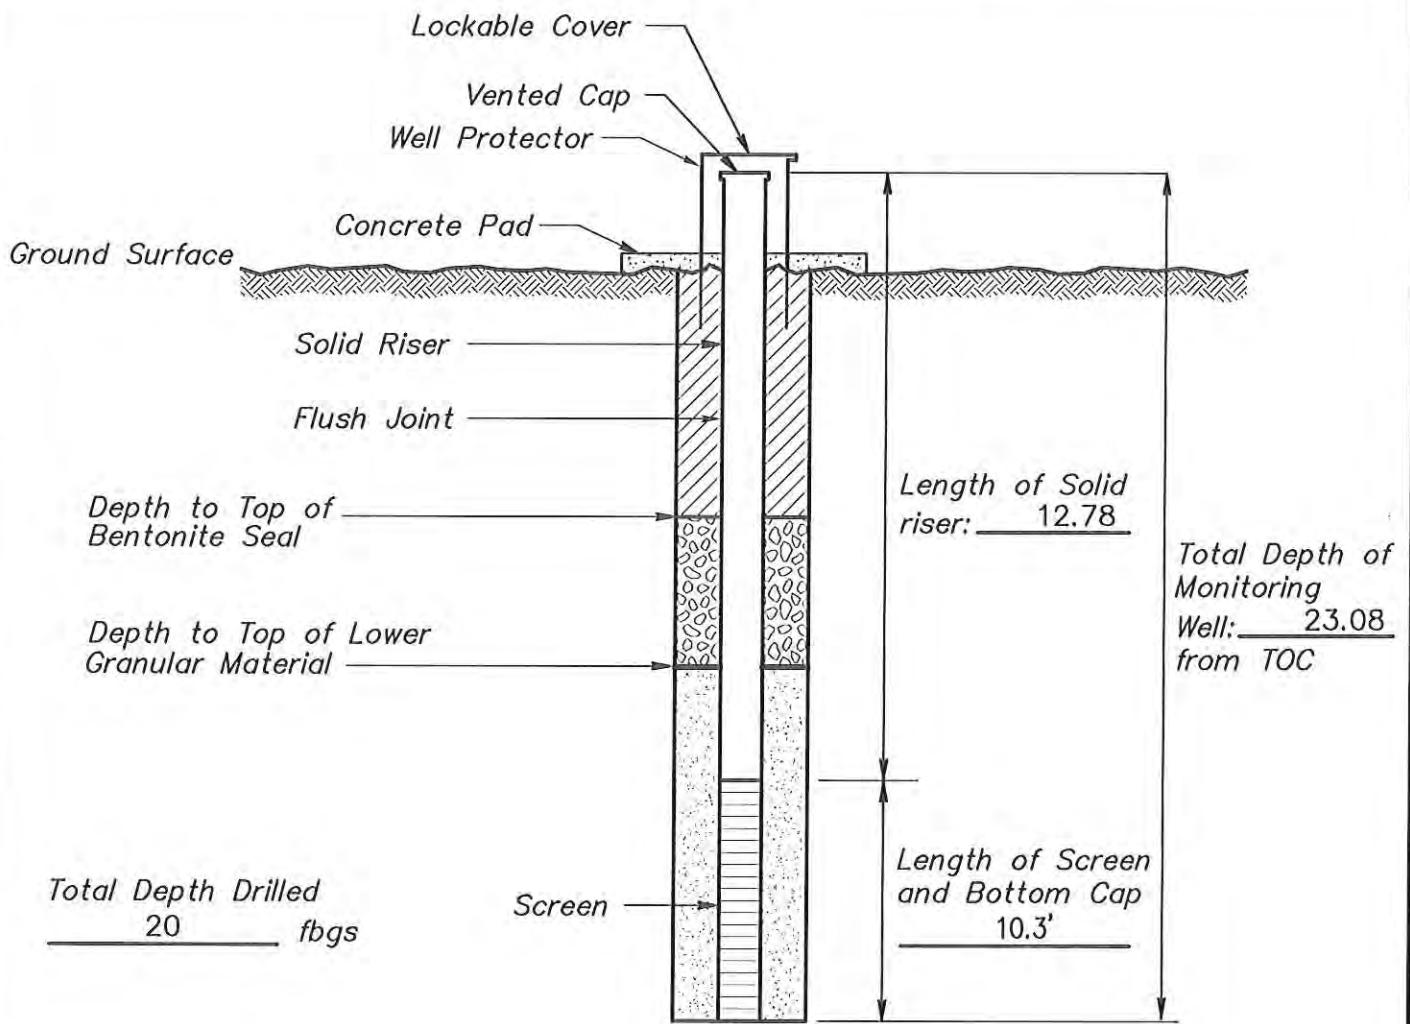

Portland-Bentonite Grout

(Not to Scale)

Bentonite Plug

Granular Backfill Material

Terracon
Consulting Engineers and Scientists

25809 INTERSTATE 30 S
PH. (501) 847-9292

BRYANT, AR 72202
FAX (501) 847-9210

MONITORING WELL INSTALLATION RECORD

PROJECT NUMBER: 216-003-35107060


WELL NUMBER: MW-12S

DRAWING NUMBER: 017

CHECKED BY: MR

MONITORING WELL INSTALLATION RECORD

Job Name AEP NORTHEAST STATION HYDROGEOLOGIC INVESTIGATION Well Number MW-12D
 Job Number 35107060 Installation Date 4/19/2010 Location OOLOGAH, OK.
 Datum Elevation 623.67' Surface Elevation 620.91'
 Datum for Water Level Measurement TOP OF CASING
 Screen Diameter & Material 2" PVC Slot Size 0.01"
 Riser Diameter & Material 2" PVC Borehole Diameter 6"
 Granular Backfill Material 12-20 SAND Terracon Representative CLANCY McCLINTOCK
 Drilling Method W.L.C., AIR HAMMER Drilling Contractor MOHAWK

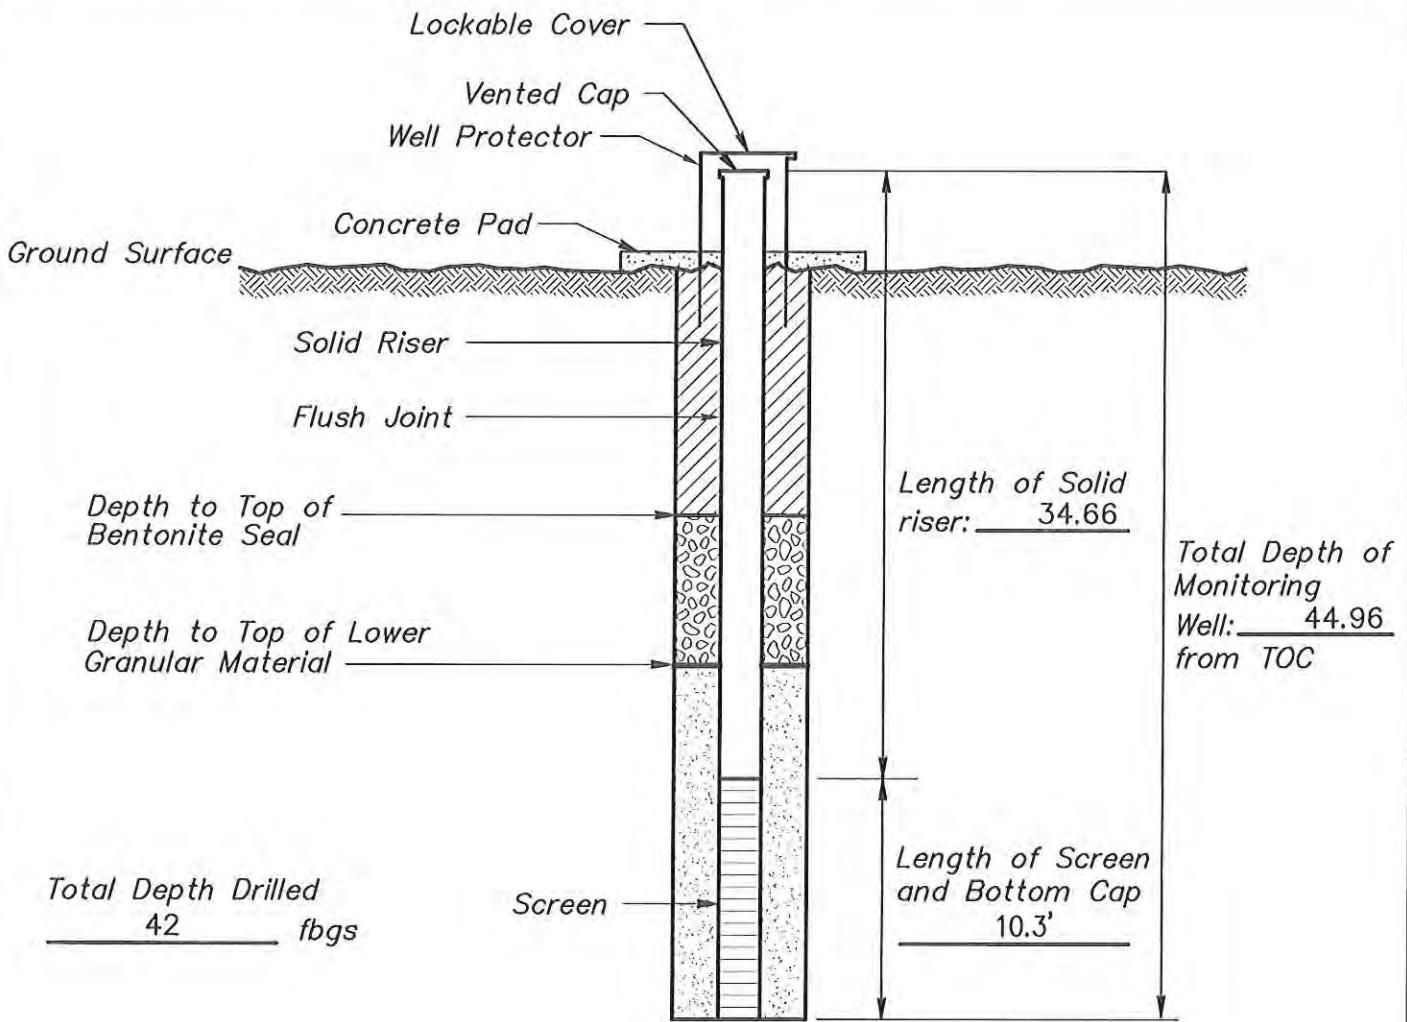

Portland-Bentonite Grout



Bentonite Plug



Granular Backfill Material

(Not to Scale)

Terracon
Consulting Engineers and Scientists

25809 INTERSTATE 30 S
PH. (501) 847-9292

BRYANT, AR 72202
FAX (501) 847-9210

MONITORING WELL INSTALLATION RECORD

PROJECT NUMBER: 216-003-35107060


WELL NUMBER: MW-12D

DRAWING NUMBER: 018

CHECKED BY: MR

MONITORING WELL INSTALLATION RECORD

Job Name AEP NORTHEAST STATION HYDROGEOLOGIC INVESTIGATION Well Number MW-13S
 Job Number 35107060 Installation Date 4/21/2010 Location OOLOGAH, OK.
 Datum Elevation 619.15' Surface Elevation 616.19'
 Datum for Water Level Measurement TOP OF CASING
 Screen Diameter & Material 2" PVC Slot Size 0.01"
 Riser Diameter & Material 2" PVC Borehole Diameter 6"
 Granular Backfill Material 12-20 SAND Terracon Representative CLANCY McCLINTOCK
 Drilling Method W.L.C., AIR HAMMER Drilling Contractor MOHAWK

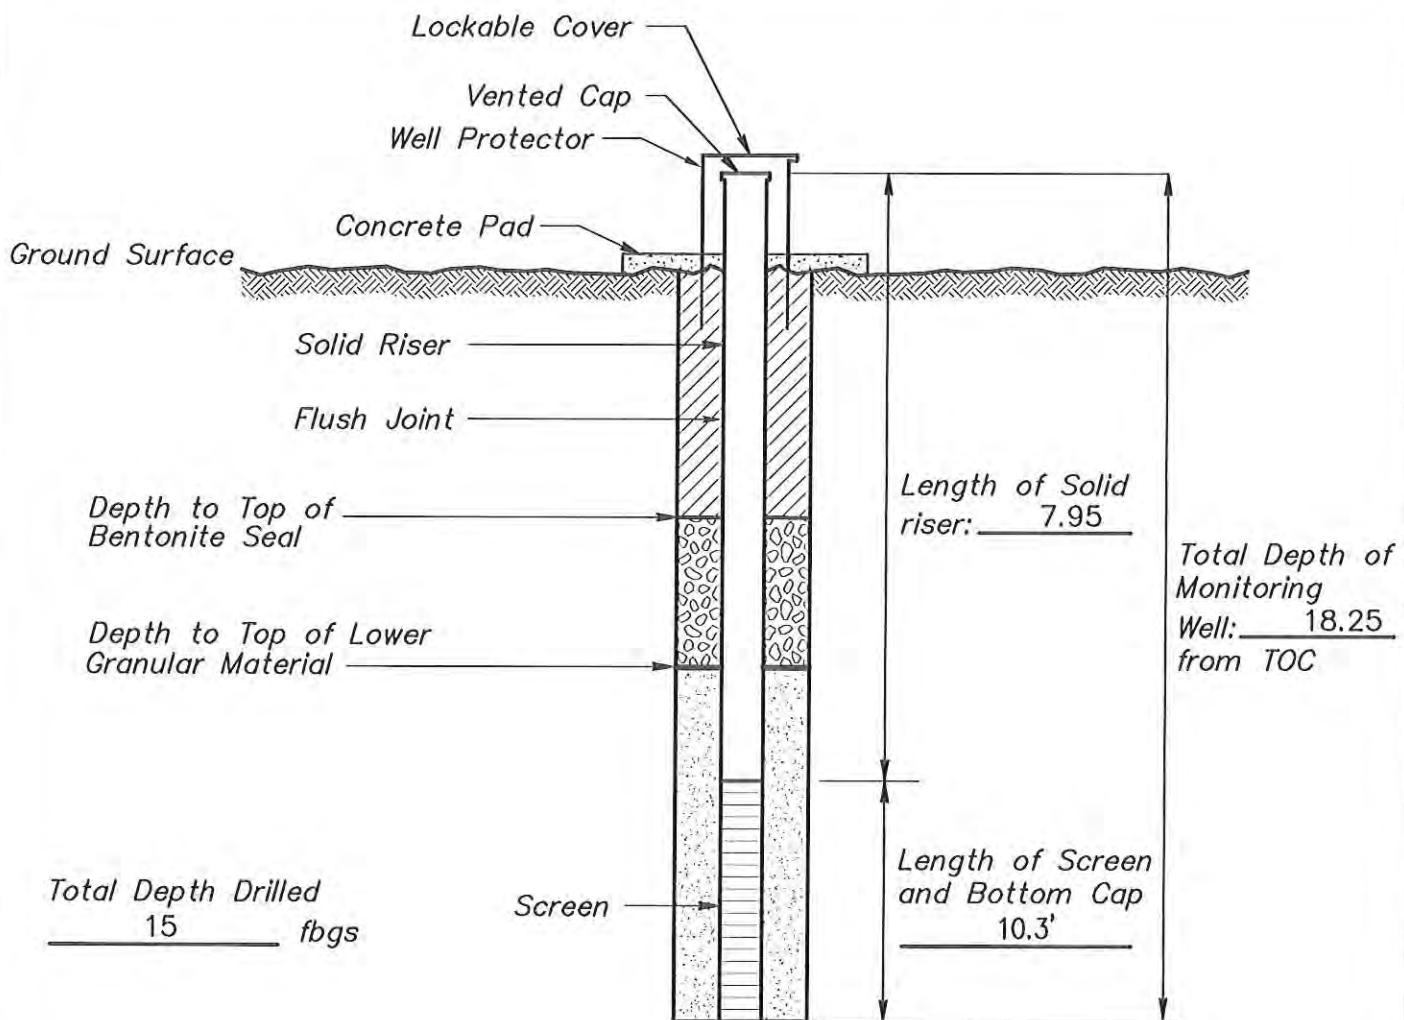

Portland-Bentonite Grout

(Not to Scale)

Bentonite Plug

Granular Backfill Material

Terracon

Consulting Engineers and Scientists

2559 INTERSTATE 30 S
PH. (501) 847-9292

BRYANT, AR 72202
FAX (501) 847-9210

MONITORING WELL INSTALLATION RECORD

PROJECT NUMBER: 216-003-35107060


WELL NUMBER: MW-13S

DRAWING NUMBER: 019

CHECKED BY: MR

MONITORING WELL INSTALLATION RECORD

Job Name AEP NORTHEAST STATION HYDROGEOLOGIC INVESTIGATION Well Number MW-13D
 Job Number 35107060 Installation Date 4/20/2010 Location OOLOGAH, OK.
 Datum Elevation 619.06' Surface Elevation 616.11'
 Datum for Water Level Measurement TOP OF CASING
 Screen Diameter & Material 2" PVC Slot Size 0.01"
 Riser Diameter & Material 2" PVC Borehole Diameter 6"
 Granular Backfill Material 12-20 SAND Terracon Representative CLANCY McCLINTOCK
 Drilling Method W.L.C., AIR HAMMER Drilling Contractor MOHAWK

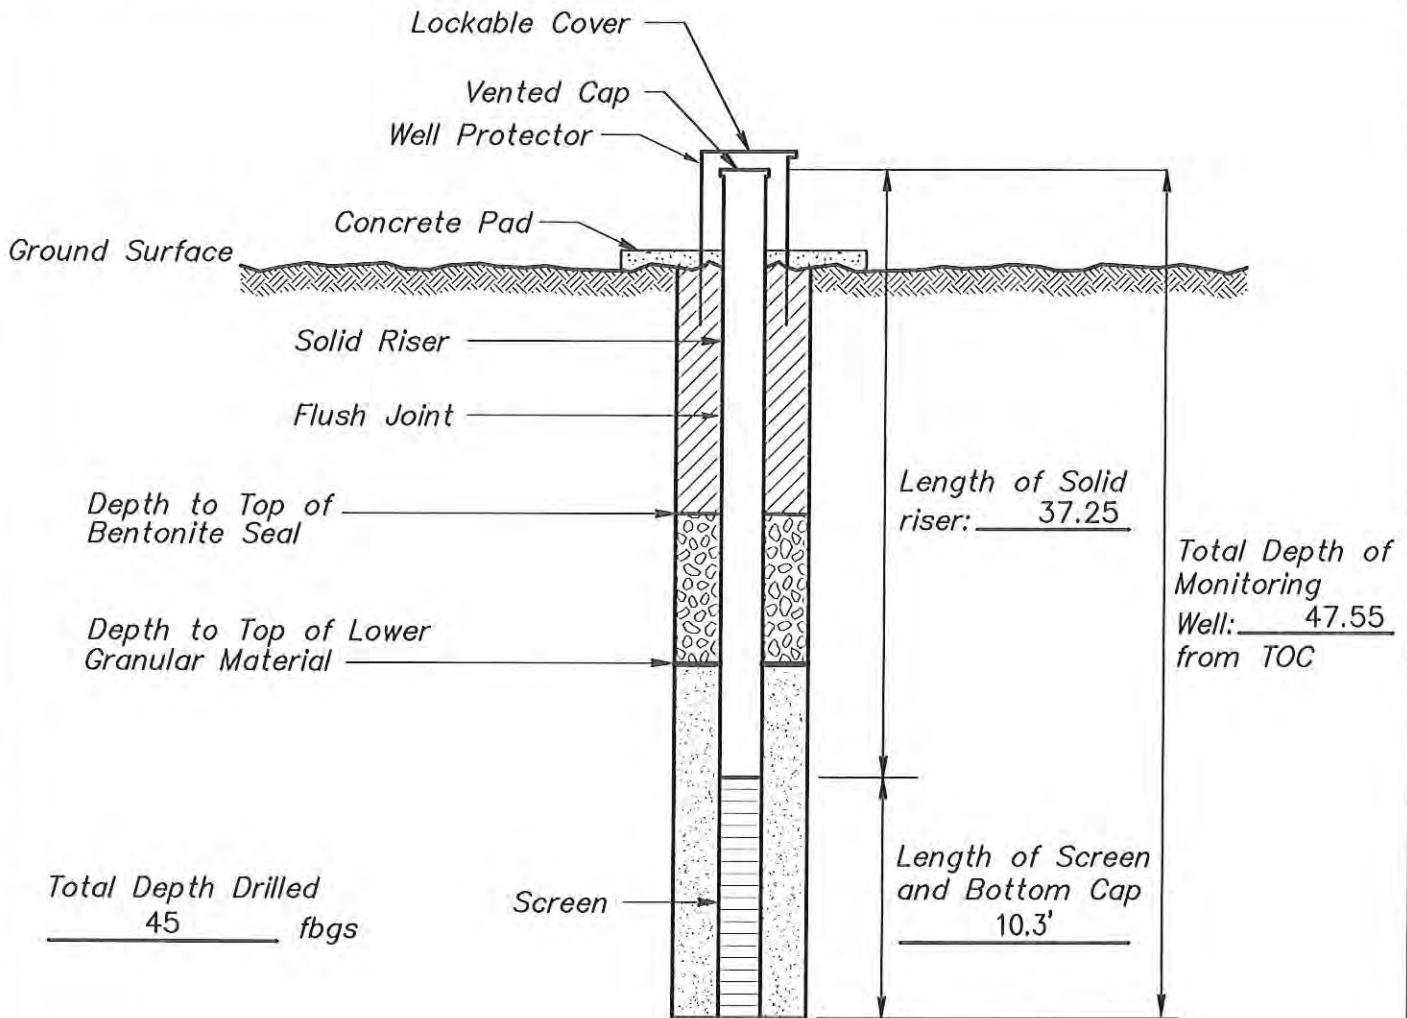

Portland-Bentonite Grout

(Not to Scale)

Bentonite Plug

Granular Backfill Material

Terracon
 Consulting Engineers and Scientists

25809 INTERSTATE 30 S
 PH (501) 847-9292

BRYANT, AR 72202
 FAX (501) 847-9210

MONITORING WELL INSTALLATION RECORD

PROJECT NUMBER: 216-003-35107060


WELL NUMBER: MW-13D

DRAWING NUMBER: 020

CHECKED BY: MR

MONITORING WELL INSTALLATION RECORD

Job Name NORTHEASTERN STATIONS 3+4-CCR WELL INSTALLATION Well Number MW-14
 Job Number 35157183 Installation Date 03/01/15 Location AEP-PSONE STATIONS 3+4
 Datum Elevation N/A Surface Elevation N/A
 Datum for Water Level Measurement T.O.C.
 Screen Diameter & Material 2" PVC Slot Size 0.010
 Riser Diameter & Material 2" PVC Borehole Diameter 8"
 Granular Backfill Material 16/30 SAND Terracon Representative RAH
 Drilling Method HSA AND AIR ROTARY Drilling Contractor AECI

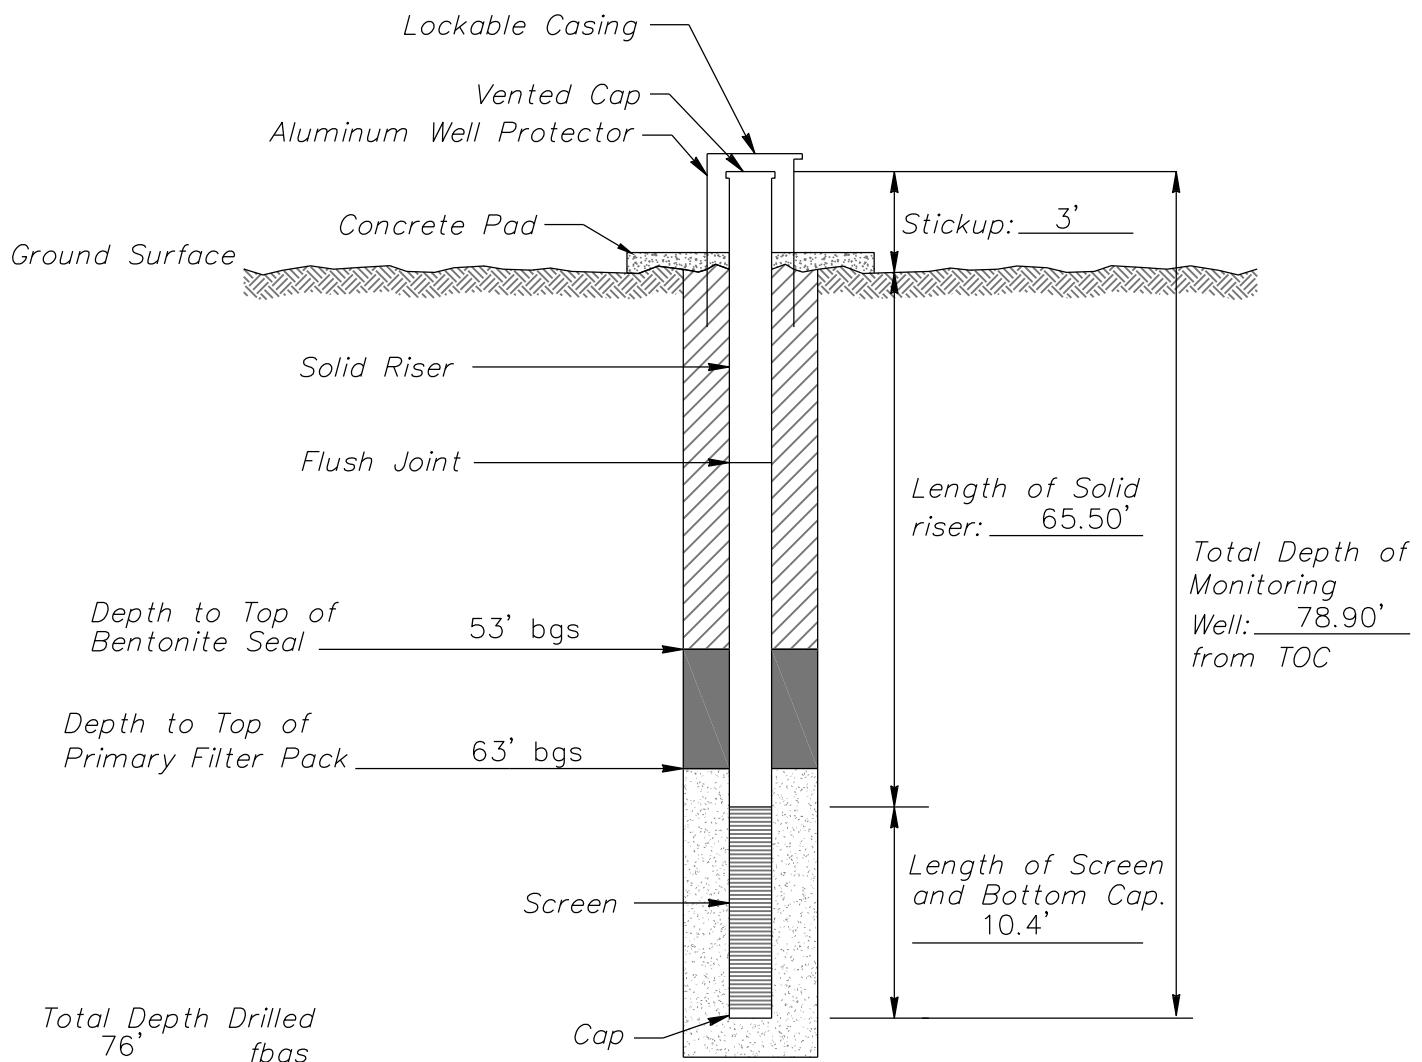

Cement/Bentonite Grout

Bentonite Pellet Plug

Granular Backfill

(Not to Scale)

Terracon
Consulting Engineers and Scientists

25809 I-30 South
PH. (501) 847-9292

BRYANT, AR. 72022
FAX. (501) 847-9210

MONITORING WELL INSTALLATION RECORD

PROJECT NUMBER: 35157183


WELL NUMBER: MW-14

DRAWING NUMBER: 000

CHECKED BY: 00

MONITORING WELL INSTALLATION RECORD

Job Name NORTHEASTERN STATIONS 3+4-CCR WELL INSTALLATION Well Number MW-15
 Job Number 35157183 Installation Date 02/23/16 Location AEP-PSONE STATIONS 3+4
 Datum Elevation N/A Surface Elevation N/A
 Datum for Water Level Measurement T.O.C.
 Screen Diameter & Material 2" PVC Slot Size 0.010
 Riser Diameter & Material 2" PVC Borehole Diameter 8"
 Granular Backfill Material 16/30 SAND Terracon Representative RAH
 Drilling Method HSA AND AIR ROTARY Drilling Contractor AECI

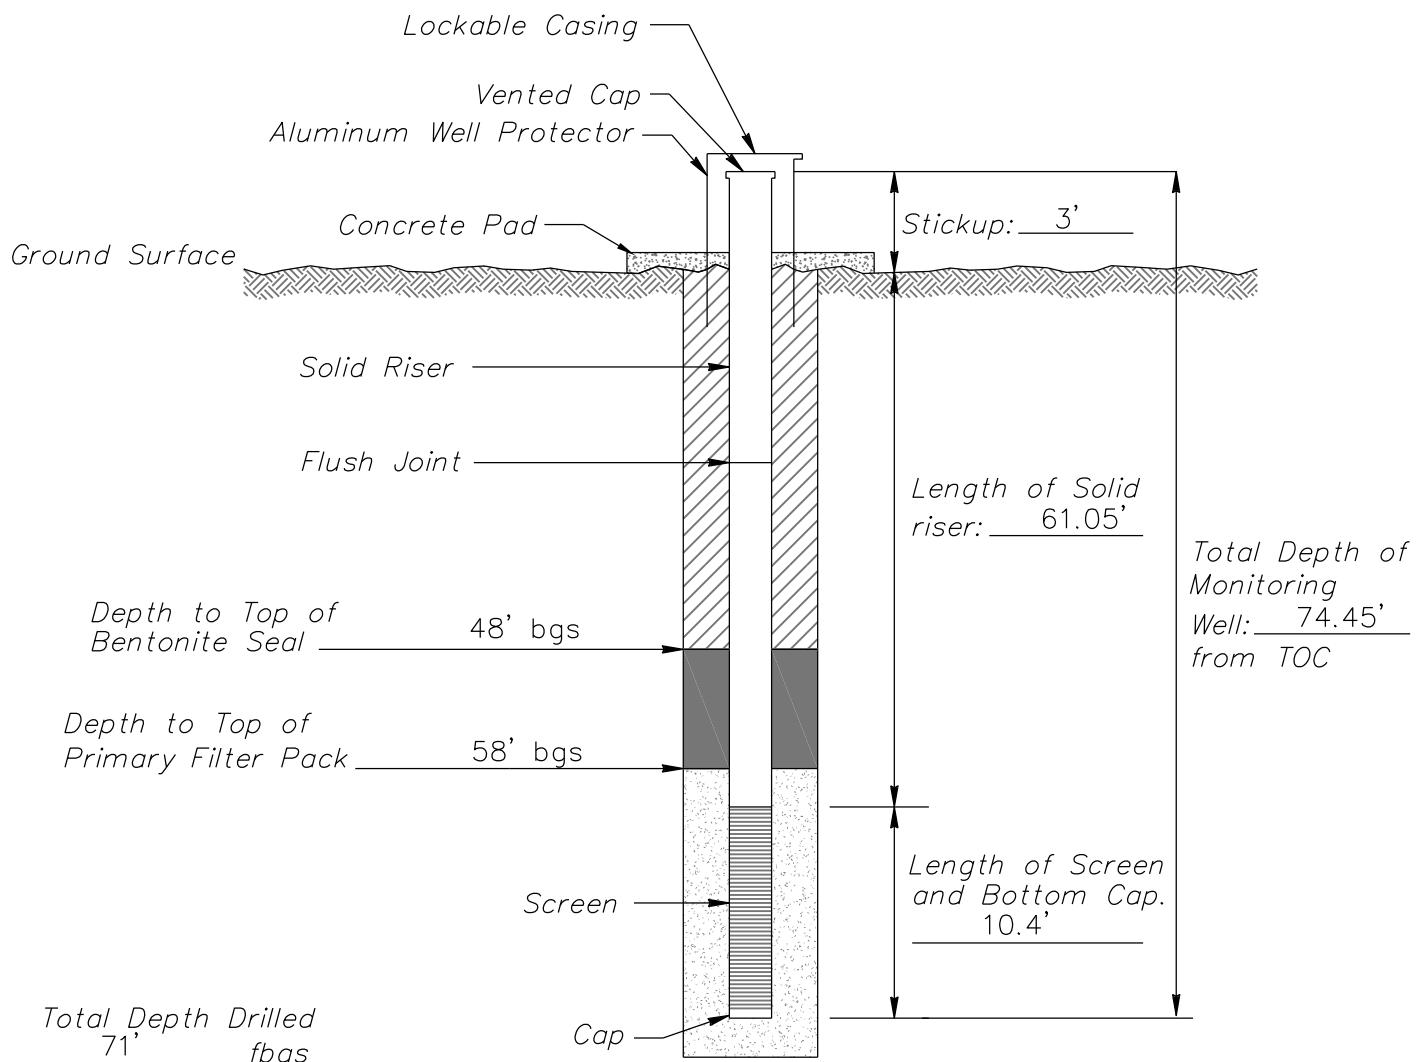

Cement/Bentonite Grout

Bentonite Pellet Plug

Granular Backfill

(Not to Scale)

Terracon
Consulting Engineers and Scientists

25809 I-30 South
PH. (501) 847-9292

BRYANT, AR. 72022
FAX. (501) 847-9210

MONITORING WELL INSTALLATION RECORD

PROJECT NUMBER: 35157183


WELL NUMBER: MW-15

DRAWING NUMBER: 000

CHECKED BY: 00

MONITORING WELL INSTALLATION RECORD

Job Name NORTHEASTERN STATIONS 3+4-CCR WELL INSTALLATION Well Number MW-16
 Job Number 35157183 Installation Date 02/25/16 Location AEP-PSONE STATIONS 3+4
 Datum Elevation N/A Surface Elevation N/A
 Datum for Water Level Measurement T.O.C.
 Screen Diameter & Material 2" PVC Slot Size 0.010
 Riser Diameter & Material 2" PVC Borehole Diameter 8"
 Granular Backfill Material 16/30 SAND Terracon Representative RAH
 Drilling Method HSA AND AIR ROTARY Drilling Contractor AECI

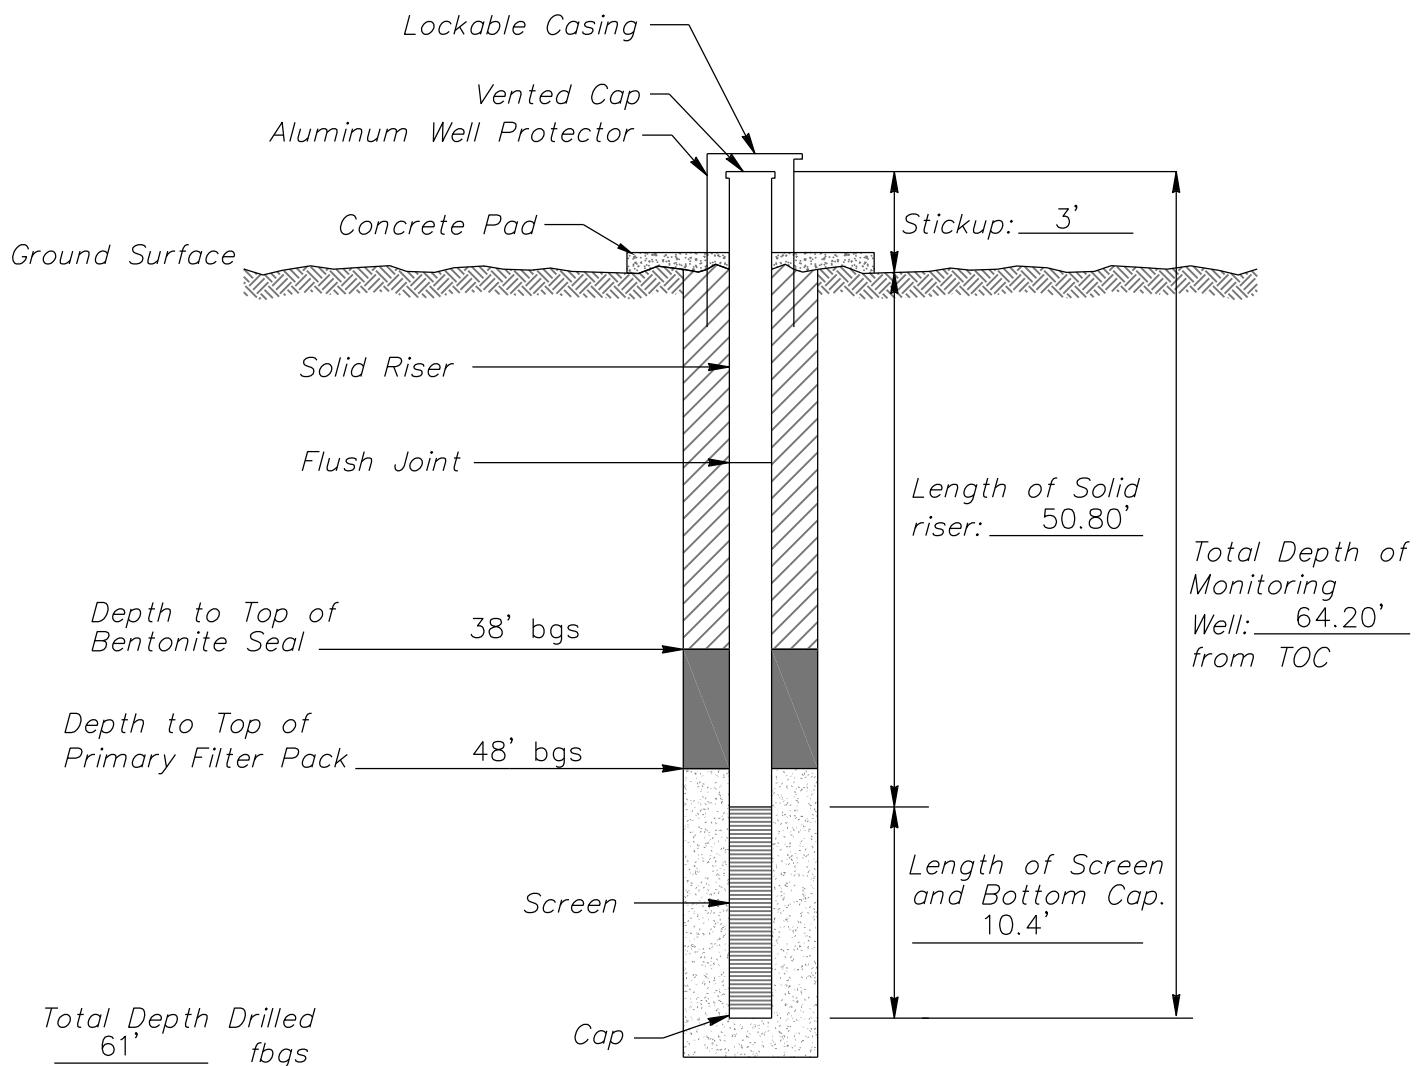

[diagonal hatching] Cement/Bentonite Grout

[solid dark gray] Bentonite Pellet Plug

[cross-hatching] Granular Backfill

(Not to Scale)

Terracon
Consulting Engineers and Scientists

25809 I-30 South
PH. (501) 847-9292

BRYANT, AR. 72022
FAX. (501) 847-9210

MONITORING WELL INSTALLATION RECORD

PROJECT NUMBER: 35157183


WELL NUMBER: MW-16

DRAWING NUMBER: 000

CHECKED BY: 00

MONITORING WELL INSTALLATION RECORD

Job Name NORTHEASTERN STATIONS 3+4-CCR WELL INSTALLATION Well Number MW-17
 Job Number 35157183 Installation Date 02/29/16 Location AEP-PSONE STATIONS 3+4
 Datum Elevation N/A Surface Elevation N/A
 Datum for Water Level Measurement T.O.C.
 Screen Diameter & Material 2" PVC Slot Size 0.010
 Riser Diameter & Material 2" PVC Borehole Diameter 8"
 Granular Backfill Material 16/30 SAND Terracon Representative RAH
 Drilling Method HSA AND AIR ROTARY Drilling Contractor AECI

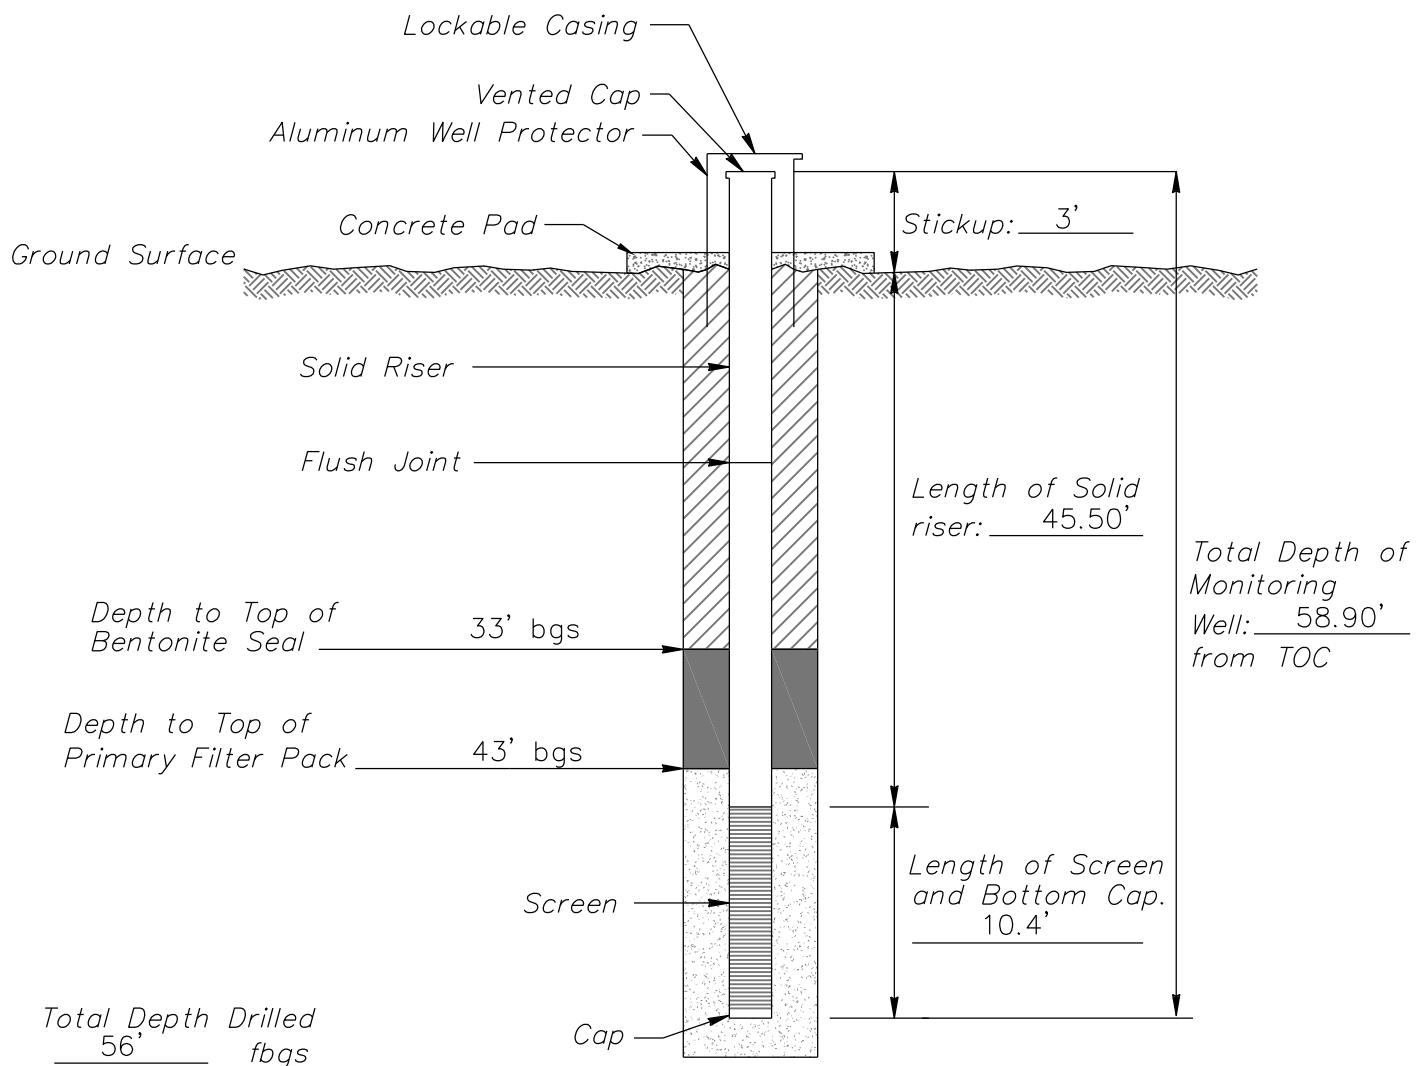

Cement/Bentonite Grout

Bentonite Pellet Plug

Granular Backfill

(Not to Scale)

Terracon
Consulting Engineers and Scientists

25809 I-30 South
PH. (501) 847-9292

BRYANT, AR. 72022
FAX. (501) 847-9210

MONITORING WELL INSTALLATION RECORD

PROJECT NUMBER: 35157183


WELL NUMBER: MW-17

DRAWING NUMBER: 000


CHECKED BY: 00

APPENDIX 2


Geologic Cross Sections

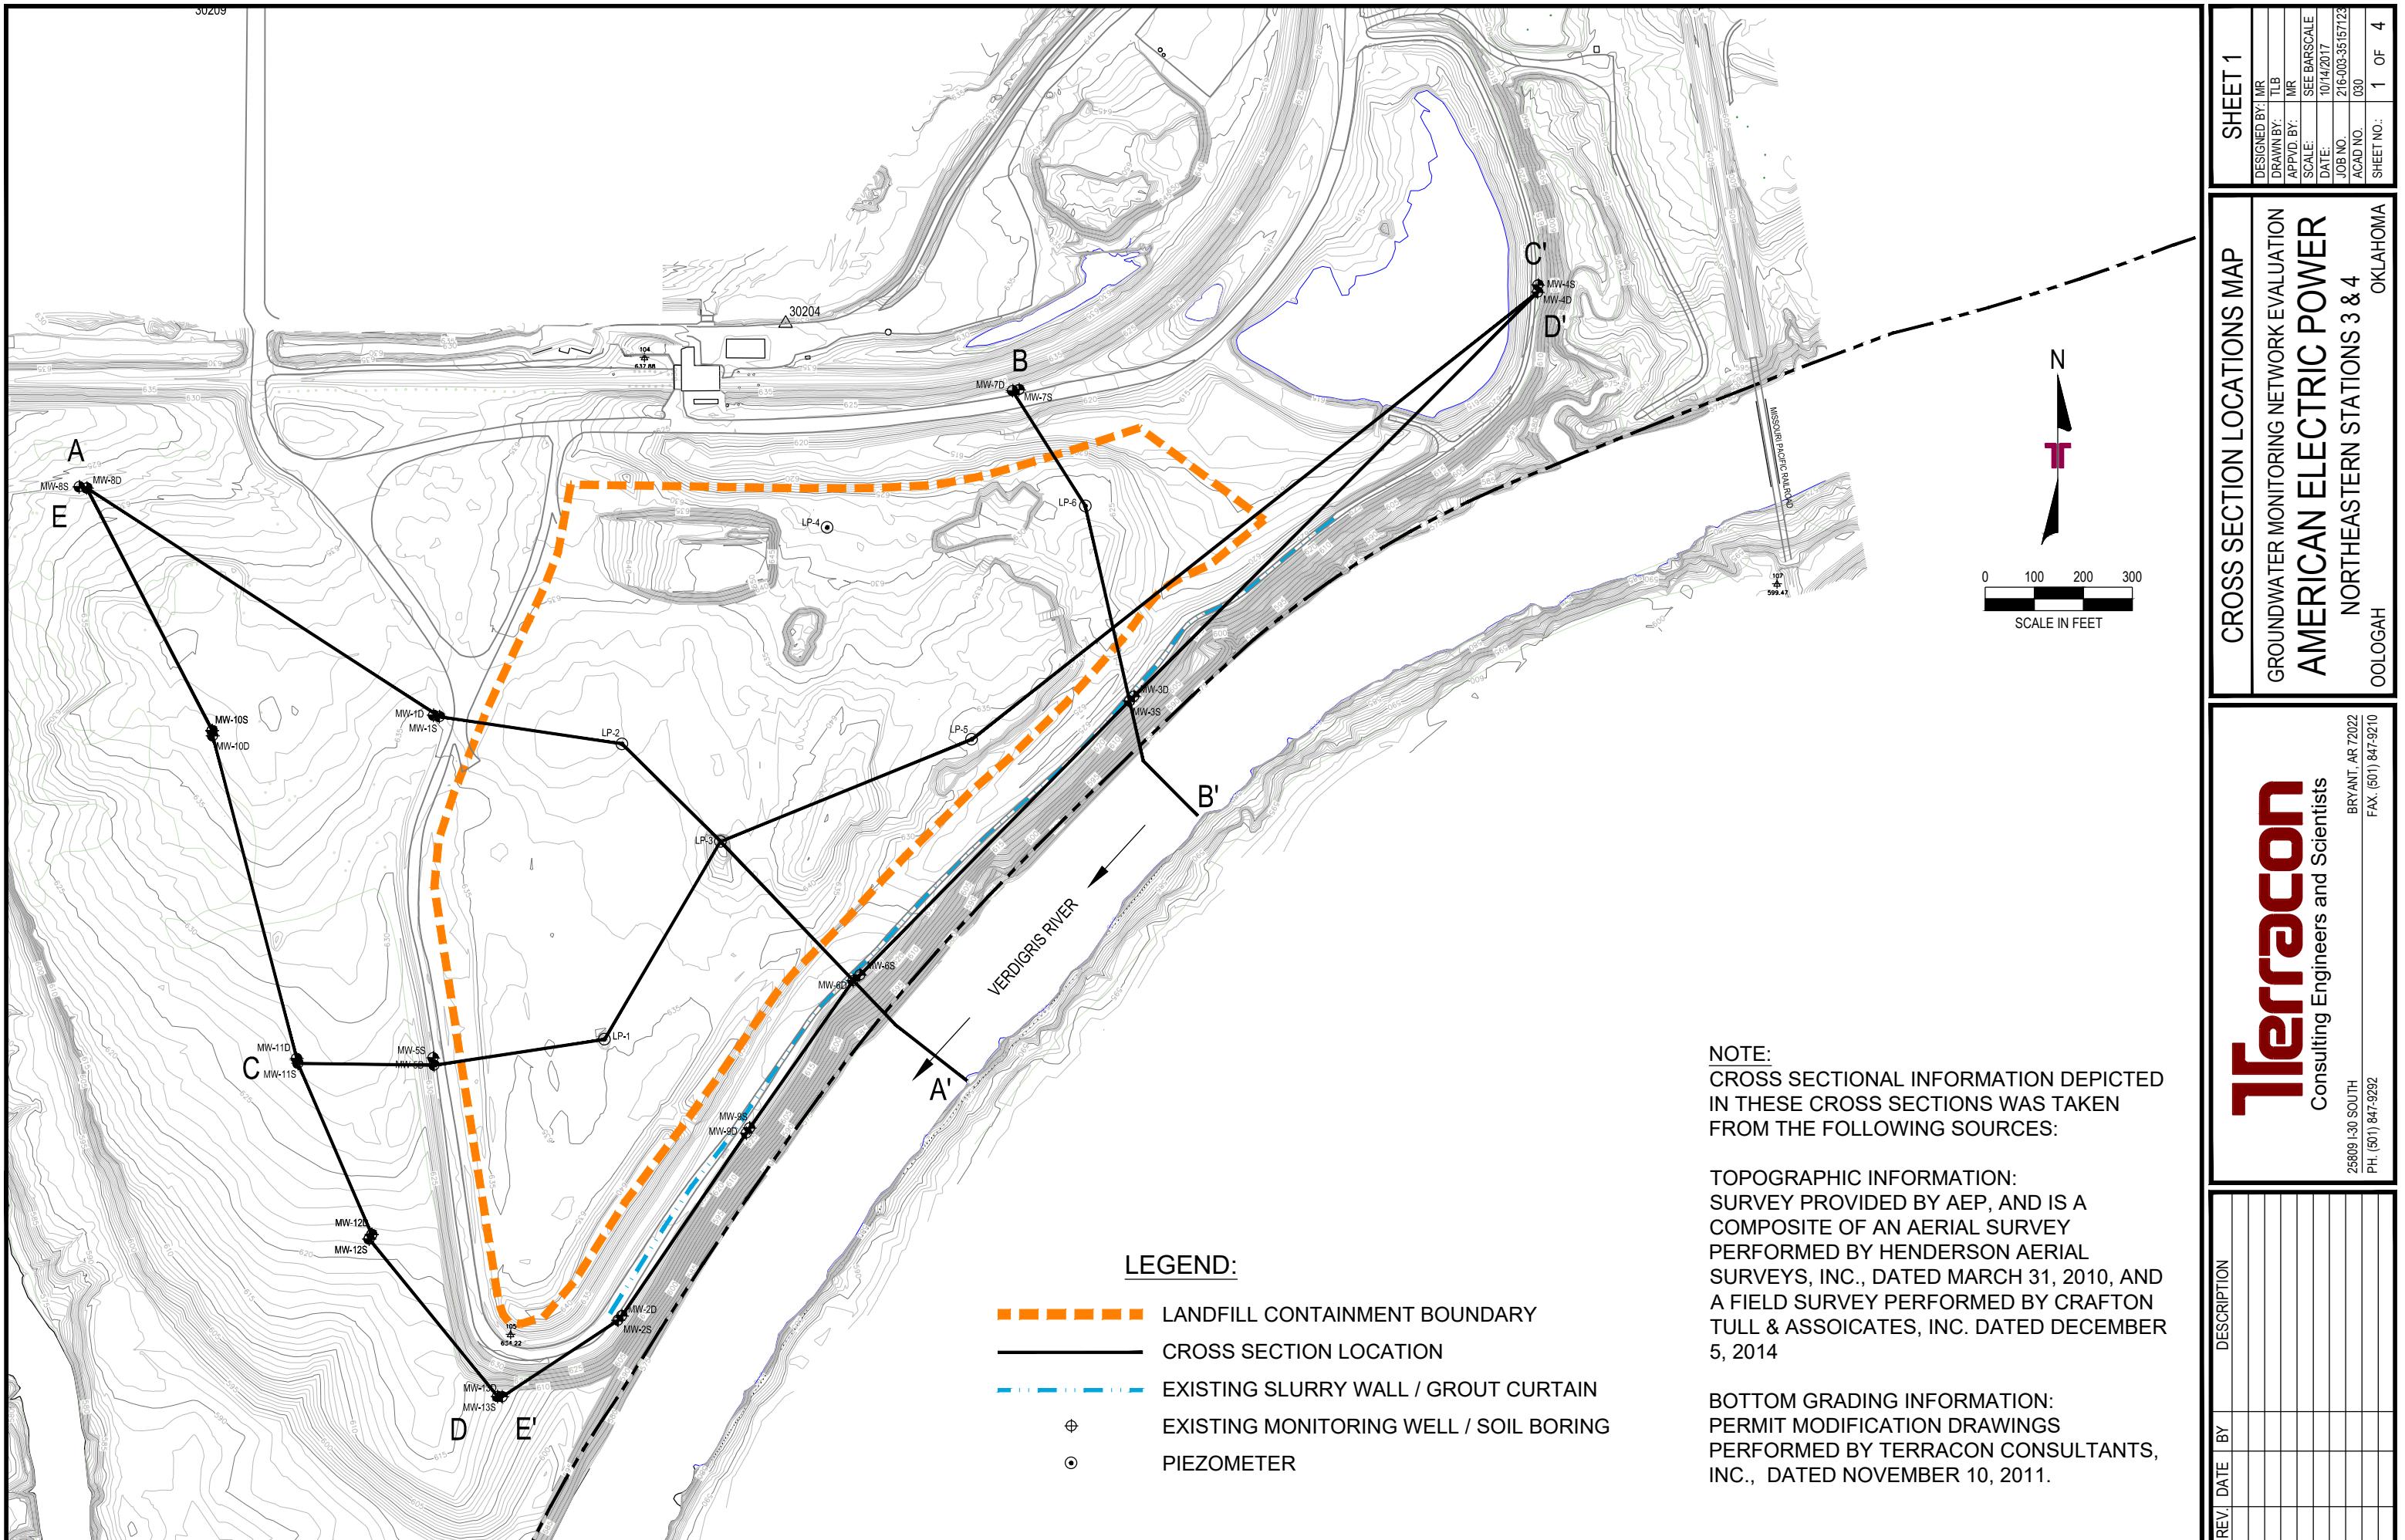


ELEVATION

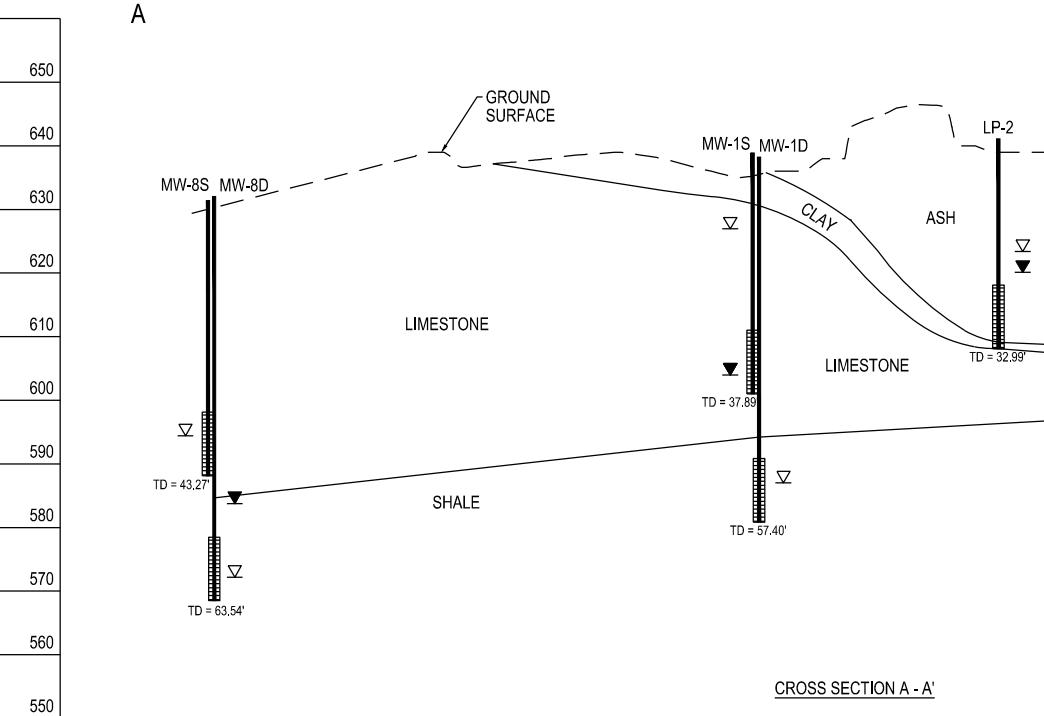

ELEVATION

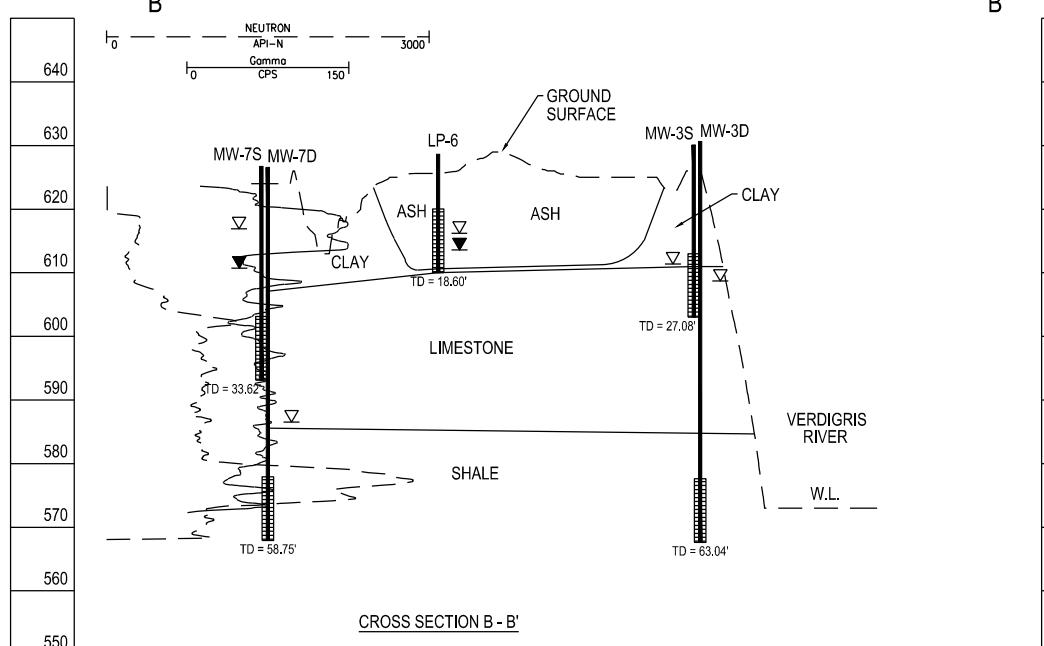

ELEVATION

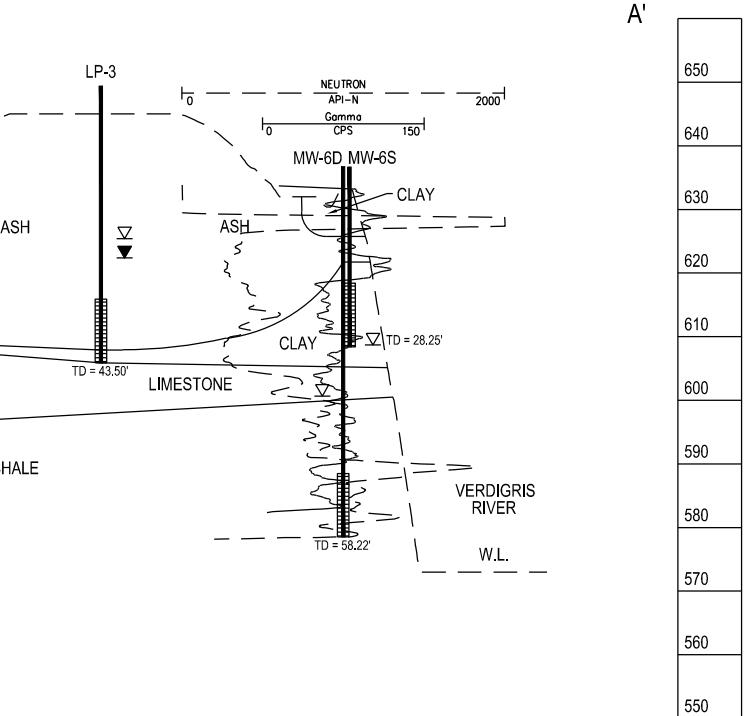

ELEVATION

LEGEND:

- ▽ STATIC WATER LEVEL (11-11-08)
- ▼ GROUNDWATER ENCOUNTERED WHILE DRILLING
- ▨ SCREENED INTERVAL OF WELL

SCALES:

1" = 300' (HORIZONTAL)
 1" = 30' (VERTICAL)
 VERTICAL EXAGGERATION = x 10

NOTE: GROUNDWATER WAS NOT OBSERVED DURING DRILLING ACTIVITIES IN MW-1D, MW-3S, MW-3D, MW-6S, MW-6D, MW-7D, AND MW-8S.

NOTE: TOTAL DEPTHS ARE MEASURED FROM TOP OF CASING

NOTE: CROSS SECTIONAL INFORMATION DEPICTED IN THESE CROSS SECTIONS WAS TAKEN FROM THE FOLLOWING SOURCES:

TOPOGRAPHIC INFORMATION:
 SURVEY PROVIDED BY AEP, AND IS A COMPOSITE OF AN AERIAL SURVEY PERFORMED BY HENDERSON AERIAL SURVEYS, INC., DATED MARCH 31, 2010, AND A FIELD SURVEY PERFORMED BY CRAFTON TULL & ASSOCIATES, INC. DATED DECEMBER 5, 2014

BOTTOM GRADING INFORMATION:
 PERMIT MODIFICATION DRAWINGS PERFORMED BY TERRACON CONSULTANTS, INC., DATED NOVEMBER 10, 2011.

REV. DATE BY DESCRIPTION

10/13/17 216-003-35157123 031

CROSS SECTIONS A-A' & B-B'

GROUNDWATER MONITORING NETWORK EVALUATION
AMERICAN ELECTRIC POWER
 NORTHEASTERN STATIONS 3 & 4
 Oologah, Oklahoma

SHEET 2


DESIGNED BY: MR
 DRAWN BY: TLB
 APPROVED BY: MR
 SEE BAR SCALE
 DATE: 10/13/17
 JOB NO.: 216-003-35157123
 ACAD NO.: 031
 SHEET NO.: 2 OF 4

Terracon
 Consulting Engineers and Scientists

BRYANT, AR 72022
 25809 1-30 SOUTH
 PH. (501) 847-9292
 FAX. (501) 847-9210

ELEVATION


650
640
630
620
610
600
590
580
570
560
550
540

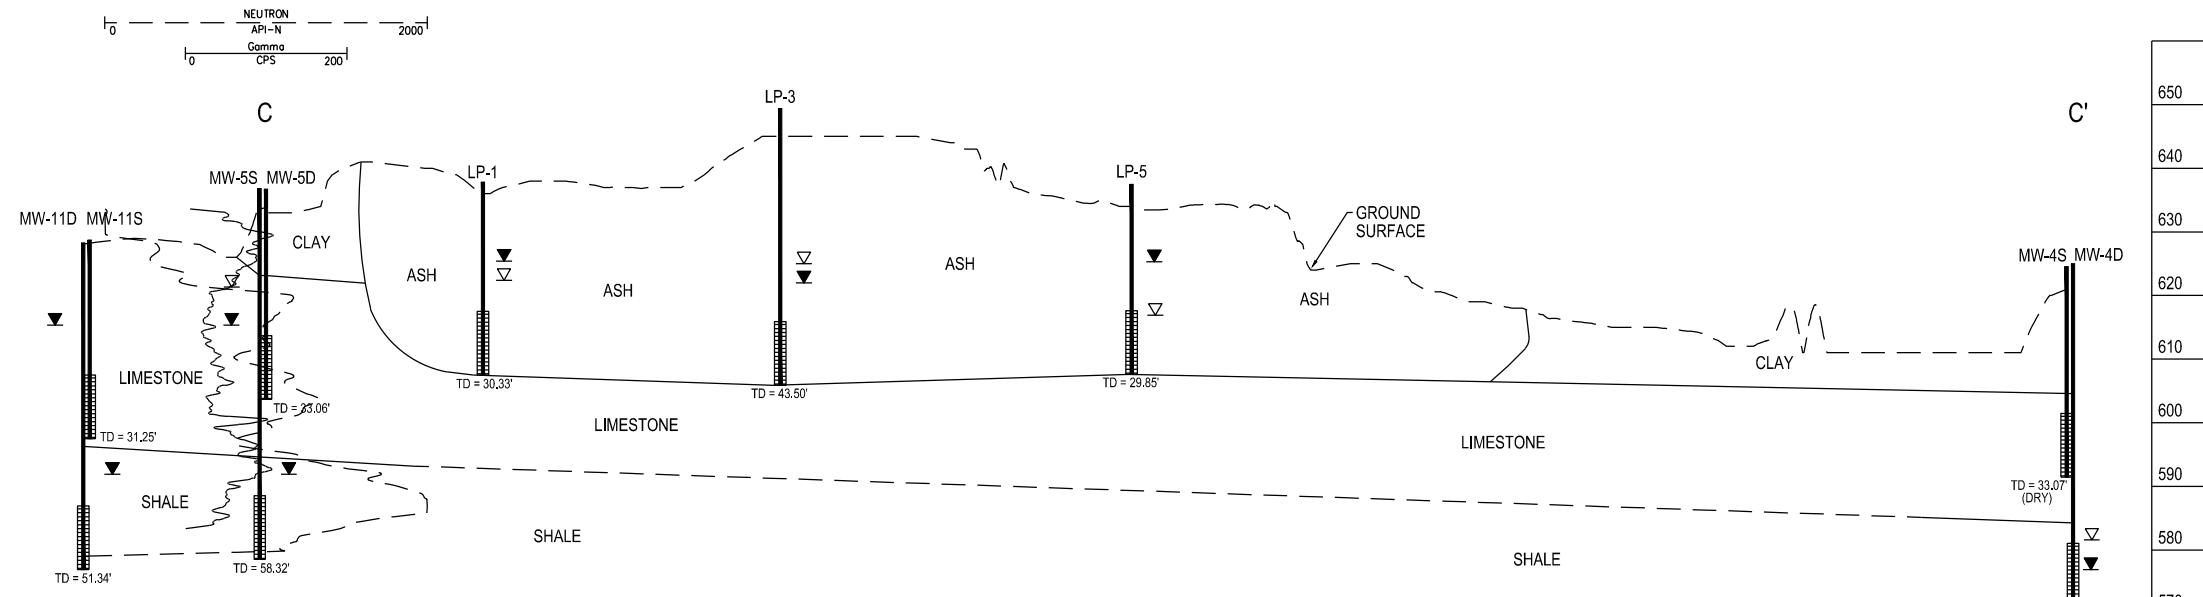

CROSS SECTION C - C'

ELEVATION

640
630
620
610
600
590
580
570
560
550

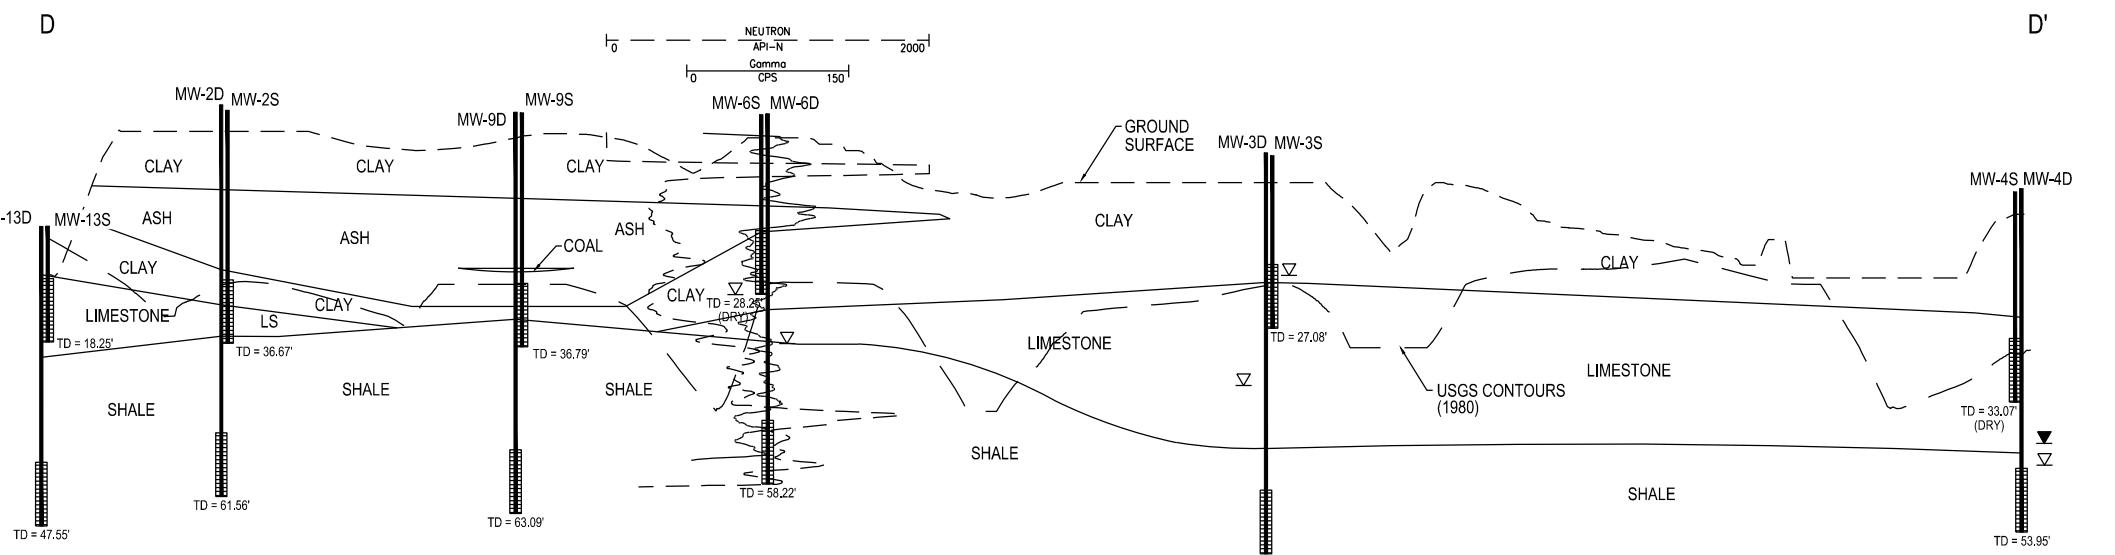

CROSS SECTION D - D'

LEGEND:

- STATIC WATER LEVEL (11-11-08)
- ▼ GROUNDWATER ENCOUNTERED WHILE DRILLING
- |||| SCREENED INTERVAL OF WELL

SCALES:

1" = 300' (HORIZONTAL)
1" = 30' (VERTICAL)
VERTICAL EXAGGERATION = x 10

NOTE: GROUNDWATER WAS NOT OBSERVED DURING DRILLING ACTIVITIES IN MW-2D, MW-3S, MW-3D, MW-4S, MW-6S, MW-6D, MW-13S, AND MW-13D

NOTE: TOTAL DEPTHS ARE MEASURED FROM TOP OF CASING

NOTE:

CROSS SECTIONAL INFORMATION DEPICTED IN THESE CROSS SECTIONS WAS TAKEN FROM THE FOLLOWING SOURCES:

TOPOGRAPHIC INFORMATION:

SURVEY PROVIDED BY AEP, AND IS A COMPOSITE OF AN AERIAL SURVEY PERFORMED BY HENDERSON AERIAL SURVEYS, INC., DATED MARCH 31, 2010, AND A FIELD SURVEY PERFORMED BY CRAFTON TULL & ASSOCIATES, INC. DATED DECEMBER 5, 2014

BOTTOM GRADING INFORMATION:

PERMIT MODIFICATION DRAWINGS PERFORMED BY TERRACON CONSULTANTS, INC., DATED NOVEMBER 10, 2011.

USGS CONTOURS TAKEN FROM THE Oologah, Oklahoma Quadrangle 1970 (REVISED 1980)

ELEVATION

650
640
630
620
610
600
590
580
570
560
550
540

CROSS SECTIONS C-C' & D-D'		SHEET 3	
DESIGNED BY:	MR	DRAWN BY:	TLB
APPROVED BY:	MR	SEE BAR SCALE:	10/13/17
SCALE:	1:2000	DATE:	10/13/17
JOB NO.:	216-003-35157123	ACAD NO.:	032
SHEET NO.:	3	OF	4


GROUNDWATER MONITORING NETWORK EVALUATION
AMERICAN ELECTRIC POWER
NORTHEASTERN STATIONS 3 & 4
Oologah, Oklahoma

Terracon
Consulting Engineers and Scientists
25809 1-30 SOUTH
PH. (501) 847-9292

BRYANT, AR 72022
FAX. (501) 847-9210

REV.	DATE	BY	DESCRIPTION

ELEVATION

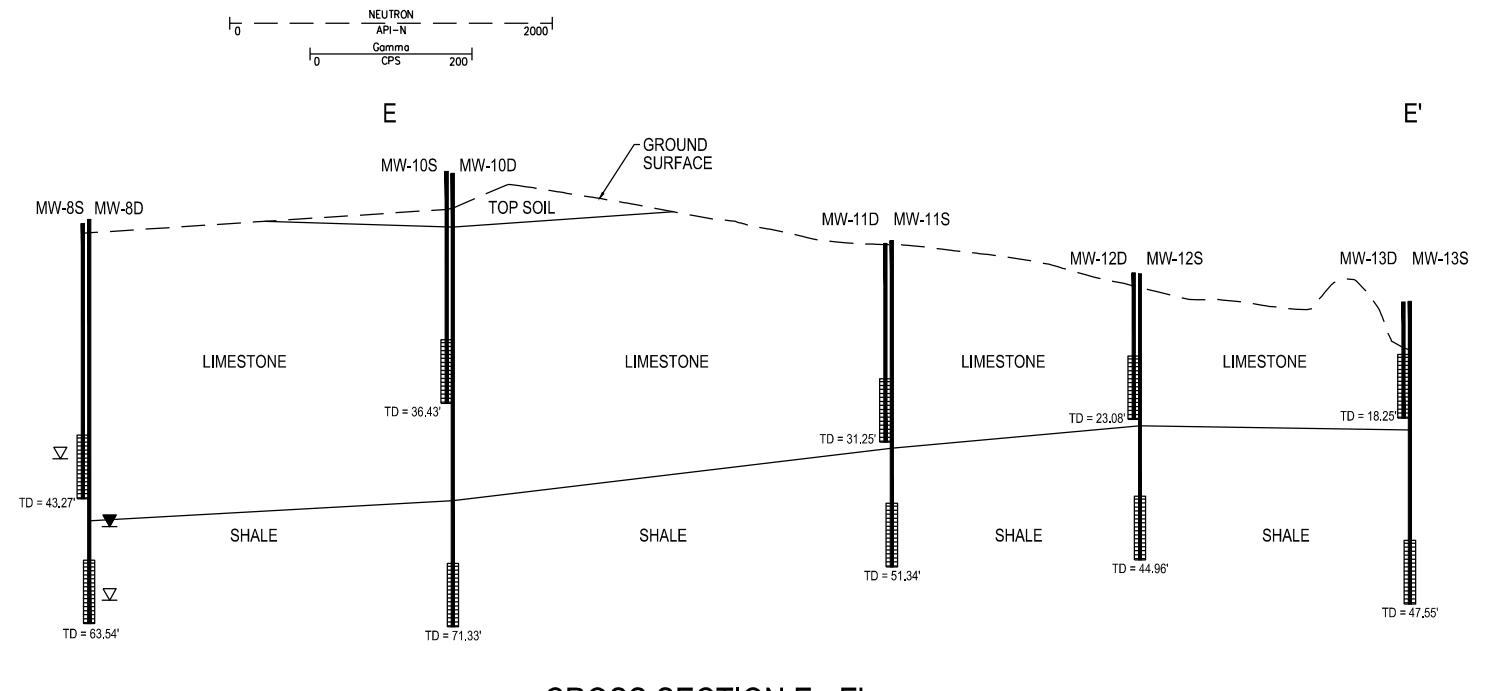

CROSS SECTION E - E'

ELEVATION

LEGEND:

- STATIC WATER LEVEL (11-11-08)
- ▼ GROUNDWATER ENCOUNTERED WHILE DRILLING
- SCREENED INTERVAL OF WELL

SCALES:

1" = 300' (HORIZONTAL)
1" = 30' (VERTICAL)
VERTICAL EXAGGERATION = x 10

NOTE: GROUNDWATER WAS NOT OBSERVED DURING DRILLING ACTIVITIES IN MW-2D, MW-10, MW-11, MW-12, AND MW-13

NOTE: TOTAL DEPTHS ARE MEASURED FROM TOP OF CASING

NOTE:
CROSS SECTIONAL INFORMATION DEPICTED IN THESE CROSS SECTIONS WAS TAKEN FROM THE FOLLOWING SOURCES:

TOPOGRAPHIC INFORMATION:
SURVEY PROVIDED BY AEP, AND IS A COMPOSITE OF AN AERIAL SURVEY PERFORMED BY HENDERSON AERIAL SURVEYS, INC., DATED MARCH 31, 2010, AND A FIELD SURVEY PERFORMED BY CRAFTON TULL & ASSOCIATES, INC. DATED DECEMBER 5, 2014

BOTTOM GRADING INFORMATION:
PERMIT MODIFICATION DRAWINGS PERFORMED BY TERRACON CONSULTANTS, INC., DATED NOVEMBER 10, 2011.

REV.	DATE	BY	DESCRIPTION

CROSS SECTIONS E-E'			
GROUNDWATER MONITORING NETWORK EVALUATION			
AMERICAN ELECTRIC POWER			
NORTHEASTERN STATIONS 3 & 4			
OKLAHOMA Oologah			
SHEET 4			
DESIGNED BY:	MR	DRAWN BY:	TLB
APPROVED BY:	MR	SEE BAR SCALE	
SCALE:		DATE:	10/13/2017
JOB NO.:	216-003-35157123	ACAD NO.:	033
SHEET NO.:	4	OF	4

Terracon
Consulting Engineers and Scientists

BRYANT, AR 72022
FAX: (501) 847-9210
25809 1-30 SOUTH
PH: (501) 847-9292


APPENDIX 3

Downhole Geophysics

 GAMMA-CONDUCTIVITY-NEUTRON MW-14		AMERICAN ELECTRIC POWER																																																																																																																								
		COMPANY : AMERICAN ELECTRIC POWER	WELL : MW-14																																																																																																																							
		WELL EXT : NA	FIELD : NA																																																																																																																							
		COUNTY : ROGERS	STATE : OKLAHOMA																																																																																																																							
		COUNTRY : USA	API NO. : N/A																																																																																																																							
		UNIQUID : N/A	SECTION: N/A TOWNSHIP: N/A RANGE: N/A																																																																																																																							
		LOCATION : N/A	LATITUDE : N/A																																																																																																																							
		LONGITUDE : N/A																																																																																																																								
DISPLAY7_JL38																																																																																																																										
<table border="1"> <thead> <tr> <th rowspan="2">PERMANENT DATUM</th> <th colspan="3">Elevations:</th> <th rowspan="2">Other Services:</th> </tr> <tr> <th>GL</th> <th>KD</th> <th>DF</th> <th>FT</th> </tr> </thead> <tbody> <tr> <td>DRL MEASURED FROM LOG PERM. DATUM</td> <td>N/A</td> <td>N/A</td> <td>N/A</td> <td>N/A</td> </tr> <tr> <td>DATE DEPTH DRILLER</td> <td>95/04/16</td> <td>12.57</td> <td>FT</td> <td>FT</td> </tr> <tr> <td>DEPTH LOGGER</td> <td></td> <td></td> <td></td> <td></td> </tr> <tr> <td>FIRST READING</td> <td></td> <td></td> <td></td> <td></td> </tr> <tr> <td>BIT SIZE</td> <td></td> <td>4</td> <td></td> <td></td> </tr> <tr> <td>CASING - DRILLER</td> <td></td> <td>78</td> <td>FT</td> <td>FT</td> </tr> <tr> <td>CASING - LOGGER</td> <td></td> <td>2.0</td> <td>IN</td> <td>IN</td> </tr> <tr> <td>CASING THICKNESS</td> <td></td> <td></td> <td></td> <td></td> </tr> <tr> <td>CASING TYPE</td> <td></td> <td>PVC</td> <td></td> <td></td> </tr> <tr> <td>FLUID TYPE</td> <td></td> <td>DRILL M</td> <td>LB/GAL</td> <td></td> </tr> <tr> <td>FLUID DENSITY</td> <td></td> <td>8.3</td> <td></td> <td></td> </tr> <tr> <td>FLUID VISCOSITY</td> <td></td> <td></td> <td></td> <td></td> </tr> <tr> <td>FLUID PH</td> <td></td> <td></td> <td></td> <td></td> </tr> <tr> <td>MUD SOURCE</td> <td></td> <td>N/A</td> <td></td> <td></td> </tr> <tr> <td>RNF @ MEAS TEMP</td> <td></td> <td>N/A @ N/A F</td> <td></td> <td></td> </tr> <tr> <td>RNF @ MEAS TEMP</td> <td></td> <td>@ F</td> <td></td> <td></td> </tr> <tr> <td>RNC @ MEAS TEMP</td> <td></td> <td>N/A @ F</td> <td></td> <td></td> </tr> <tr> <td>CIRC STOPPED</td> <td></td> <td>N/A</td> <td></td> <td></td> </tr> <tr> <td>RECORDED BY</td> <td colspan="3">R HECK</td> <td></td> </tr> <tr> <td>REMARKS 1</td> <td colspan="3">9510.9068</td> <td></td> </tr> <tr> <td>REMARKS 2</td> <td colspan="3">LOG MEASURED -36.25 INCHES /-3.02 FT TOP OF CASING</td> <td></td> </tr> <tr> <td>REMARKS 3</td> <td colspan="3">ALL SERVICES PROVIDED SUBJECT TO STANDARD TERMS AND CONDITIONS</td> <td></td> </tr> </tbody> </table>				PERMANENT DATUM	Elevations:			Other Services:	GL	KD	DF	FT	DRL MEASURED FROM LOG PERM. DATUM	N/A	N/A	N/A	N/A	DATE DEPTH DRILLER	95/04/16	12.57	FT	FT	DEPTH LOGGER					FIRST READING					BIT SIZE		4			CASING - DRILLER		78	FT	FT	CASING - LOGGER		2.0	IN	IN	CASING THICKNESS					CASING TYPE		PVC			FLUID TYPE		DRILL M	LB/GAL		FLUID DENSITY		8.3			FLUID VISCOSITY					FLUID PH					MUD SOURCE		N/A			RNF @ MEAS TEMP		N/A @ N/A F			RNF @ MEAS TEMP		@ F			RNC @ MEAS TEMP		N/A @ F			CIRC STOPPED		N/A			RECORDED BY	R HECK				REMARKS 1	9510.9068				REMARKS 2	LOG MEASURED -36.25 INCHES /-3.02 FT TOP OF CASING				REMARKS 3	ALL SERVICES PROVIDED SUBJECT TO STANDARD TERMS AND CONDITIONS			
PERMANENT DATUM	Elevations:				Other Services:																																																																																																																					
	GL	KD	DF	FT																																																																																																																						
DRL MEASURED FROM LOG PERM. DATUM	N/A	N/A	N/A	N/A																																																																																																																						
DATE DEPTH DRILLER	95/04/16	12.57	FT	FT																																																																																																																						
DEPTH LOGGER																																																																																																																										
FIRST READING																																																																																																																										
BIT SIZE		4																																																																																																																								
CASING - DRILLER		78	FT	FT																																																																																																																						
CASING - LOGGER		2.0	IN	IN																																																																																																																						
CASING THICKNESS																																																																																																																										
CASING TYPE		PVC																																																																																																																								
FLUID TYPE		DRILL M	LB/GAL																																																																																																																							
FLUID DENSITY		8.3																																																																																																																								
FLUID VISCOSITY																																																																																																																										
FLUID PH																																																																																																																										
MUD SOURCE		N/A																																																																																																																								
RNF @ MEAS TEMP		N/A @ N/A F																																																																																																																								
RNF @ MEAS TEMP		@ F																																																																																																																								
RNC @ MEAS TEMP		N/A @ F																																																																																																																								
CIRC STOPPED		N/A																																																																																																																								
RECORDED BY	R HECK																																																																																																																									
REMARKS 1	9510.9068																																																																																																																									
REMARKS 2	LOG MEASURED -36.25 INCHES /-3.02 FT TOP OF CASING																																																																																																																									
REMARKS 3	ALL SERVICES PROVIDED SUBJECT TO STANDARD TERMS AND CONDITIONS																																																																																																																									

1:120, GAMMA-CONDUCTIVITY-NEUTRON MW-14 05/04/16

LOG PARAMETERS	
MATRIX DENSITY : 2.71	NEUTRON MATRIX : LIMESTONE
MAGNETIC DECL : 40	ELECT. CUTOFF : 99999
MATRIX DELTA T : 49	
BIT SIZE : 4 IN	
PRESENTATION NAME/DATE: 9512 - Slim Hole Induction - Conduction - Neutron - NEUDISPLAY7_JL38/2016	

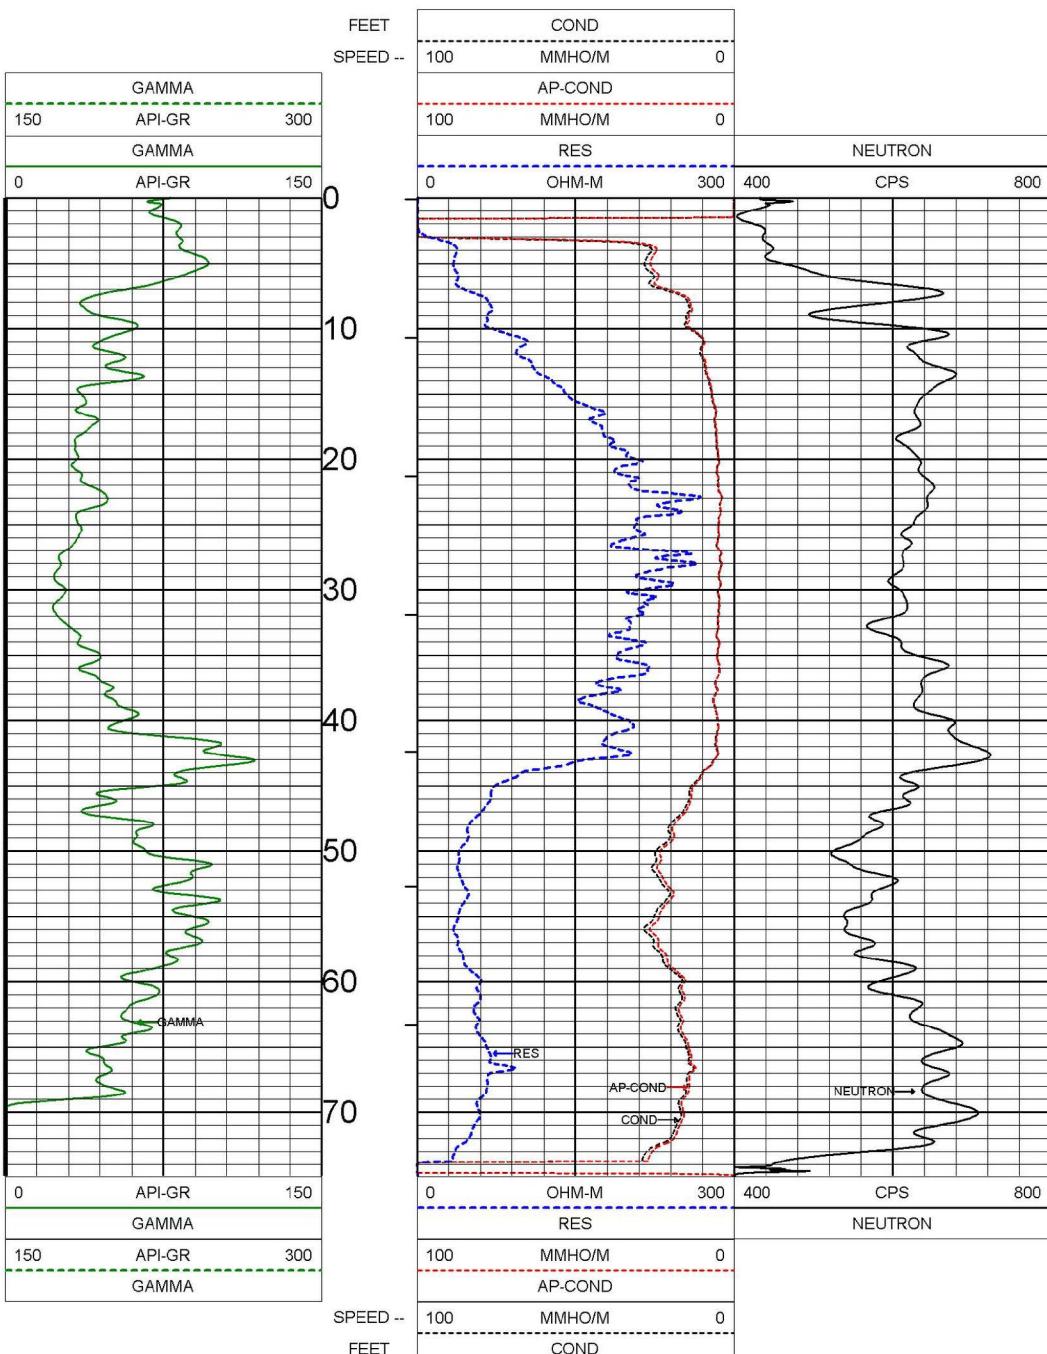

1:120, GAMMA-CONDUCTIVITY-NEUTRON MW-14 05/04/16

LOG PARAMETERS	
MATRIX DENSITY : 2.71	NEUTRON MATRIX : LIMESTONE
MAGNETIC DECL : 40	ELECT. CUTOFF : 99999
MATRIX DELTA T : 49	
BIT SIZE : 4 IN	
PRESENTATION NAME/DATE: 9512 - Slim Hole Induction - Conduction - Neutron - NEUDISPLAY7_JL38/2016	


TOOL CALIBRATION MW-14 05/04/16 12:57			STANDARD		RESPONSE [CPS]	
DATE	TIME	SENSOR	Point1	Point2	Point1	Point2
1 Nov13,13	15:12:07	GAMMA	[API-GR]	1.000	340.000	0.000
2 May04,16	12:57:22	AP-COND	[MMHO/M]	0.000	690.000	52789
3 Sep25,14	13:19:22	TEMP	[DEG-F]	39.500	132.600	26556
4 Sep25,14	13:26:21	A	[]	0.350	0.000	31296
5 Mar27,03	10:28:37	B	[CPS]	Default	Default	

TOOL CALIBRATION MW-14 Mar27,03 10:28:37			STANDARD		RESPONSE [CPS]	
DATE	TIME	SENSOR	Point1	Point2	Point1	Point2
1 Apr28,16	10:26:20	NEUTRON	[UNKNOWN]	1.000	0.000	

 GAMMA-CONDUCTIVITY-NEUTRON MW-16		AMERICAN ELECTRIC POWER	
		COMPANY : AMERICAN ELECTRIC POWER	WELL : MW-16
		WELL EXT	
		FIELD : NA	
		COUNTY : ROGERS	
		STATE : OKLAHOMA	
		COUNTRY : USA	
		API NO. : N/A	
		UNIQ ID : N/A	
		LOCATION : N/A	
		LATITUDE : N/A	
		LONGITUDE : N/A	
		SECTION: N/A TOWNSHIP: N/A RANGE: N/A	
DISPLAY7_JL38			
PERMANENT DATUM		Elevations:	
DRL MEASURED FROM		N/A	FT
LOG MEASURED FROM		N/A	GL
ELEV. PERM. DATUM		N/A	FT
DATE		05/04/16 14:01	
DEPTH DRILLER		75 FT	
DEPTH LOGGER		FT	
FIRST READING		FT	
BIT SIZE		4 IN	
CASING -- DRILLER		75 FT	
CASING -- LOGGER		2.0 IN	
CASING O.D.		N/A	
CASING THICKNESS		N/A	
CASING TYPE		PCIC	
FLUID TYPE		DRILL M LB/GAL	
FLUID DENSITY		8.3	
FLUID VISCOSITY			
FLUID PH			
MUD SOURCE		N/A	
RM @ MEAS TEMP		N/A @ N/A F	
RWF @ MEAS TEMP		@ F	
RWC @ MEAS TEMP		N/A @ F	
CIRC STOPPED		N/A	
RECORDED BY		R HECK	
REMARKS 1		9510.9068	
REMARKS 2		LOG MEASURED -35.00 INCHES +/- 9.2 FT TOP OF GAGING	
REMARKS 3		ALL SERVICES PROVIDED SUBJECT TO STANDARD TERMS AND CONDITIONS	

1:120, GAMMA-CONDUCTIVITY-NEUTRON MW-16 05/04/16

MATRIX DENSITY : 2.71	NEUTRON MATRIX : LIMESTONE	MATRIX DELTA T : 49
MAGNETIC DECL : 40	ELECT. CUTOFF : 99999	BIT SIZE : 4 IN
PRESENTATION NAME/DATE: 9512 - Slim Hole Induction - Conduction - Neutron - NEUDISPLAY7_JL38/2016		

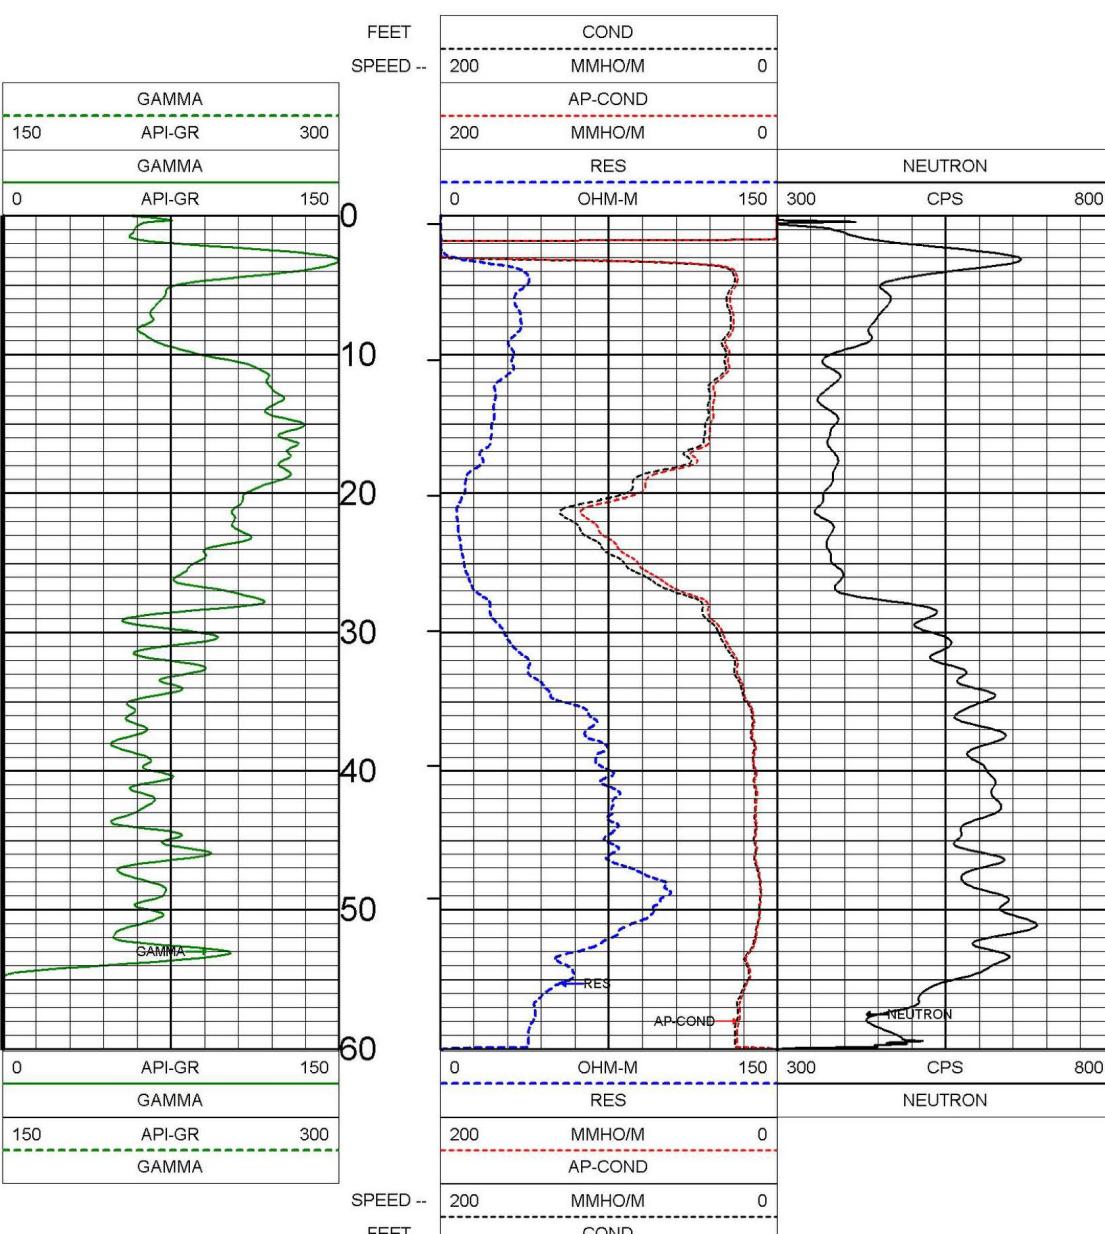

1:120, GAMMA-CONDUCTIVITY-NEUTRON MW-16 05/04/16

MATRIX DENSITY : 2.71	NEUTRON MATRIX : LIMESTONE	MATRIX DELTA T : 49
MAGNETIC DECL : 40	ELECT. CUTOFF : 99999	BIT SIZE : 4 IN
PRESENTATION NAME/DATE: 9512 - Slim Hole Induction - Conduction - Neutron - NEUDISPLAY7_JL38/2016		

TOOL CALIBRATION MW-16 05/04/16 14:01			STANDARD		RESPONSE [CPS]	
DATE	TIME	SENSOR	Point1	Point2	Point1	Point2
1 Nov13,13	15:12:07	GAMMA [API-GR]	1.000	340.000	0.000	335
2 May04,16	17:47:50	AP-COND [MMHO/M]	0.000	690.000	52809	88982
3 Sep25,14	13:19:22	TEMP [DEG-F]	39.500	132.600	26556	31296
4 Sep25,14	13:26:21	A []	0.350		0.000	
5 Mar27,03	10:28:37	B [CPS]	Default		Default	

TOOL CALIBRATION MW-16 Mar27,03 10:28:37			STANDARD		RESPONSE [CPS]	
DATE	TIME	SENSOR	Point1	Point2	Point1	Point2
1 Apr28,16	10:26:20	NEUTRON [UNKNOW]	1.000		0.000	